


Furness Writing No.  
No. 222.



Profile,


W. Hpl. Report No. 9797  
D<sup>o</sup>. D<sup>o</sup>. 9824

W. Hpl. Report No. 9914.  
D<sup>o</sup>. 1<sup>st</sup> butty D<sup>o</sup>. 9962.

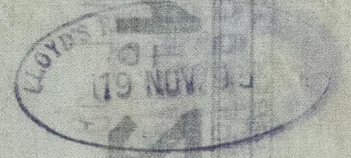

YURNESS  
S  
S  
S

17.10.22  
22.11.22

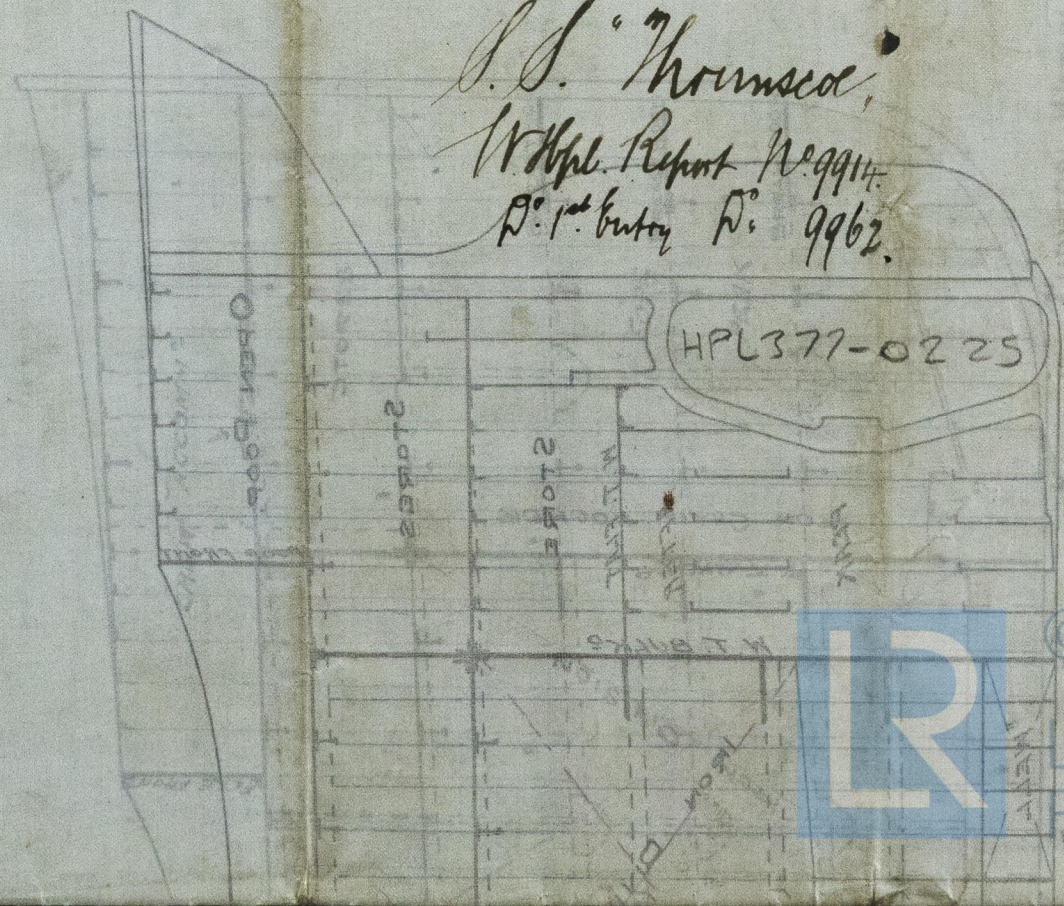

© 2020

Lloyd's Register  
Foundation






# PROFILE.

FRAMES OF BULB ANGLE SECTION CARRIED UP IN ONE LENGTH FROM TANK SIDE TO BRIDGE DECK.

FRAMES OF BULB ANGLE SECTION CARRIED UP IN ONE LENGTH FROM TANK SIDE TO SPAR DECK.

14.10.95  
22.11.95

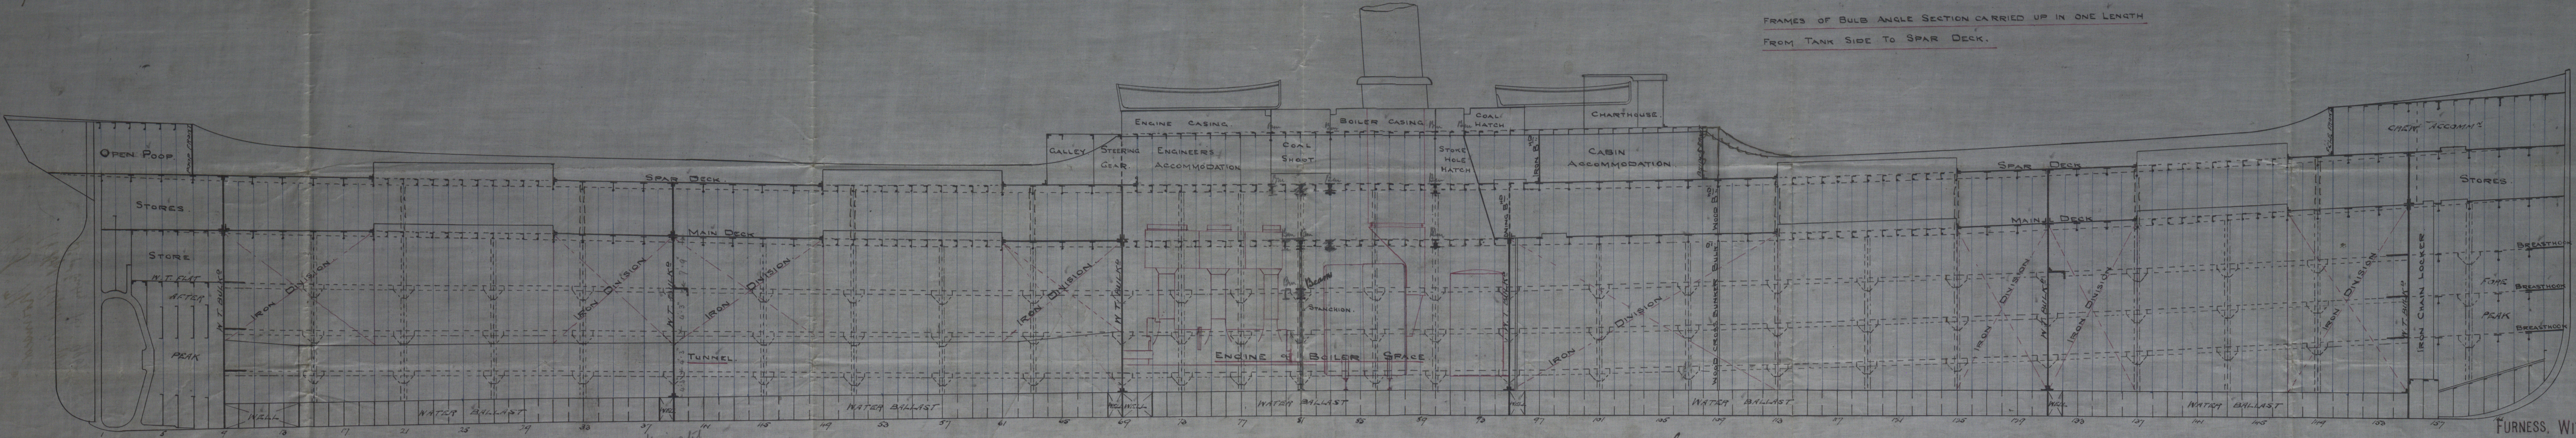

N<sup>o</sup> 222

Horizontal  
stiffeners will  
be placed on this bulkhead.

SCALE 1/4" TO ONE FOOT

J.P.L.  
17/10/95

FURNESS, WITBY & CO., LIMITED  
SHIPBUILDERS & REPAIRERS.  
WEST HARTLEPOOL.  
3<sup>RD</sup> OCTOBER 1895.

