

H.P. "Leomis"

Received at WEST HARTLEPOOL Office.

13.6.1906

Lloyd's Register of British and Foreign Shipping.

(Report on Vessel No. 10,034 Port WEST HARTLEPOOL.)

No pool

No. 3249A.

SHIP FORGINGS OR CASTINGS.

I have to report that the undermentioned Iron or Steel Forgings or Castings,
manufactured by M^r. H. Gray & Co.

of Warrlepool for the Vessel No. 225, being built

by M^r. Furness Withy & Co. of Warrlepool

have been inspected by me as set forth below, and found to be, so far as can be seen,

sound

The words FORGINGS or CASTINGS, IRON or STEEL, should be struck out as may be required.

Mark on Forgings.

Lloyd's

No 3249A

No. 6.


Hugh Cameron

Sunderland


12.6.96

	STERN FRAME.	RUDDER FRAME.	STEM.
Material*	Scrap iron	Scrap iron	Scrap iron
How made	Forged	Forged	Forged
Dimensions	10' x 6"	7 3/4 - 3 3/4	10' x 2 5/8
Progress on Inspection	Forged & Smithed	Forged & Smithed	Forged
Date when Inspected	March 3 rd to 16/96	April 8 th to May 21/96	April 13/96

SKETCHES OF FRAMES SHOWING POSITION AND DESCRIPTION OF WELDS OF FORGINGS, OR PARTICULARS OF TESTS APPLIED TO CASTINGS.

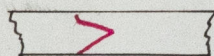

Welds

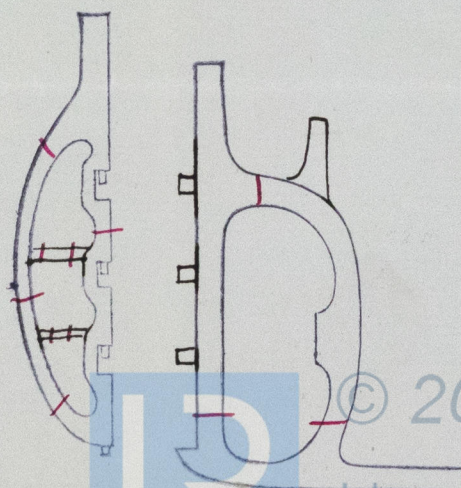

Fee (if any chargeable) £ : :

To be paid at