


24.1.96
30.3.96
15.4.96

PROFILE.

SCALE $\frac{1}{8}$ = 1 FOOT.

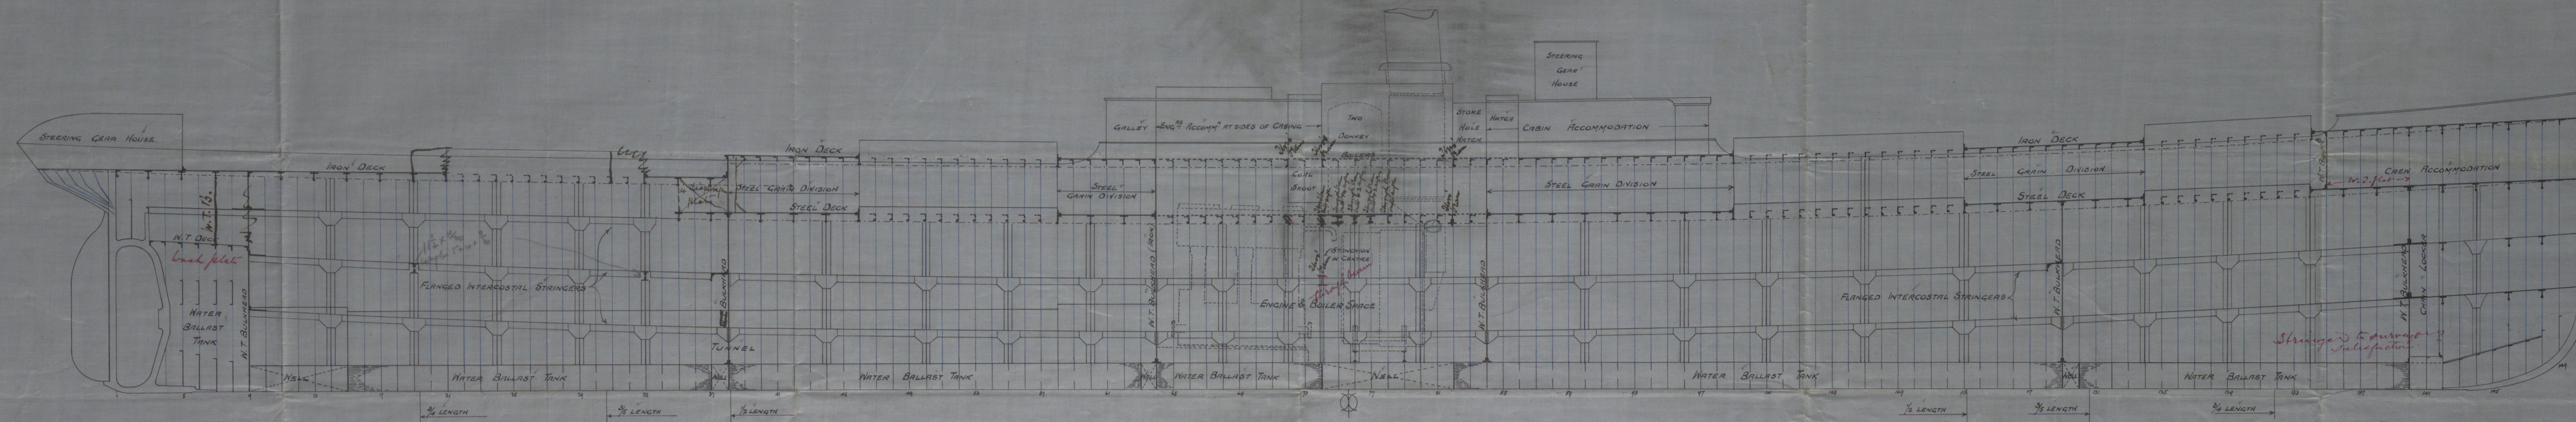

N^o 225.

FURNESS, WITBY & CO. LIMITED.
SHIPBUILDERS & REPAIRERS
WEST HARTLEPOOL.
TRADE MARK N^o 18304.
JAN. 17. 1896.



© 2020
Lloyd's Register
Foundation

HR378-0080

Furness Withy & Co.

No. 225.

Profile.

S.S. Leonis



W. Appl. Report No. 10010.

N^o.

N^o.

10,034.

HR378-0080

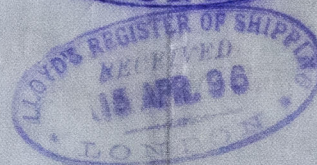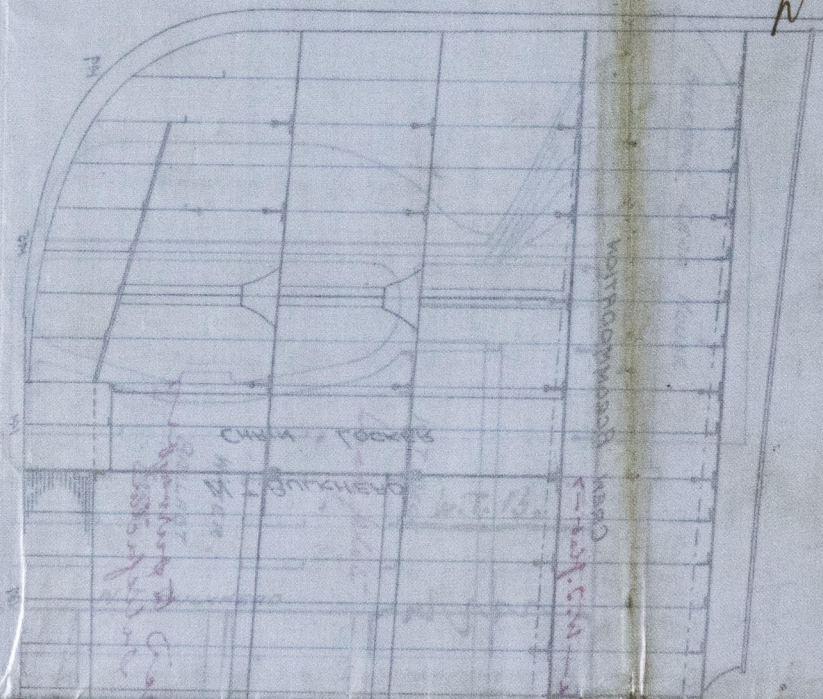

© 2020

Lloyd's Register
Foundation