


PUMPING ARRANGEMENT

SCALE 1" = 1 FOOT

ESTIMATED TONNAGE UNDER DECK UNDER 3,000

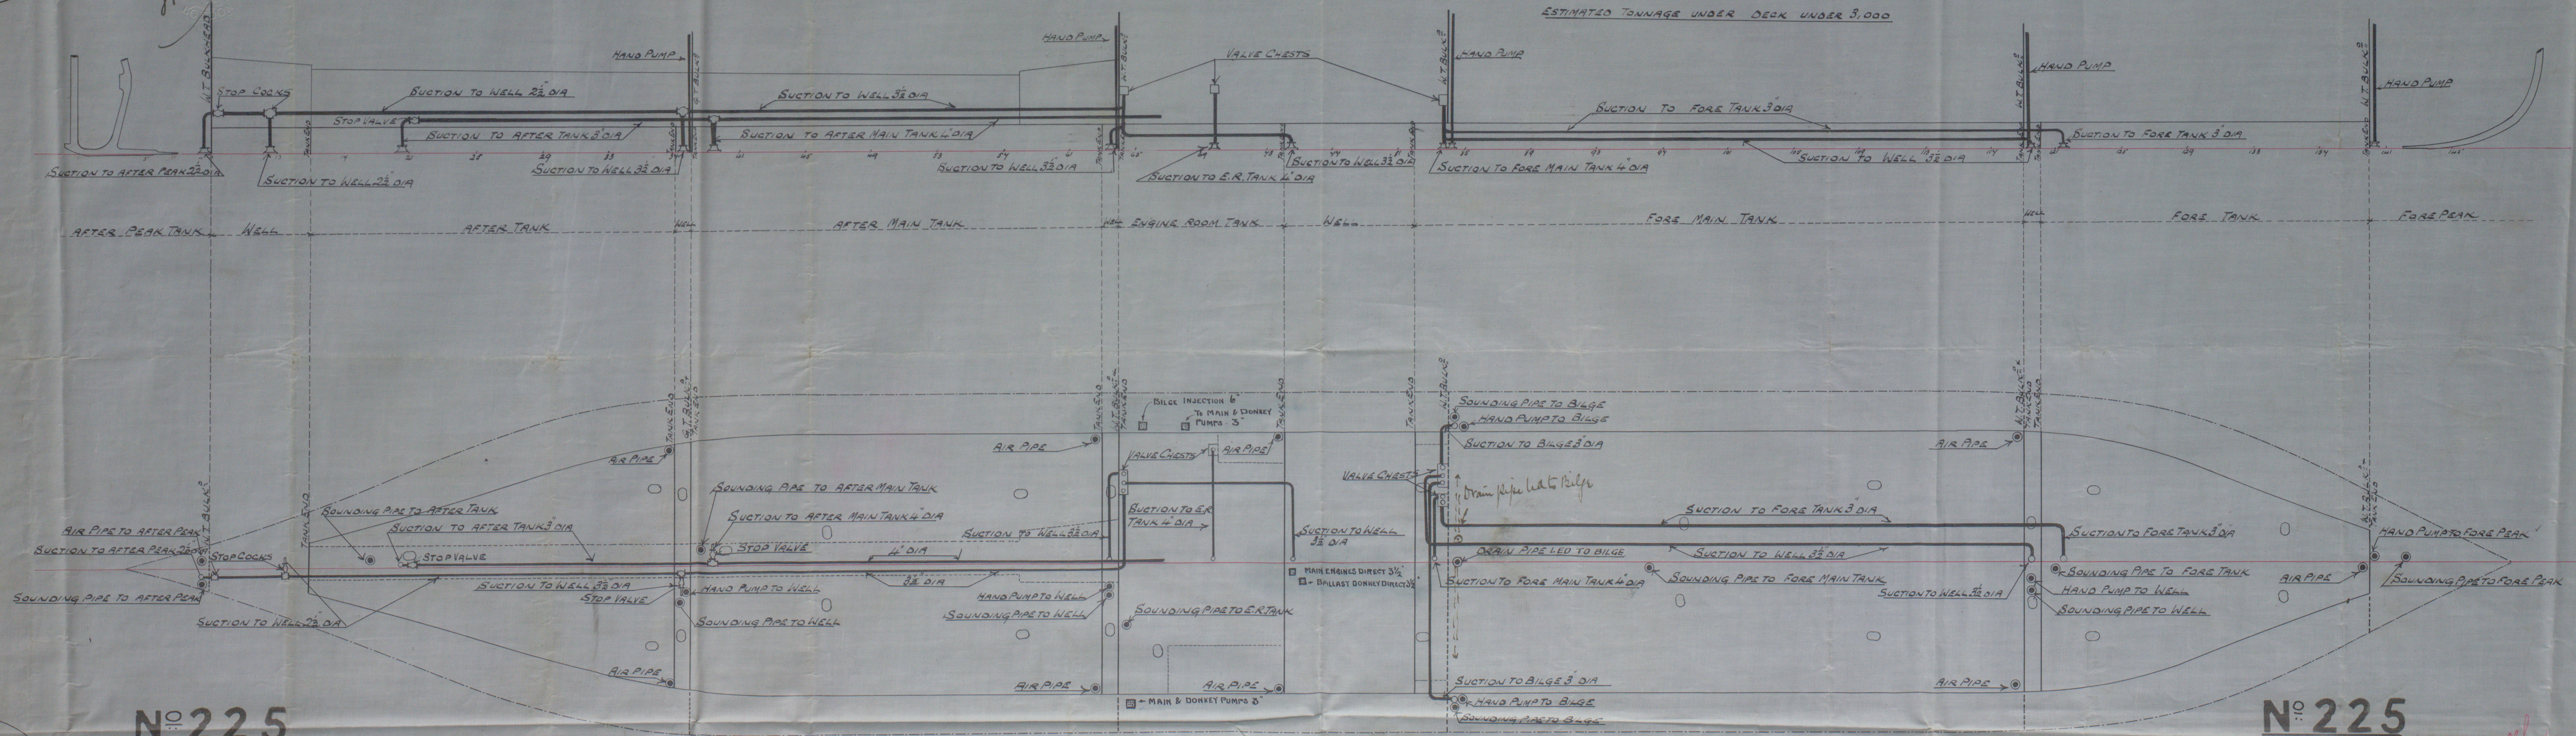

N^o 225

N^o 225

FURNESS, WITBY & CO. LIMITED,
SHIPBUILDERS & REPAIRERS,
WEST HARTLEPOOL.

TRADING UP 13500
APRIL 25th 90



© 2020

Lloyd's Register
First published 1837

