

Steel 951 Order.
 SKETCH OF ~~IRON~~ LOWER MASTS N° 2259/S (Vermes, Withy, 16.0.20)

Scale $\frac{1}{4}$ = 1 foot

2/20


Masts to be made in 2 plates in the round, outside strake on fore side, butts to be riveted with straps $\frac{1}{2}$ thicker than plates seams single riveted & Rivets spaced 5 diameters

Masts to carry fore & aft sail only

To pass Lloyd's Survey

FOREMAST

MAINMAST

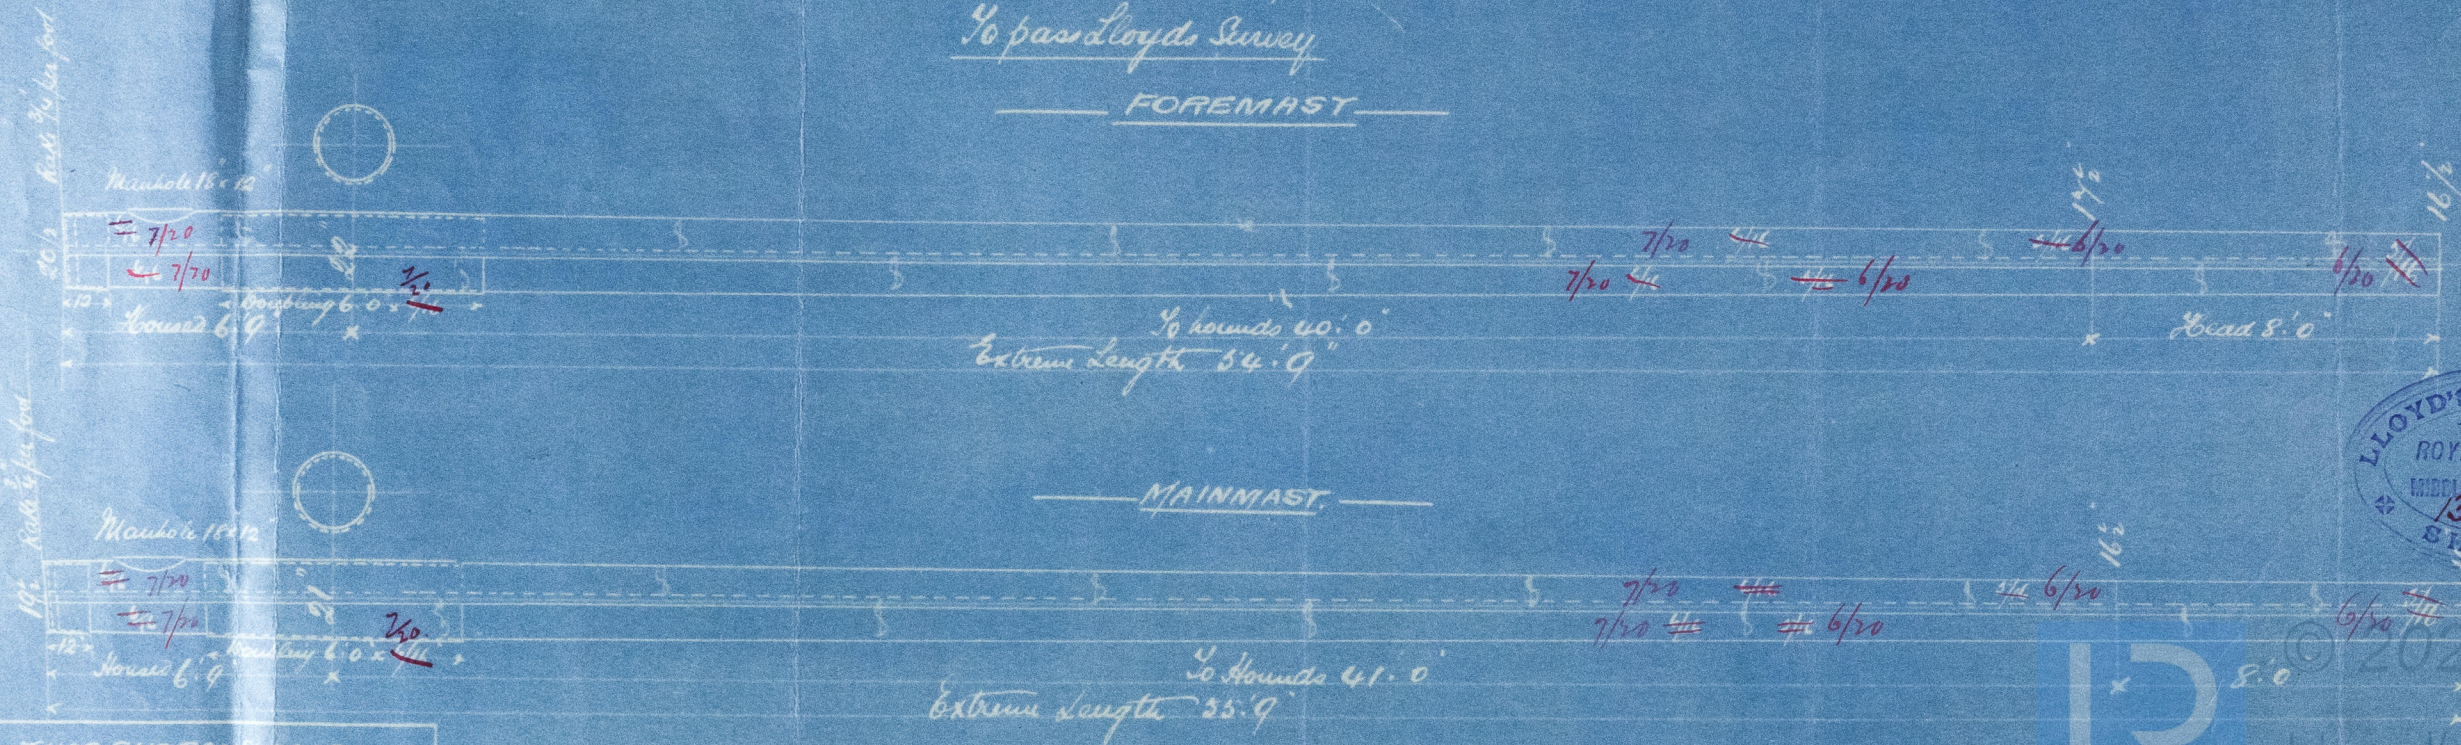

THOS SUDRON & CO
 STOCKTON-ON-TEES



Master-Plan
Turness Withy Rec
No 225

J.D. 'Leonis',
W. Hpl. Report No 10034.

HPL378-0083



© 2020

Lloyd's Register
Foundation