


26.2.96
26.3.96

PROFILE.

FRAMES OF BULB ANGLE SECTION CARRIED UP IN ONE LENGTH FROM TANK SIDE.

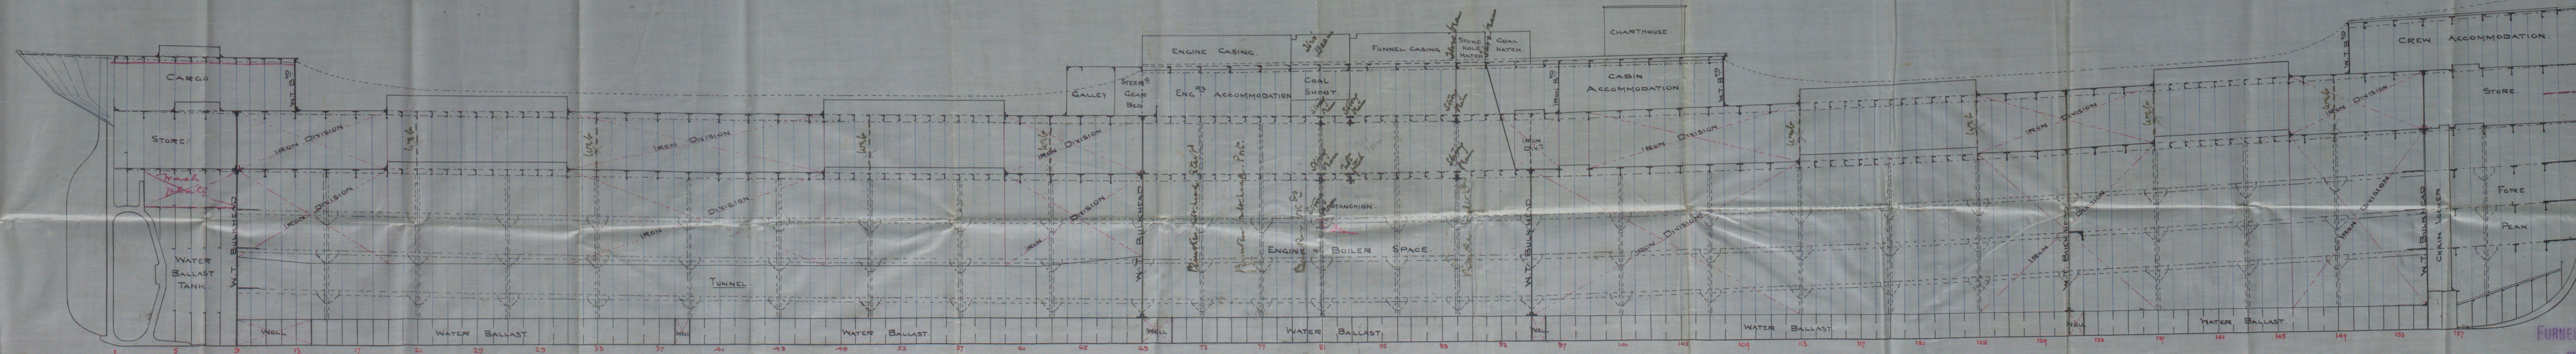

N 226

SCALE 1/8" = ONE FOOT.

26/2/96

FURNESS, WITBY & CO. LIMITED.
SHIPBUILDERS & REPAIRERS.
WEST HARTLEPOOL.
13TH FEBRUARY 1896.

Furness & Co.

No. 226

Profile.

W. Hpl. Report No. 9905.

~~No. 9910~~

U.S. Commonwealth

W. Hpl. Report No. 10035.

No. 10063.

HPL378-0103

© 2020

Lloyd's Register
Foundation