

Lloyd's Register of British and Foreign Shipping.

(Report on Vessel No. 10063 Port WEST HARTLEPOOL.)

No. 3269.a. SHIP FORGINGS OR CASTINGS.

I have to report that the undermentioned Iron or Steel Forgings or Castings, manufactured by Messrs Gray & Co. of West Hartlepool for the Vessel No. 226, being built by Messrs Furness & Arthington of West Hartlepool have been inspected by me as set forth below, and found to be, so far as can be seen, sound

Mark on Forgings.

Lloyd's
No. 3269.a
No. 6.

Wough Cameron


Sunderland

17. 8. 96.

	STERN FRAME.	RUDDER FRAME.	STEM.
Material*	Scrap iron	Scrap iron	Scrap iron
How made	Forged	Forged	Forged
Dimensions	11" x 6"	9" - 4 1/2"	10 1/2" x 2 3/4"
Progress on Inspection	Forged & Smithed	Forged & Smithed	Forged
Date when Inspected	April 6 th to 22/96	May 1 st to July 9/96	April 22/96

SKETCHES OF FRAMES SHOWING POSITION AND DESCRIPTION OF WELDS OF FORGINGS, OR PARTICULARS OF TESTS APPLIED TO CASTINGS.

Welds

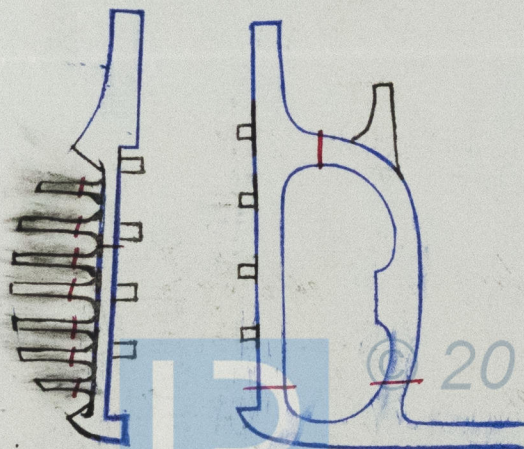

Fee (if any chargeable) £ : :

To be paid at

* If of Iron, state whether scrap or puddled Iron.