

Mass-Plan.
Furness-Withy 1000
Rs 226

U.S. Commonwealth,
W. Hpl. Report No. 10063.

HPL378-0111



© 2019

Lloyd's Register
Foundation

Steel ~~IRON~~-MAST PLAN for MESSRS FURNESS, W

IRON-MAST PLAN for MESSRS FURNESS, WITHEY & CO'S N° 226 S/S

Masts made in two plates in the round, outside struts on fire side. Butts below deck double riv. remainder? 616 riv.


Seams single riveted, rivets $\frac{3}{4}$, 5 diam apart

To pass Lloyds Survey

Masts to carry fore & aft sail only.

Treble twisted butt straps $\frac{2}{10}$ and double
twisted butt straps $\frac{2}{10}$. Much more plates

Foremast.

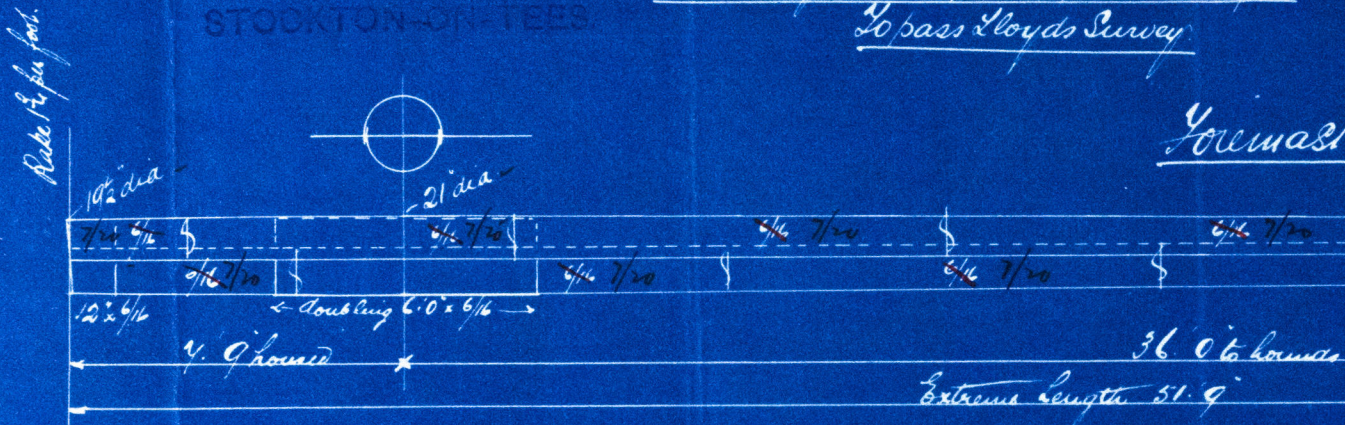




Strengthening rings used: most
3 1/2 x 1."

THE REGION

ROYAL EXCHANGE

14-3-96