


MIDSHIP SECTION.

SCALE $\frac{1}{2}$ " = ONE FOOT.

26.2.96
No. 3.96

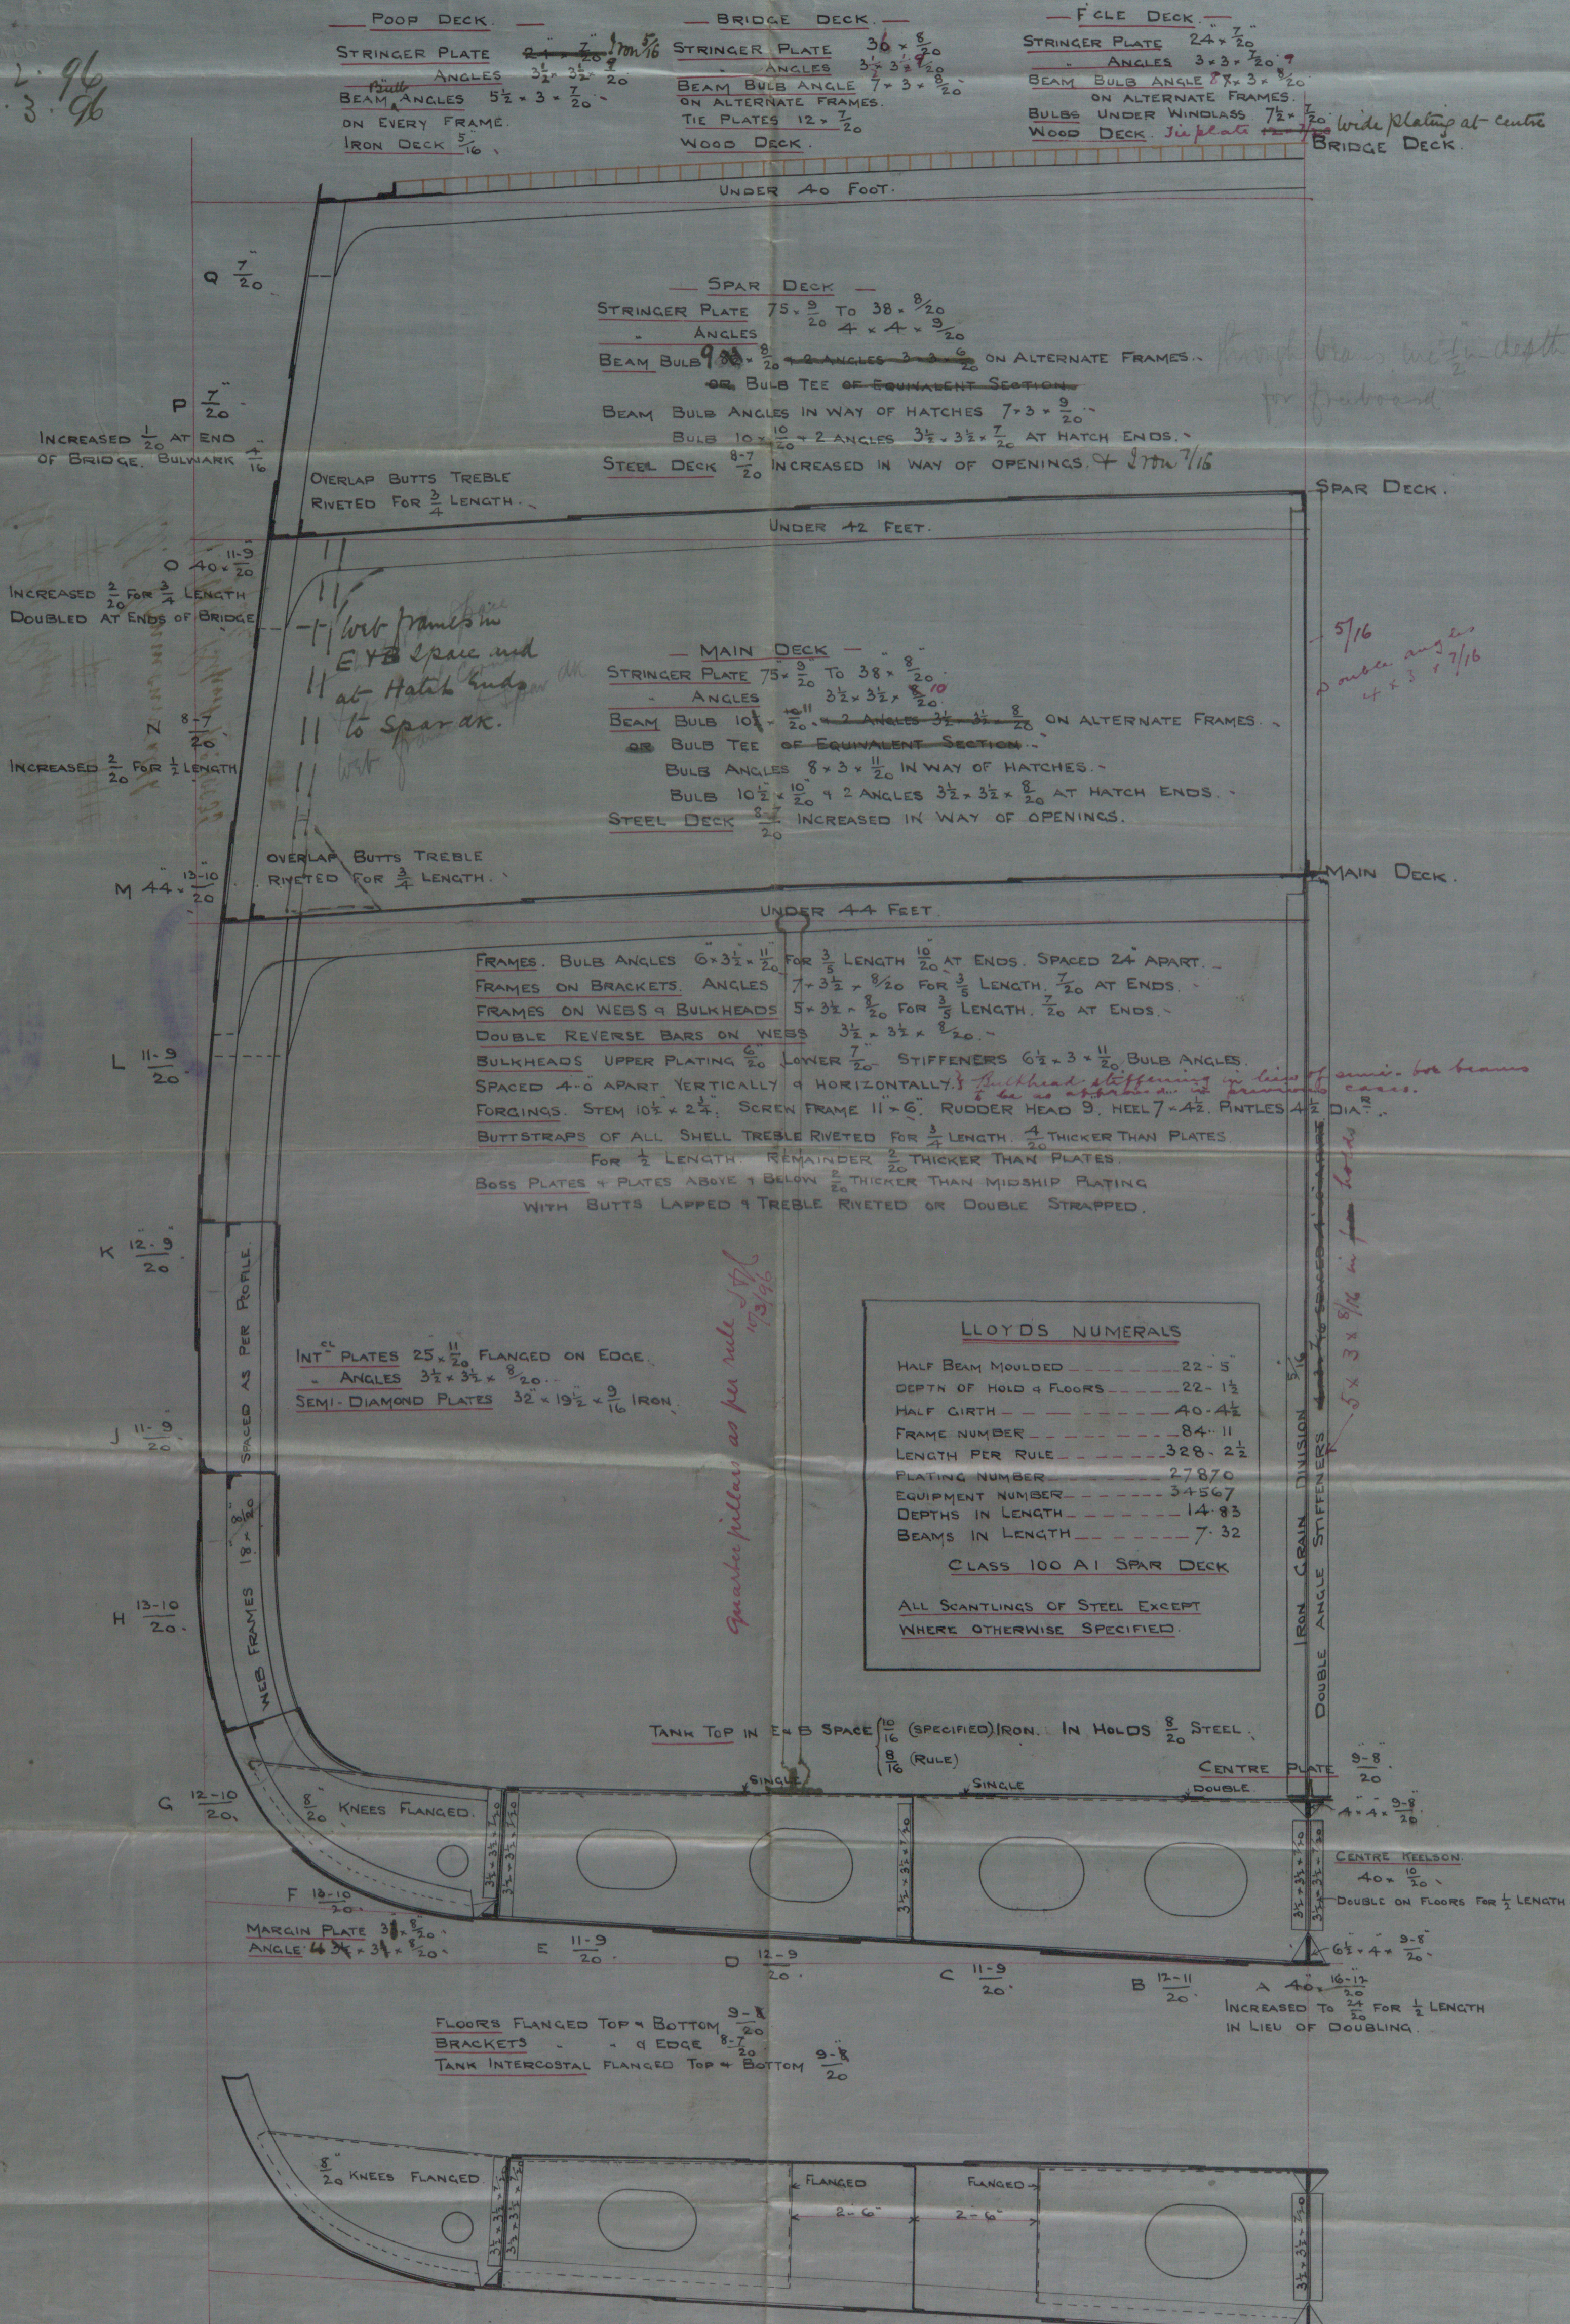

N^o 226.

25/2/96

FURNESS, WITBY & CO. LIMITED,
SHIPBUILDERS & REPAIRERS,
WEST HARTLEPOOL.

17TH FEB. 1896
Lloyd's Register
Foundation

Furness Writing Co.
No. 226.


W. S. Pl. Report No. 9905

~~No. 9910~~

S.S. "Commonwealth,"

W. S. Pl. Report No. 10035

No. 10035

7110-8227AH

R

© 2020

oyos Register
oundation