

S. N. Jonsborg

Received at **WEST HARTLEPOOL** Office,

2. 9. 1896

Lloyd's Register of British and Foreign Shipping.

(Report on Vessel No. *10078* Port **WEST HARTLEPOOL**)

Westpool
No. 5339.a

SHIP FORGINGS OR CASTINGS.

The words FORGINGS or CASTINGS, IRON or STEEL, should be struck out as may be required.

I have to report that the undermentioned Iron or Steel Forgings or Castings, manufactured by *Messrs W & Gray Co.* of *Westpool* for the Vessel No. *525*, being built by *Messrs W & Gray Co.* of *Westpool* have been inspected by me as set forth below, and found to be, so far as can be seen, *Sound*

Mark on Forgings.

Lloyd's

No. *5339.a*
W.C.


Wough Cameron

Sunderland


1-9-96

	STERN FRAME.	RUDDER FRAME.	STEM.
Material*	<i>Scrap iron</i>	<i>Scrap iron</i>	<i>Scrap iron</i>
How made	<i>Forged</i>	<i>Forged</i>	<i>Forged</i>
Dimensions	<i>10' x 5 1/2"</i>	<i>7 3/4' - 3 3/4"</i>	<i>10' x 2 1/2"</i>
Progress on Inspection	<i>Forged & examined</i>	<i>Forged & examined</i>	<i>Forged</i>
Date when Inspected	<i>June 29th to July 16/96</i>	<i>July 23rd to Aug 20/96</i>	<i>July 9/96</i>

SKETCHES OF FRAMES SHOWING POSITION AND DESCRIPTION OF WELDS OF FORGINGS, OR PARTICULARS OF TESTS APPLIED TO CASTINGS.

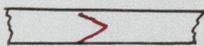

Welds

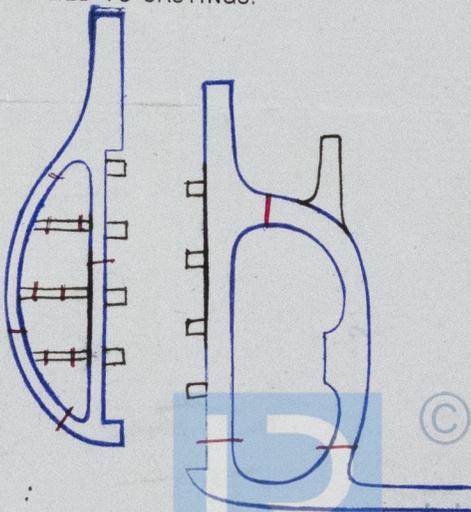

Fee (if any chargeable) £

To be paid at