




S.S. N<sup>o</sup> 525.


8.6.96

Proposed alteration to Side Stringers  
Scale  $\frac{1}{2}$  = 1 Foot.

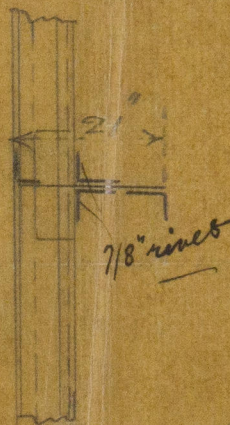

3 bars  $6 \times 4 \times \frac{12}{20}$  to  $\frac{11}{20}$   
in place of 4 bars  
 $6 \times 4 \times \frac{9}{20}$  to  $\frac{8}{20}$

as fitted  
CRB

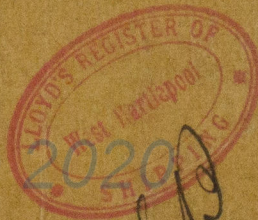

© 2020  
Lloyd's Register  
Foundation  
8/6/96  
8/6/96

11PL378-0122