

S.S. "Barbara"

Received at

WEST HARTLEPOOL

THUR, 18 FEB 1897

Lloyd's Register of British and Foreign Shipping.

Rt pool

(Report on Vessel No. 10769

Port WEST HARTLEPOOL.)

No. 3404.a.

SHIP FORGINGS OR CASTINGS.

I have to report that the undermentioned Iron or Steel Forgings or Castings, manufactured by *Mrs J Richardson Son* of *Warrington* for the Vessel No. 229, being built by *Mrs J Turner & Co* of *Warrington* have been inspected by me as set forth below, and found to be, so far as can be seen, *sound*.

Mark on Forgings.

Lloyd's

No. 3404.a.

Rt. C.



Warrington

Sunderland

31-12-96.

	STERN FRAME.	RUDDER FRAME.	STEM.
Material* ...	<i>Scrap iron</i>	<i>Scrap iron</i>	<i>Scrap iron</i>
How made ...	<i>Forged</i>	<i>Forged</i>	<i>Forged</i>
Dimensions ...	<i>11' x 6 1/2</i>	<i>9' x 4 1/2</i>	<i>11' x 2 3/4</i>
Progress on Inspection	<i>Forged & smithed</i>	<i>Forged & smithed</i>	<i>Forged</i>
Date when Inspected	<i>Augt 14th to 31/96</i>	<i>Nov 2nd to Dec 21/96</i>	<i>Augt 27/96</i>

SKETCHES OF FRAMES SHOWING POSITION AND DESCRIPTION OF WELDS OF FORGINGS, OR PARTICULARS OF TESTS APPLIED TO CASTINGS.

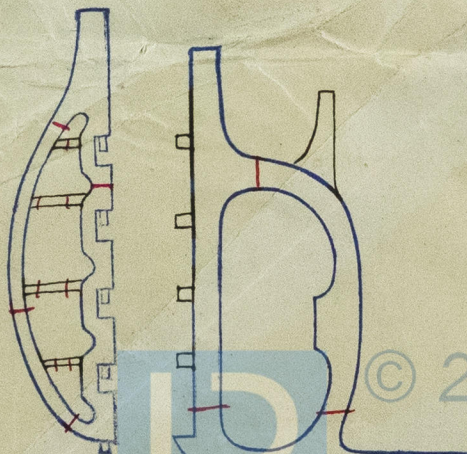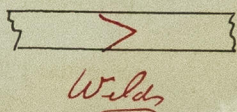

Fee (if any chargeable) £

To be paid at

* If of Iron, state whether scrap or puddled Iron.

HPL 319-0059