

*sketch*  
SKETCH of IRON LOWERMASTS  
 FOR

MESSRS FURNESS, WITHY & CO<sup>S</sup> N<sup>O</sup> ~~1111~~ 229 St. + 230 St.


SCALE 1/4 INCH TO A FOOT

Note! Masts made in 2 plates in the round, butts treble riv with straps 3/32 thicker than plate they connect

Seams single riveted: Rivets 3/4 dia, spaced 3 3/4" apart centres

Masts to carry fore & aft sail only

Masts to pass ~~through~~ Messrs Lloyd's survey.

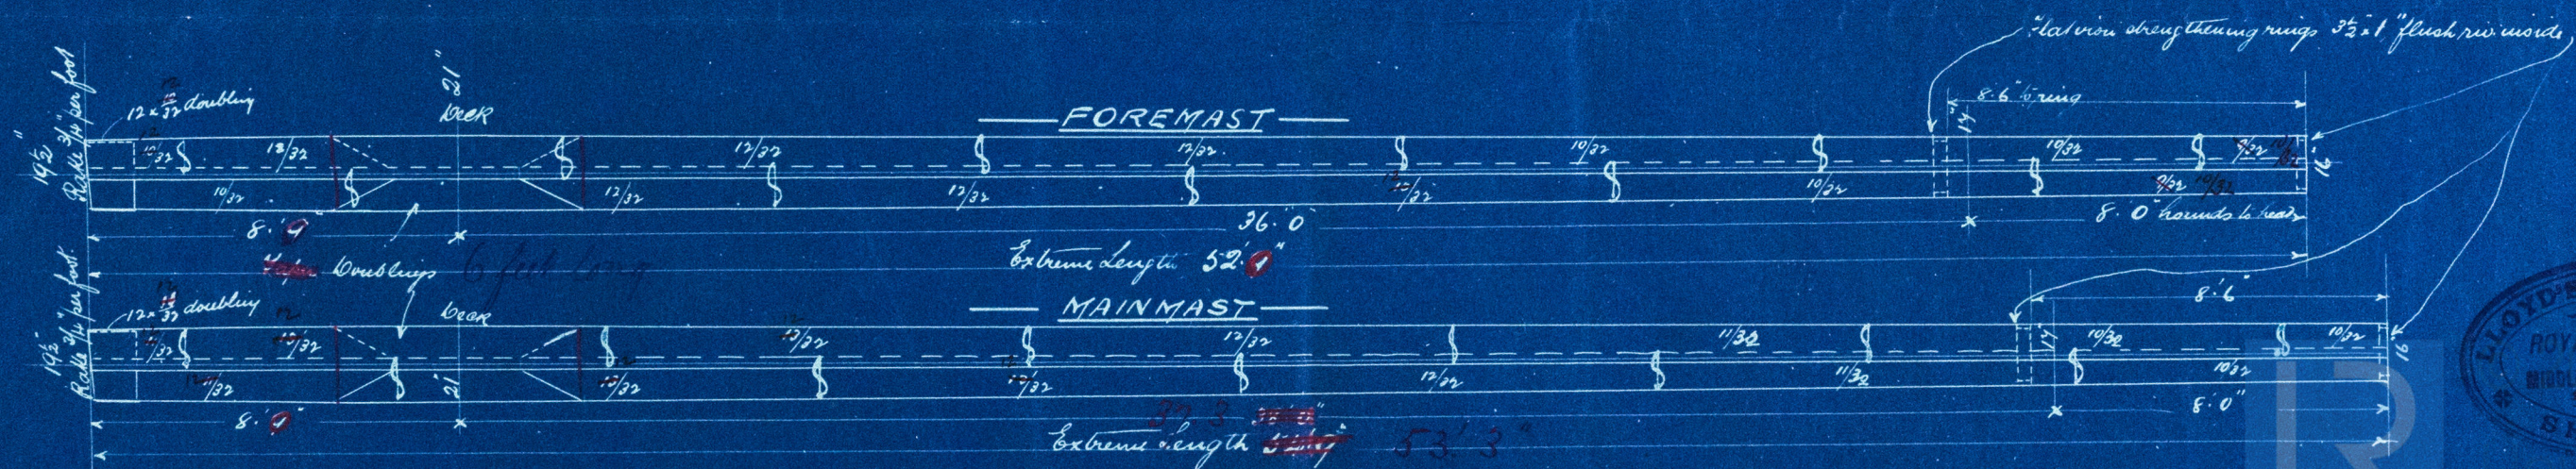



East Plan  
Furness Michy & Co.

Rs 229 + 230

N<sup>o</sup> 229. S.S. 'Barbara',  
W. Wpl. Report N<sup>o</sup> 10169.

N<sup>o</sup> 230. S.S. 'Annie',  
W. Wpl. Report N<sup>o</sup> 10228.

HPL379-0167



© 2021

Lloyd's Register  
Foundation