




CAST STEEL.


QUADRANT

N¹⁰ 230


SCALE $\frac{1}{2} = 1$ FOOT.

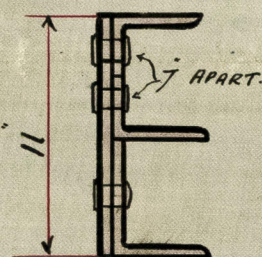


SECTION AT C.D.

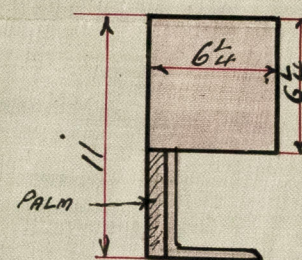

SECTION AT A.B. PORT SIDE

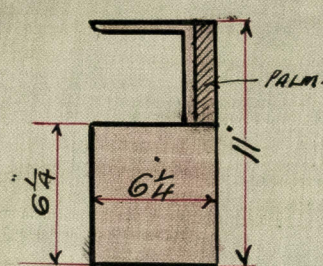

SECTION AT A.B.
STARRD SIDE

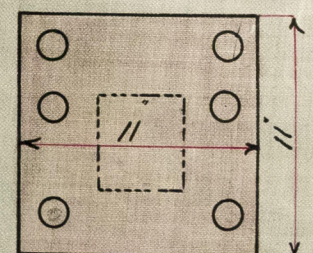

SKETCH OF PALM.

*5/8" plate fitted on Cast Stub
Quadrant to strengthen it, shown in Red.
Plate connected to arms of quadrant
by 7/8" tap bolts, drilled in 1".*




*V.S.M.
22/4/97*

FURNESS, WITBY & CO. LIMITED.
SHIPBUILDERS & REPAIRERS,
WEST HARTLEPOOL.



Annie HPL 10228.

Furness Brothers & Co.
No. 230.
Cast-Steel tiller

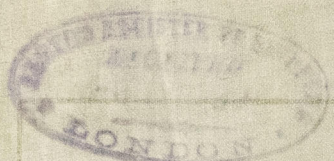

HPL 379-0168

Cast Steel

QUADRANT

















© 2021

Lloyd's Register Foundation