

S.S. "Annie"

Received at WEST HARTLEPOOL office.

3. 2. 97

Lloyd's Register of British and Foreign Shipping.

No. 3405 a (Report on Vessel No. 10728 Port WEST HARTLEPOOL.)

No. 3405 a. SHIP FORGINGS OR CASTINGS.

I have to report that the undermentioned Iron or Steel Forgings or Castings, manufactured by Messrs Richardson Sons of Hartlepool for the Vessel No. 230, being built by Messrs Furness Withy & Co. of Hartlepool have been inspected by me as set forth below, and found to be, so far as can be seen, sound.

The words FORGINGS or CASTINGS, IRON or STEEL, should be struck out as may be required.


Mark on Forgings.

Lloyd's
No. 3405 a
No. 6.

Wm Cameron
Sunderland
2. 2. 97

	STERN FRAME.	RUDDER FRAME.	STEM.
Material*	<i>Scrap iron</i>	<i>Scrap iron</i>	<i>Scrap iron</i>
How made	<i>Forged</i>	<i>Forged</i>	<i>Forged</i>
Dimensions	<i>11 x 6 1/2</i>	<i>9 - 4 1/2</i>	<i>11 x 2 3/4</i>
Progress on Inspection	<i>Forged & smithed</i>	<i>Forged & smithed</i>	<i>Forged</i>
Date when Inspected	<i>Aug 14th to Oct 30/96</i>	<i>Dec 9/96 to Jan 28/97</i>	<i>Oct 28/96</i>

SKETCHES OF FRAMES SHOWING POSITION AND DESCRIPTION OF WELDS OF FORGINGS, OR PARTICULARS OF TESTS APPLIED TO CASTINGS.

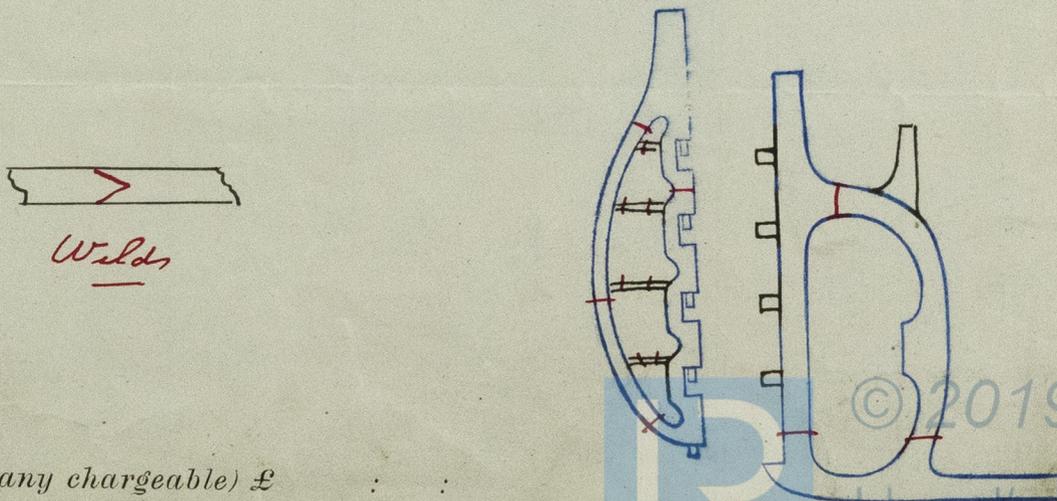

Fee (if any chargeable) £

To be paid at

* If of Iron, state whether scrap or puddled Iron.

© 2019 Lloyd's Register Foundation
HP(379-0171)