



W. W. 29.1.07

No 1109 Multitular Boiler for  
"Winston"  
W. Pressure 100 lb per sq inch  
Sized to Lloyds Requirements  
Scale 1"=1 foot

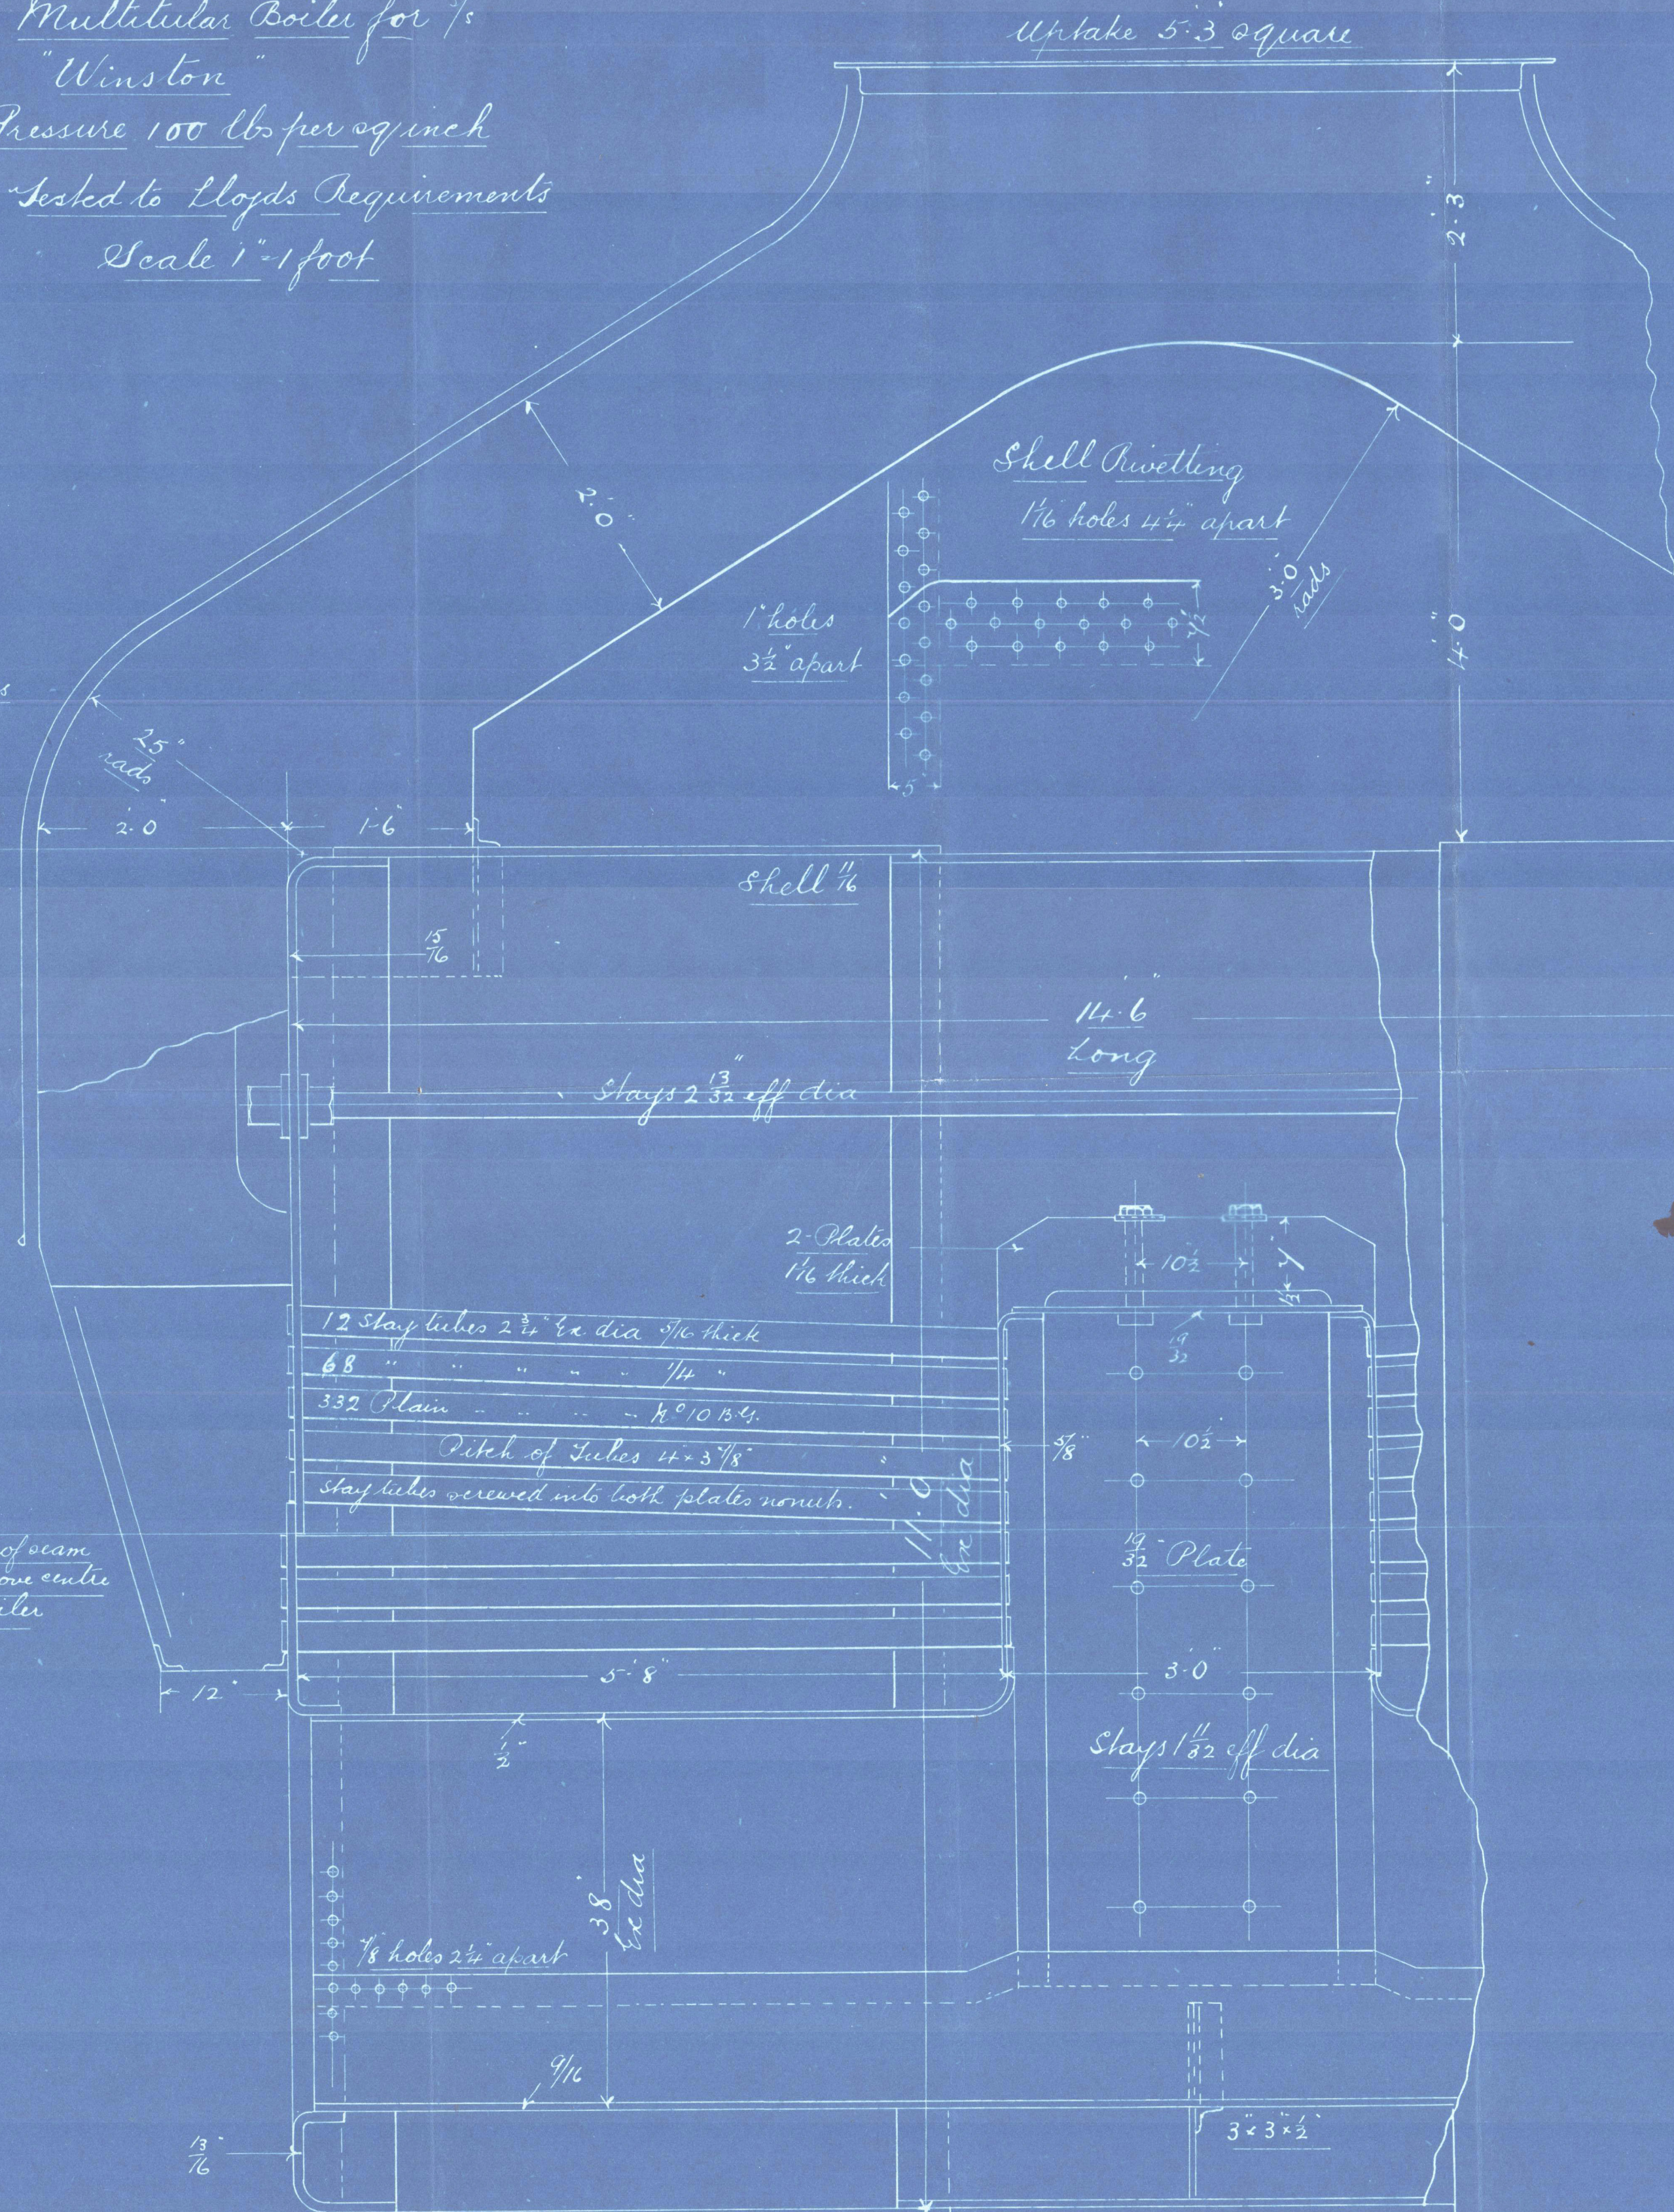

Material  
all plates rivets + stays  
of steel. Tubes of iron

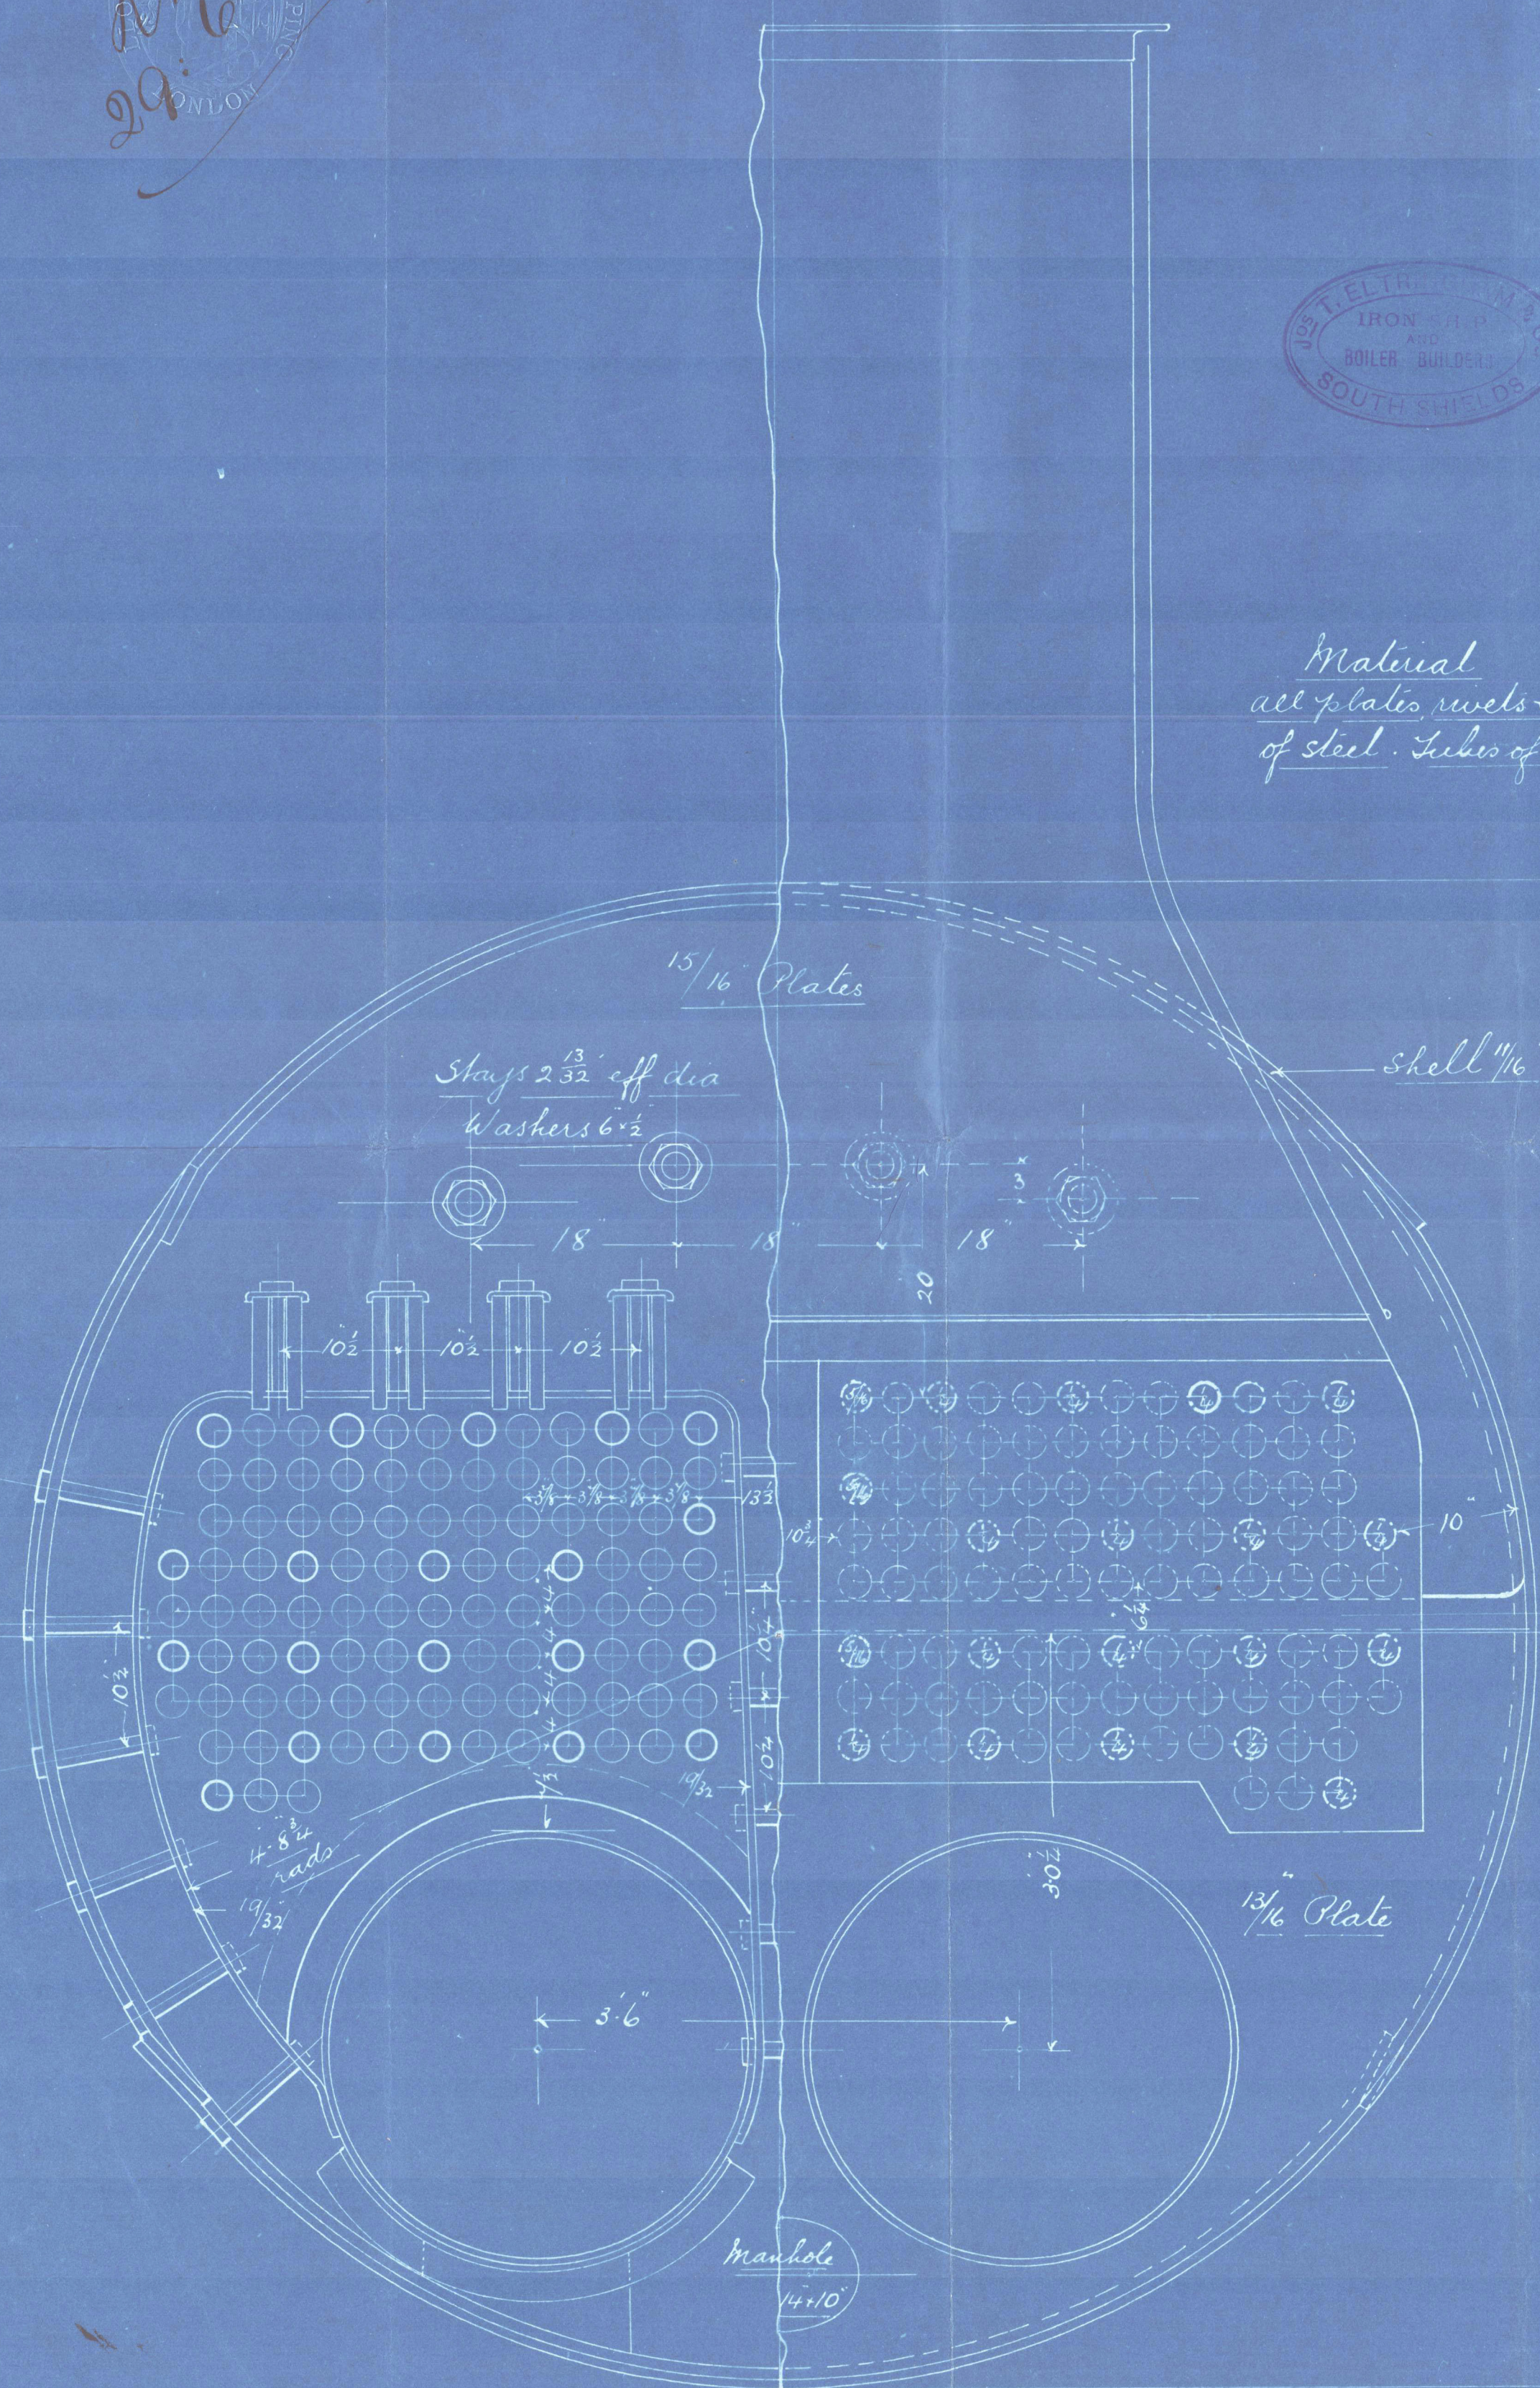

Heating Surface.

|               |            |
|---------------|------------|
| Tubes         | 1648 sq ft |
| Furnaces      | 151        |
| 6. 6 chambers | 84         |
| Tube Plates   | 48         |
| Total         | 1964 sq ft |

29.6.97

See Memo.  
Photo Print.  
with steam Donnell  
additional  
memo  
26/6/97  
© 2020



Newcastle on Tyne  
S. S. "Winston"

No 1109



No 5731  
Clods Lert  
200 lbs  
2 10 97  
CMBD.

New Rpt No 35512  
W. Hpl. Report No 10374.

HPL 380-0170



© 2020

Lloyd's Register  
Foundation