


MIDSHIP SECTION

as amended

SCALE $\frac{1}{2} = 1$ FOOT.

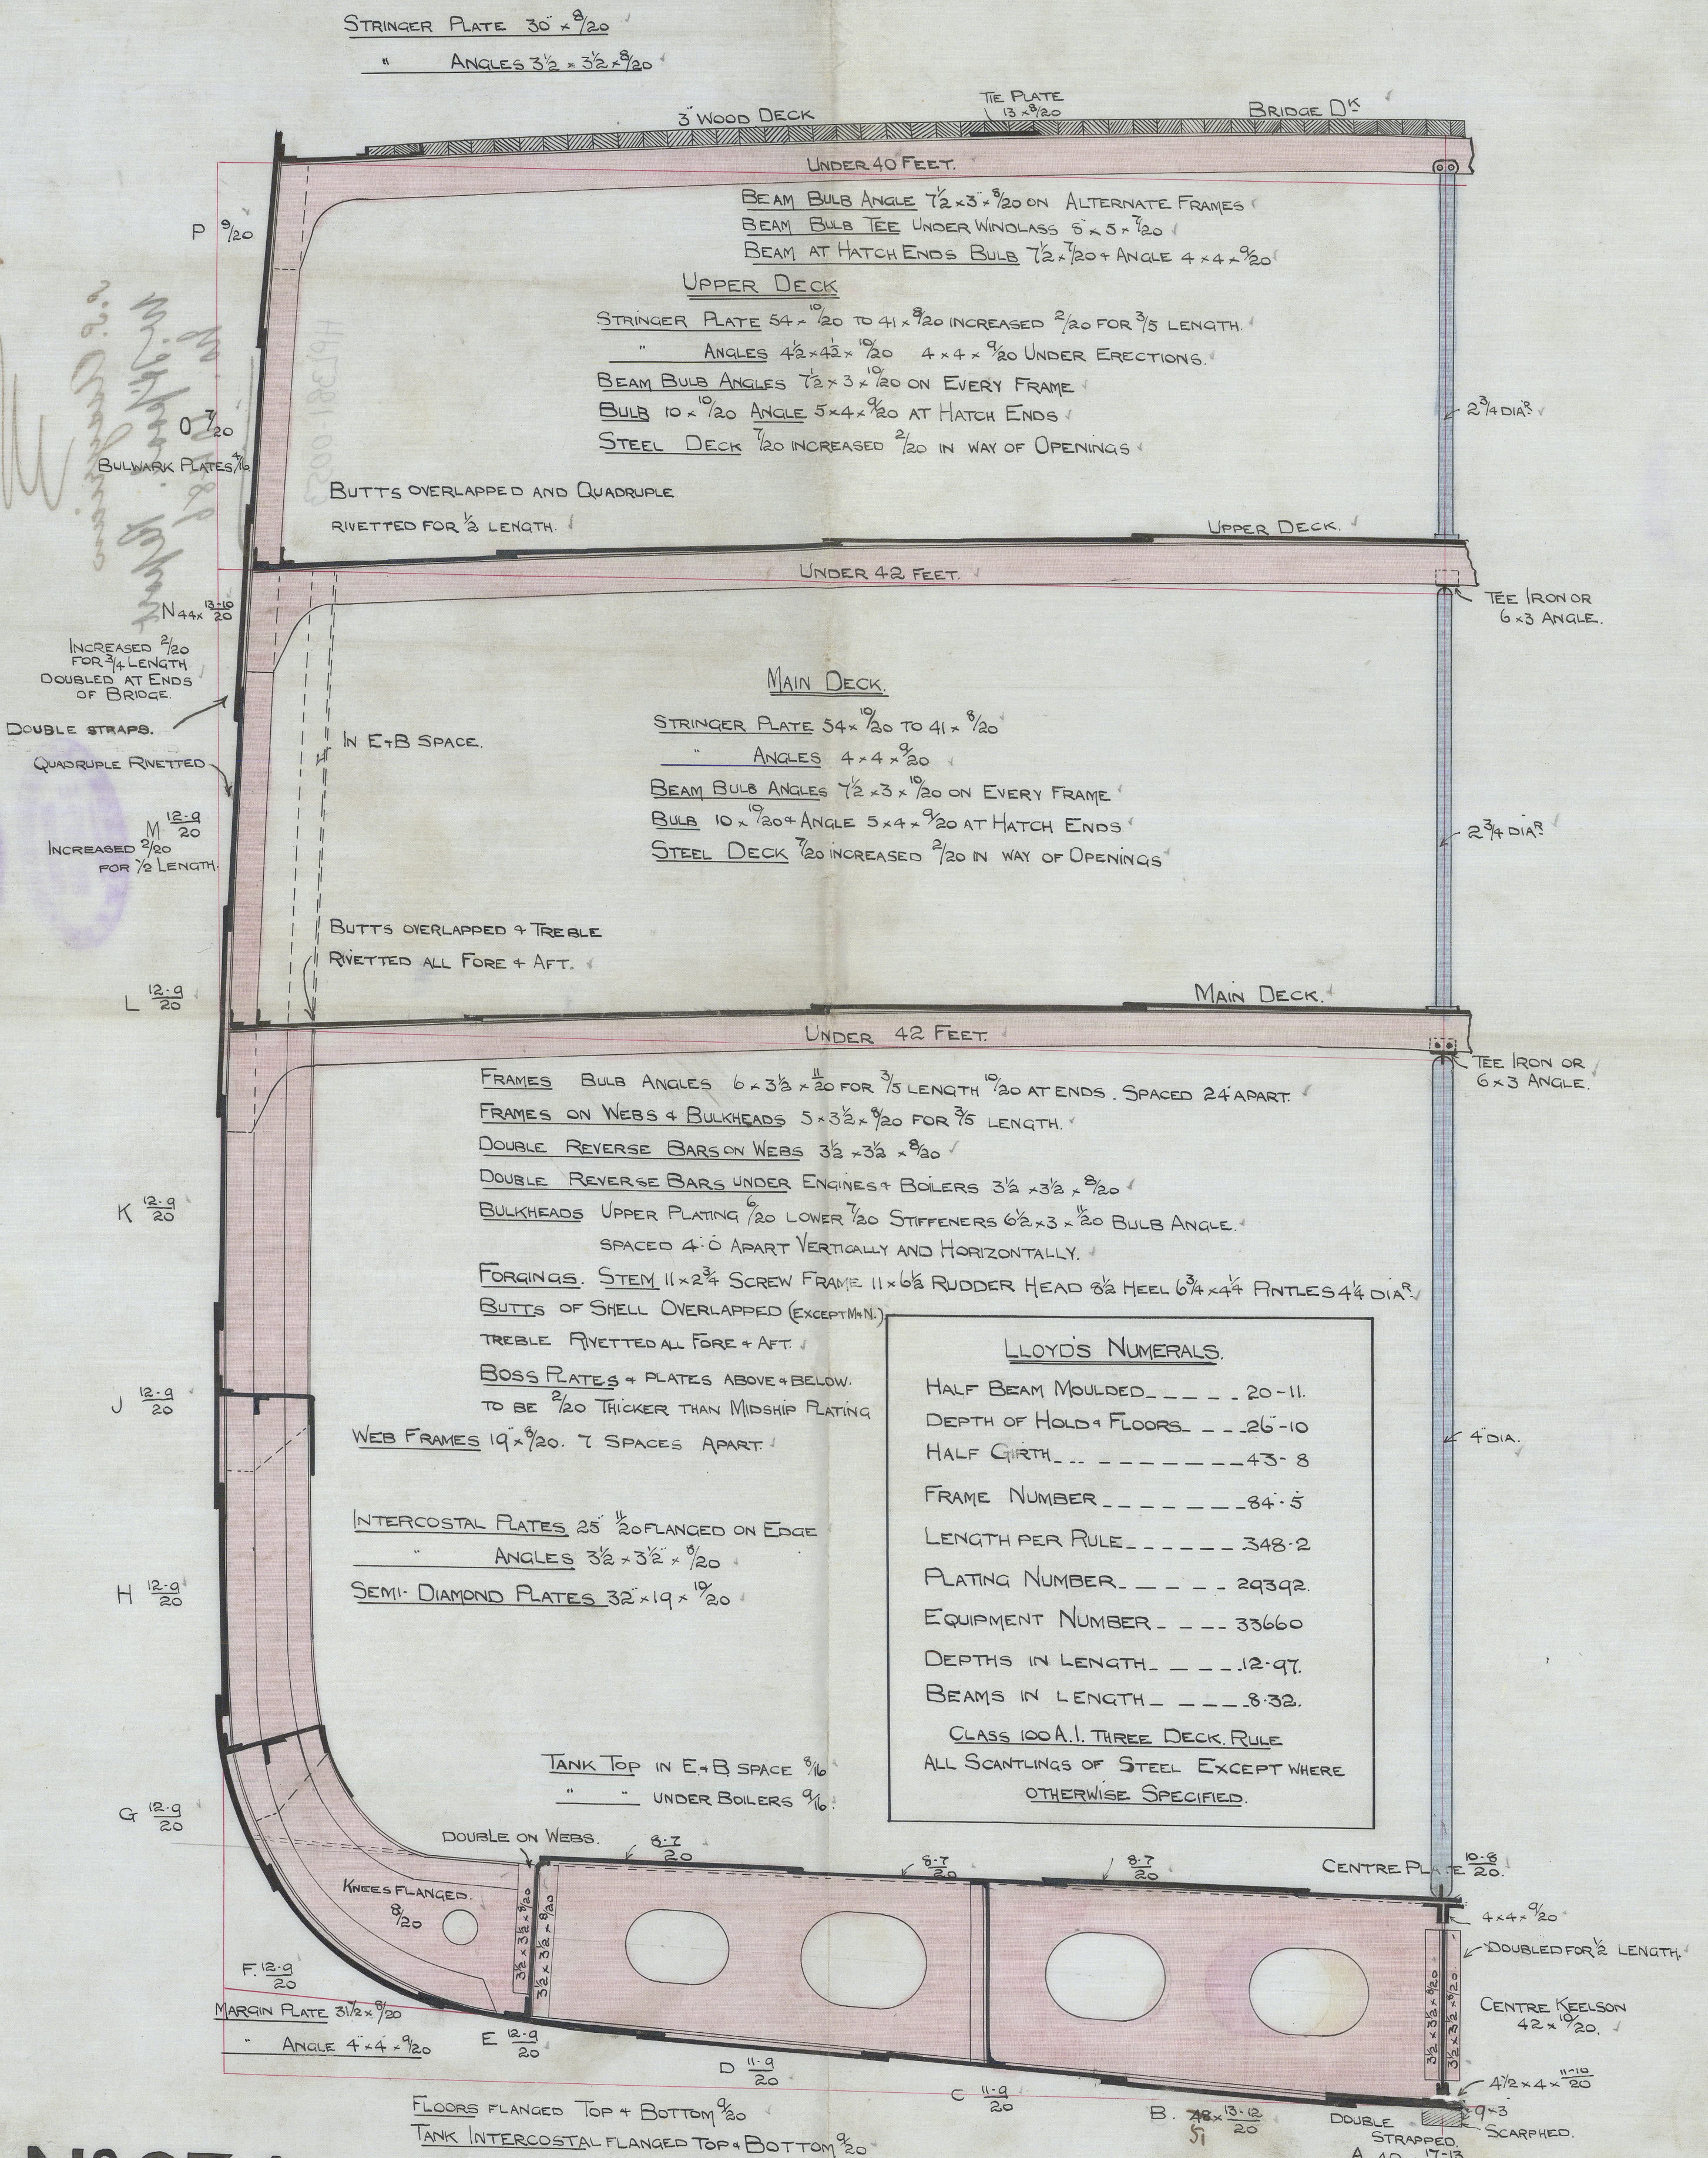

Nº 234

FURNERS, WITBY & CO. LIMITED

SHIPBUILDERS & REPAIRERS

WEST BARTLEPOOL

© 2020

3/9/97. Omb's Register Foundation

HPL381-0053

Furness, Wilby & Co
 No 234.

Amended Mid Sec

S.S. Assyrian
 W. H. Pool. Report
 No. 10486

FOR 1/2 LENGTH
 INCREASED 3/80
 W. 15-8
 DOUBLE RIVETS
 OF BRIDGE
 COVERED AT ENDS
 FOR 3/4 LENGTH
 INCREASED 1/50

RIVETTED ALL FORE + AFT.
 BUTTS OVERLAPPED & RIVETED

11 E-B SPACE

HPL381-0053

RIVETTED FOR 3/4 LENGTH
 BUTTS OVERLAPPED AND GROUNDWIRE

STEEL DECK 150 INCH
 BUT 10 x 10/50 + 1/4
 BEAM BUTS - ANGLES
 11 E-B SPACE
 STRINGER PLATE

STEEL DECK 150 INCH
 BUT 10 x 10/50 Angle 3
 BEAM BUTS ANGLES 15
 ANGLES 45 x 4
 STRINGER PLATE 84 x 10

UPPER DECK

BEAM 11
 BEAM 8
 BEAM 11

2 WOOD DECK

ANGLE 3 3/8 x 3 3/8 x 8/50
 STRINGER PLATE 30 x 8/50

MIDSHIP



Registered
 Foundation