

Master Plan
Furness Withy & Co
Rs 234

es. "Asquith"
W. H. Pool. Report
No. 10486

HPL381-0056



© 2019


Lloyd's Register
Foundation

THOS SUDRON & CO L^d
MAKERS
STOCKTON ON TEES

No 1132
PLAN of STEEL LOWER-MASTS

FOR MESS^{RS} FURNESS, WITHEY & CO^S N^o 234 S/S (Y^e pass Lloyd's survey)

Mast to carry fore & aft sail only: Butts in housing double riv, straps $\frac{1}{2}$ in thicker
Remainder treble riveted with straps $\frac{3}{4}$ in thicker, seams single riveted; $\frac{3}{4}$ in rivs 5 chains apart

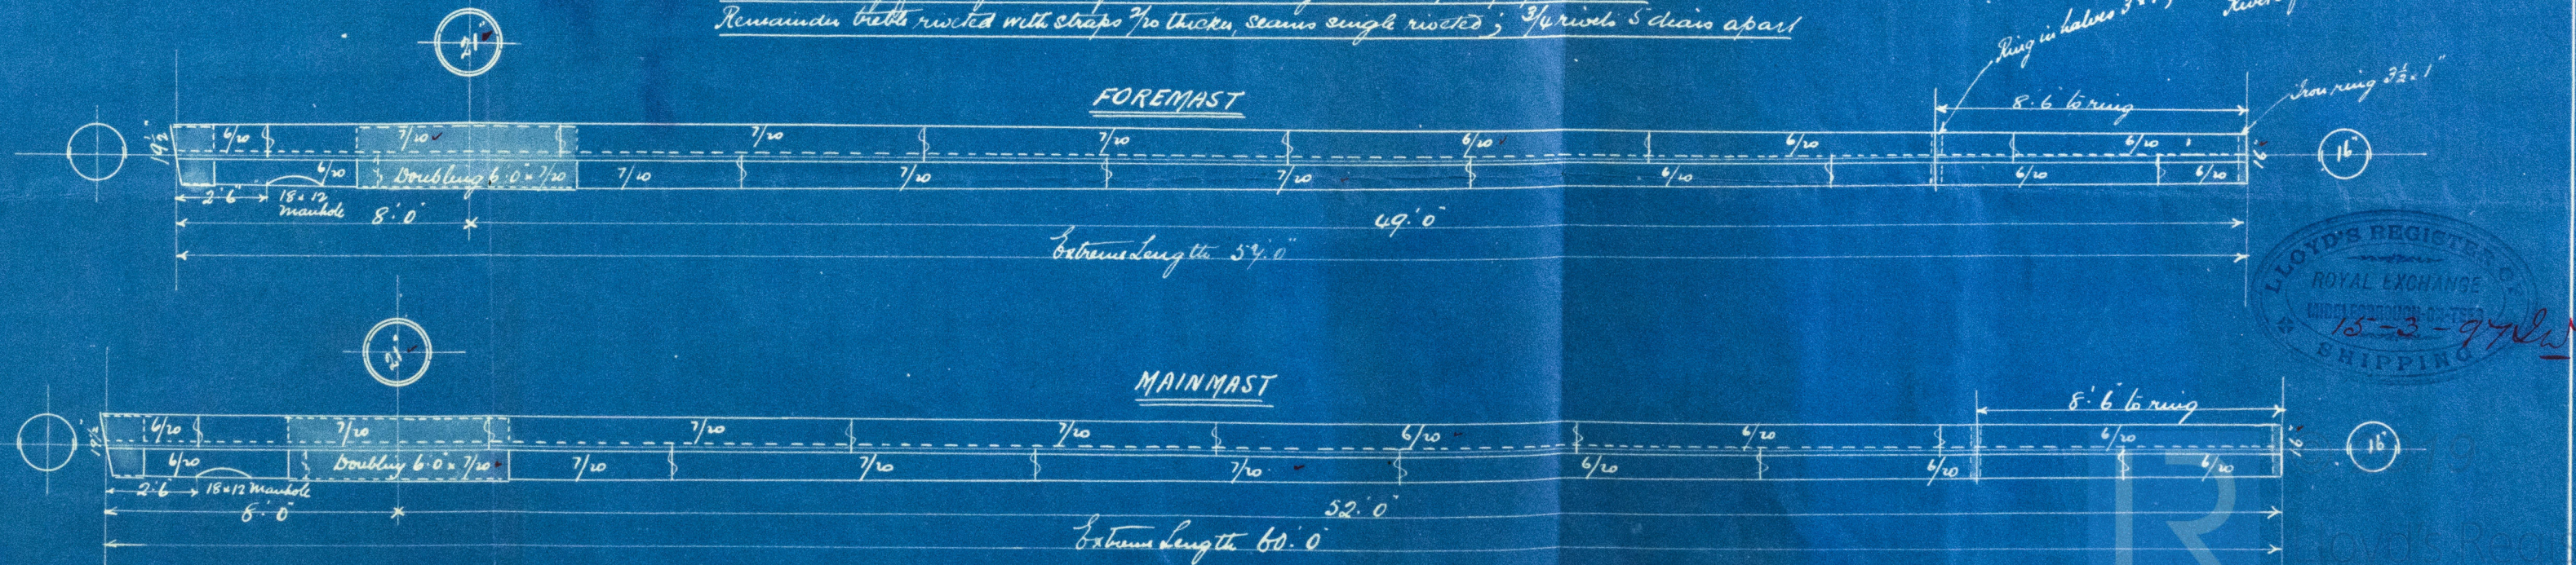

10/3/97.

HPL381-0056