


PUMPING ARRANGEMENT

Scale 1/4" = 1 foot

Under deck tons = 2720 tons approx.

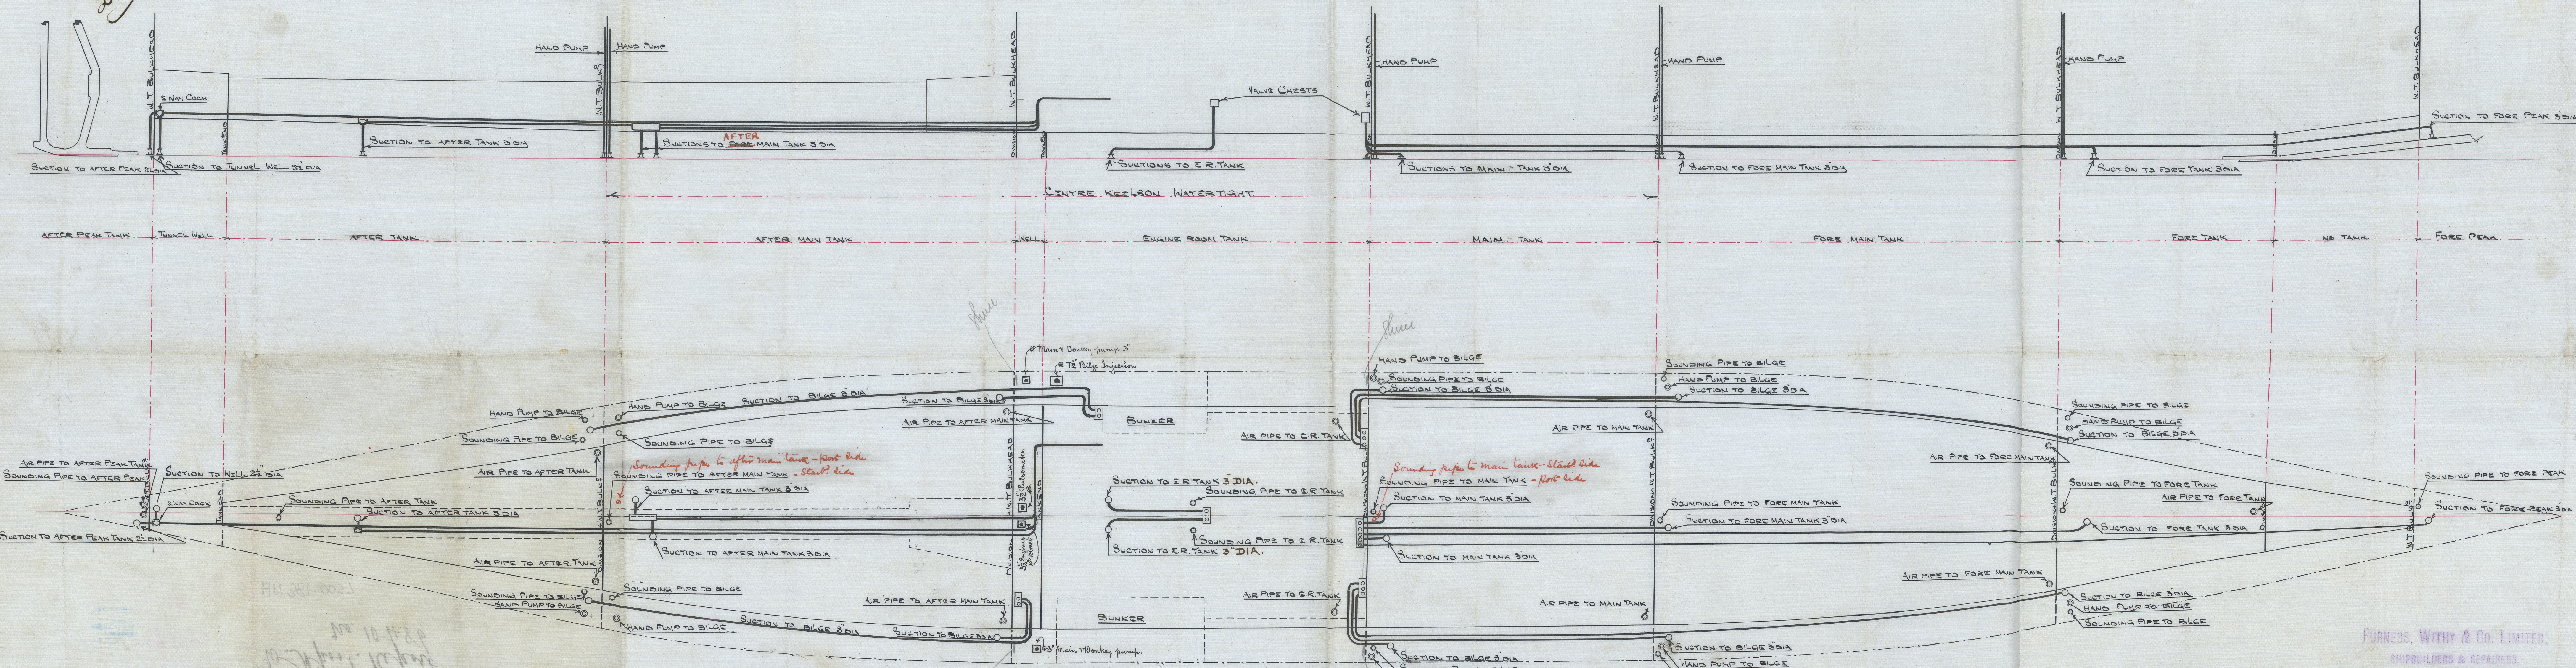

N^o 234

Mr. J. H. 10.4.80

Arrangements to be made for draining tank top
in holds, as in previous cases, where tank is higher
at the sides than in the middle.

FURNESS, WITBY & Co. LIMITED,
SHIPBUILDERS & REPAIRERS,
WEST HARTLEPOOL.

N^o 234

J.M.
27/5/97

Furness Wetley & Co.


No. 234

Pumping plan.

U.S. "Argyria".

W. H. Pool. Report

No. 10486

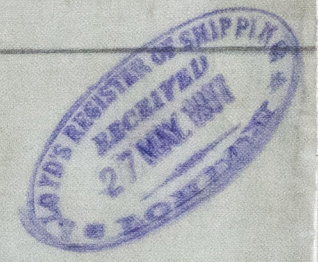

LCZ N
No 534

HPL381-0057

