

SCALE  $\frac{1}{8} = 1 \text{FOC}$

1  
 2  
FURNESS, WITNEY & CO. LIMITED  
SHIPBUILDERS & REPAIRERS  
WEST HARTLEPOOL

12/17/17 emb © 2020  
Lloyd's Register  
HP4381-0059




Furness Withy & Co.

No. 234

Amended Profile

s.s. 'Assyrian'  
W. H. Pool. Report  
No. 10486.

HPL381-0059

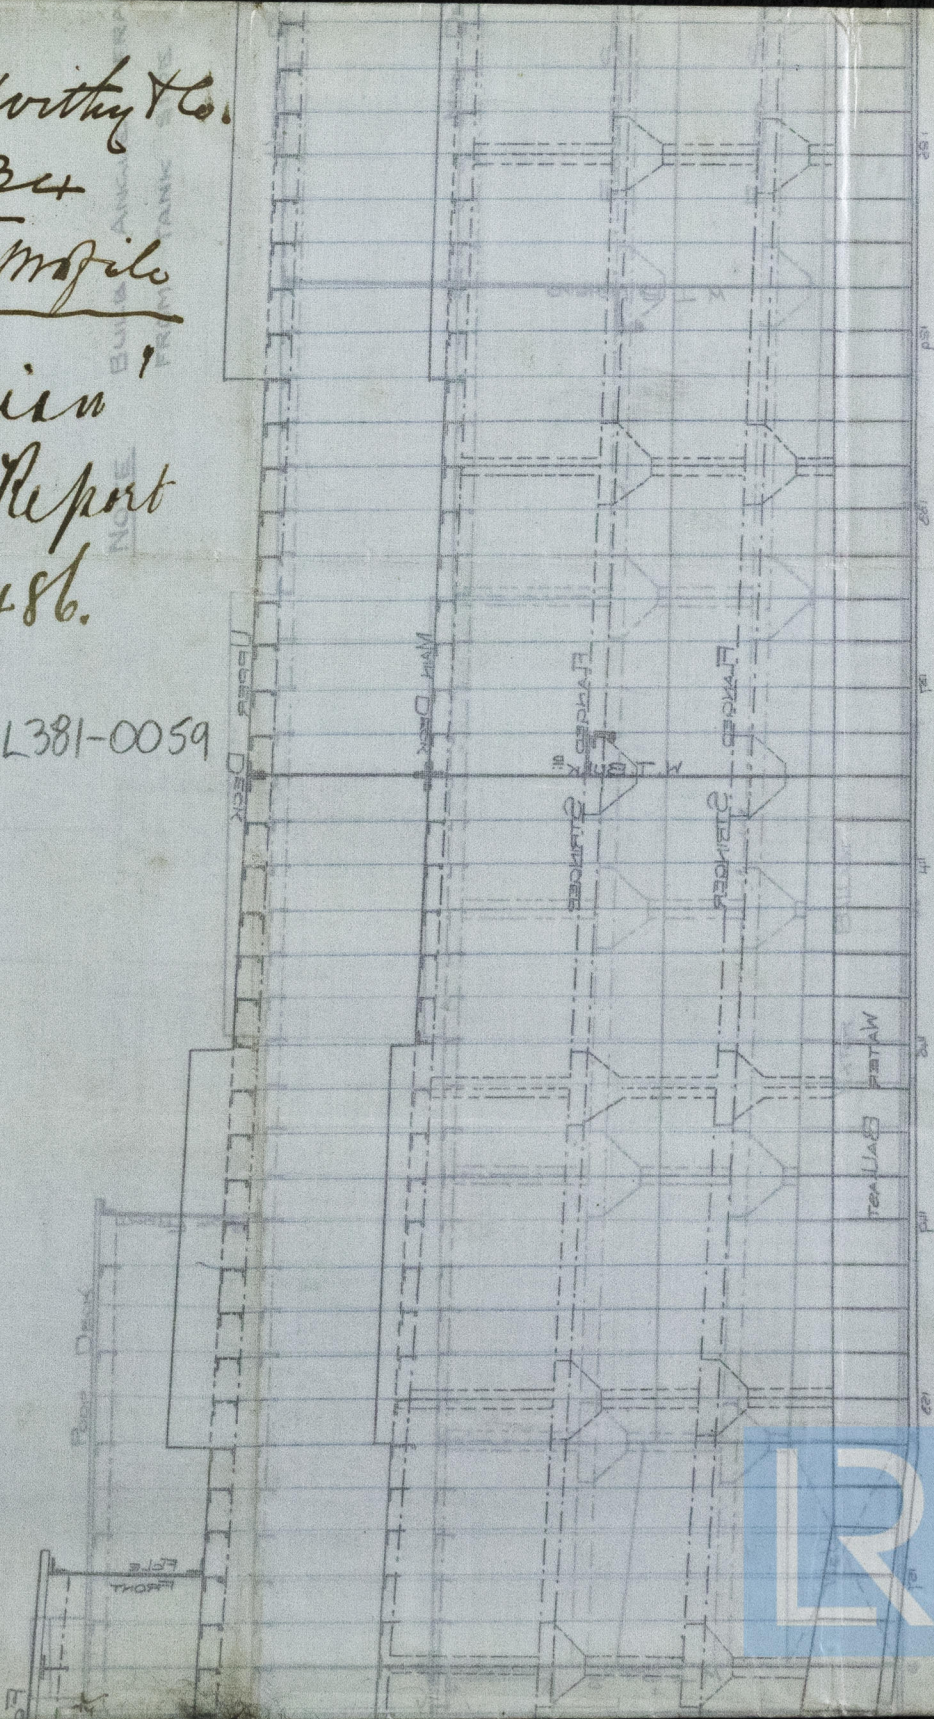

© 2020

Lloyd's Register  
Foundation