

Nº 234.

SCALE $\frac{1}{8}'' = 1 \text{ FOOT}$

webs 19" deep

works 18" deep

Wrote 19th Aug


© 2020
18/12/96
Lloyd's Register
HPL 381-0060
Foundation

James Wither Ho

No. 234

Profile.

See attached profile

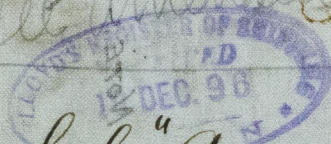

S.S. "Assyrian"

W. Hpl. Report No. 10444.
10486

HPL381-0060



© 2020

Lloyd's Register
Foundation