


MIDSHIP SECTION *S.S. Rapidan*

1/2 SCALE

22. 2. 97
16. 2. 97
6. 3. 97
20. 3. 97
16. 7. 97
11. 8. 97

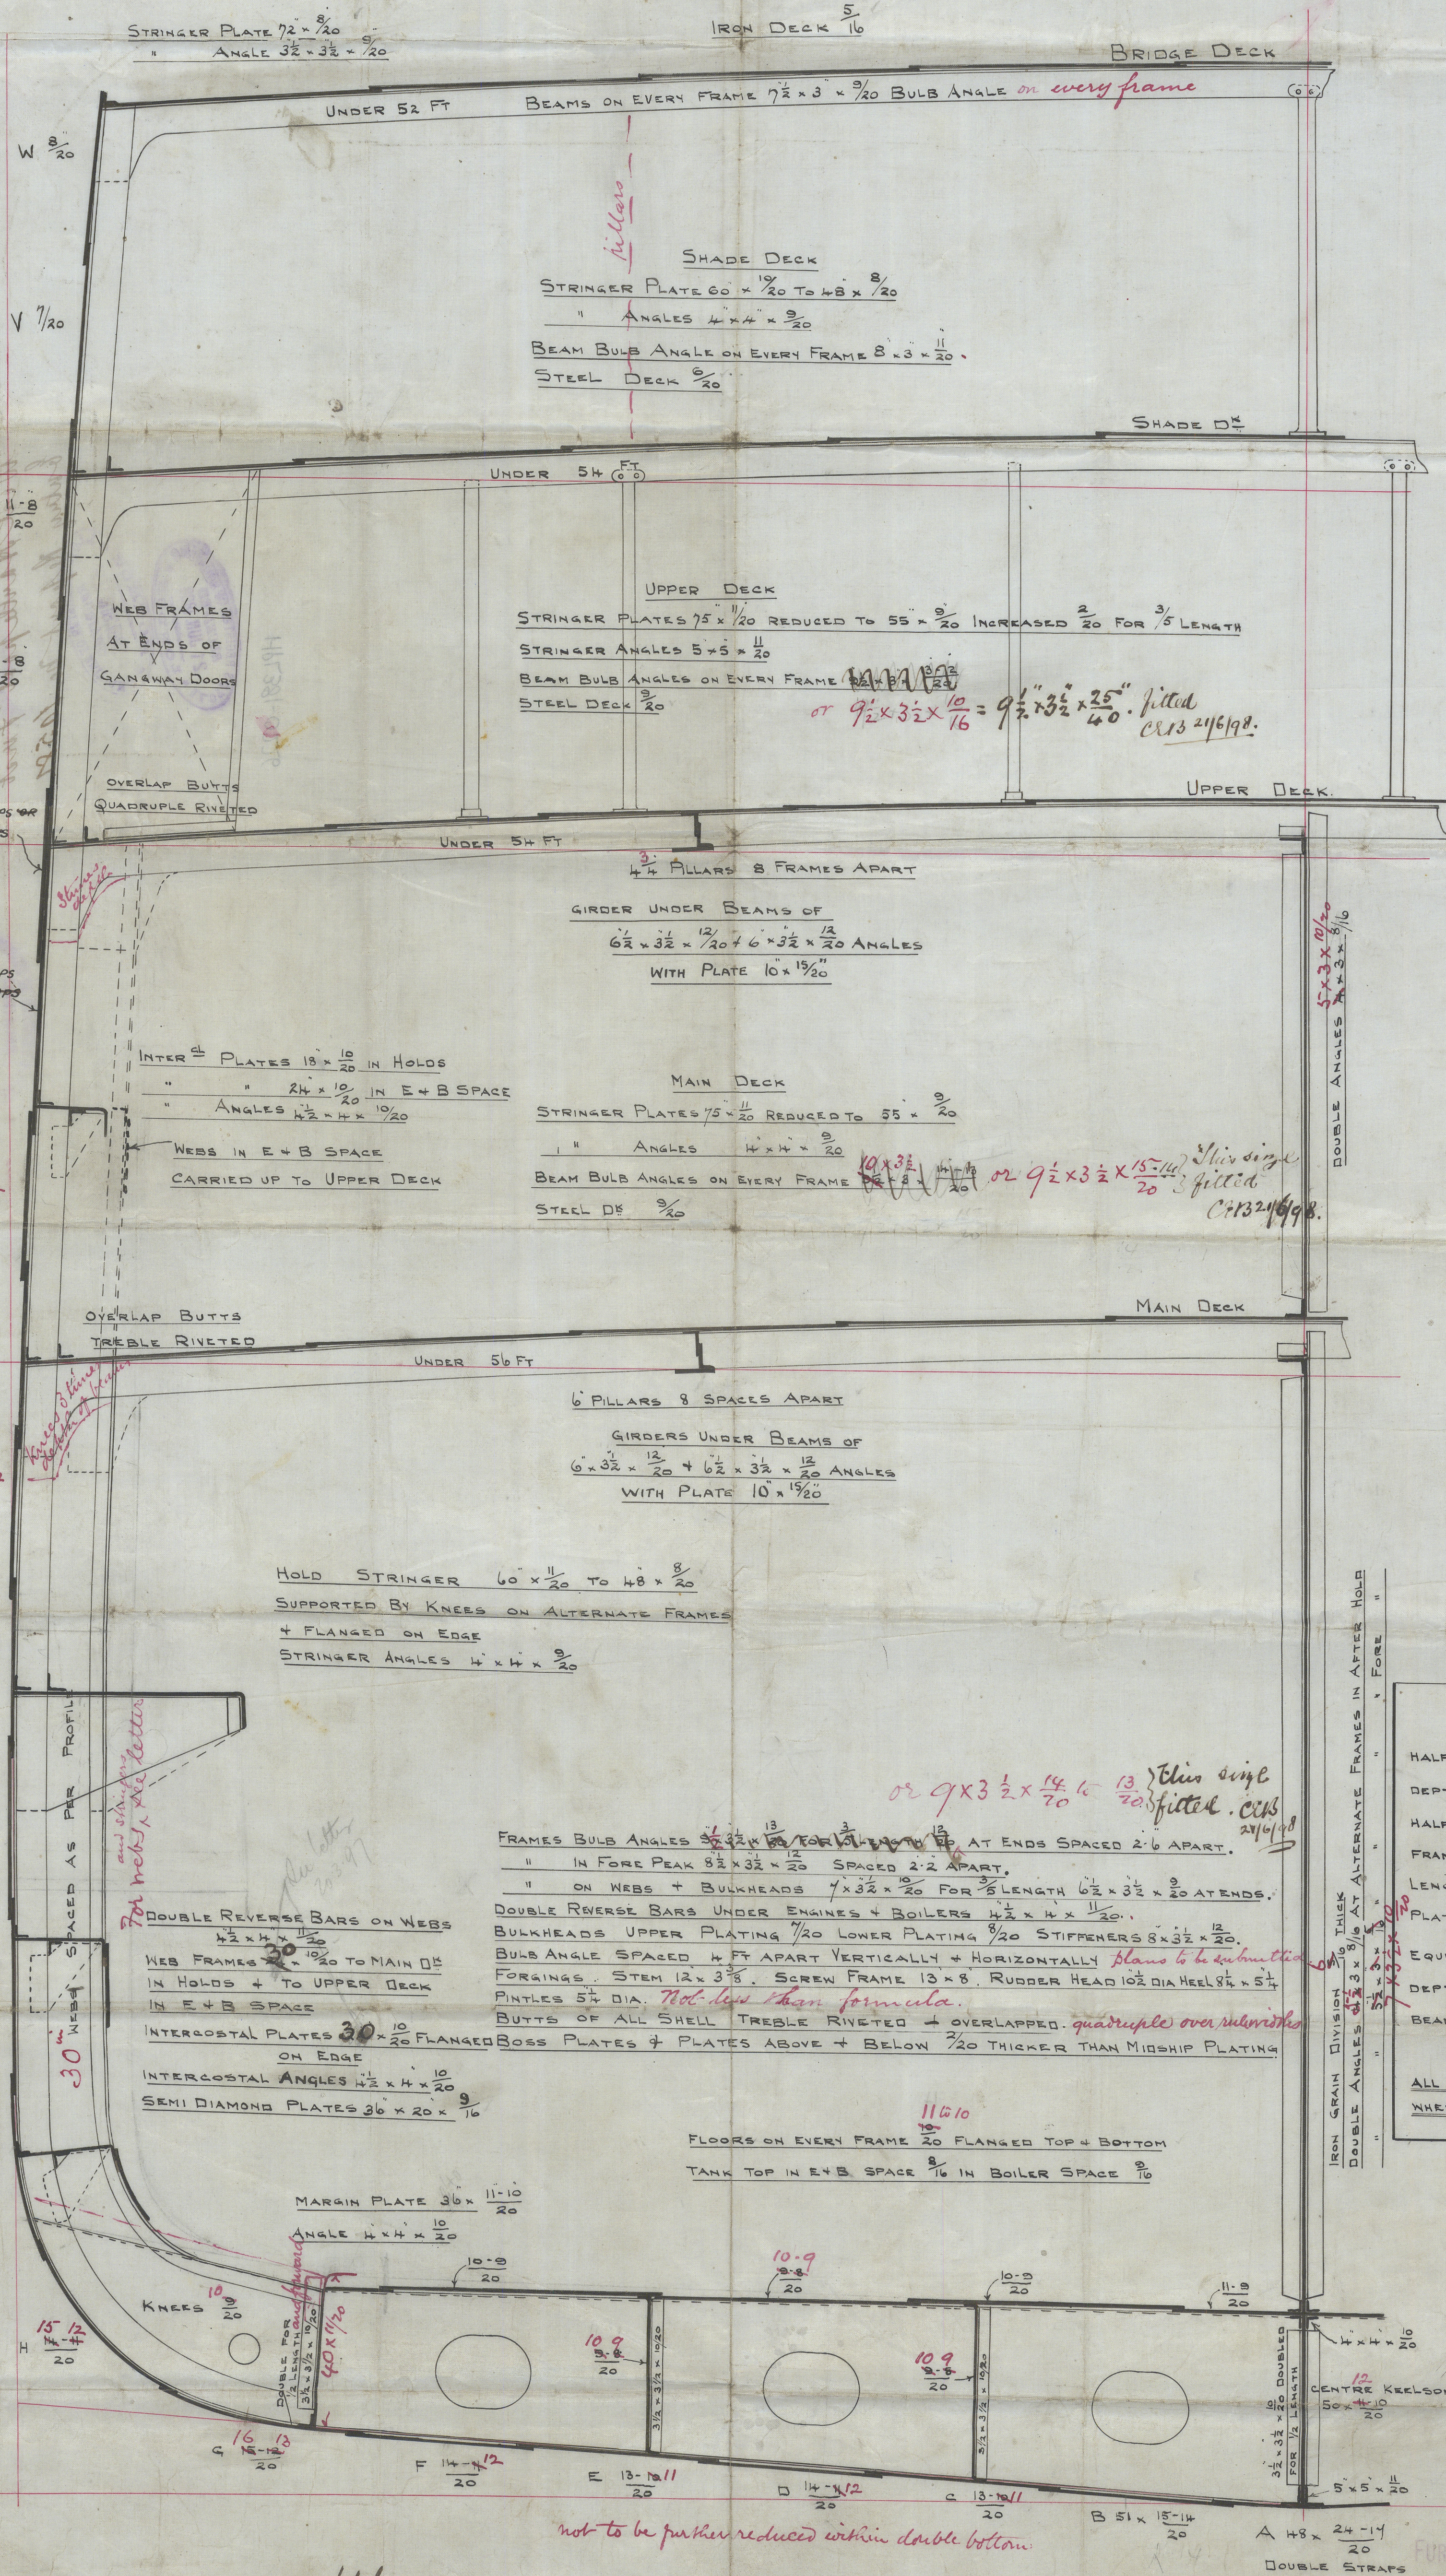

LYDD'S NUMERALS.

| | |
|------------------------|--------|
| HALF BEAM MOULDED | 27-102 |
| DEPTH OF HOLD + FLOORS | 36.8 |
| HALF GIRTH | 59.12 |
| FRAME NUMBER | 116.8 |
| LENGTH PER RULE | 472.11 |
| PLATING NUMBER | 55178 |
| EQUIPMENT NUMBER | 65802 |
| DEPTHS IN LENGTH | 12.00 |
| BEAMS IN LENGTH | 8.48 |

CLASS 100 A1. THREE DECK

ALL SCANTLINGS OF STEEL EXCEPT WHERE OTHERWISE SPECIFIED.

N^o235

FURNESS, WITTH & CO. LIMITED.
SHIPBUILDERS & REPAIRERS
12/2/11
14220

Furness Withy & Co.

No. 235

Midship Section

s.s. "Rapideau."

West Hartlepool Freeboard

Report No. 10455.

West Hartlepool First
Entry Report No. 10581.

HPL381-0226



© 2020

Lloyd's Register
Foundation