


NORTHUMBERLAND ENGINE WORKS


TRACING 3297

SCHEDULE L

STEAM BOILER

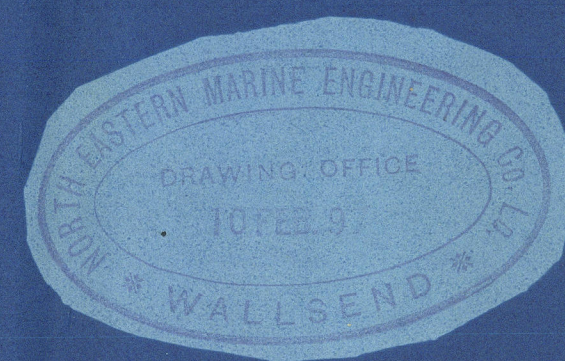

Handwritten: 12:2:01

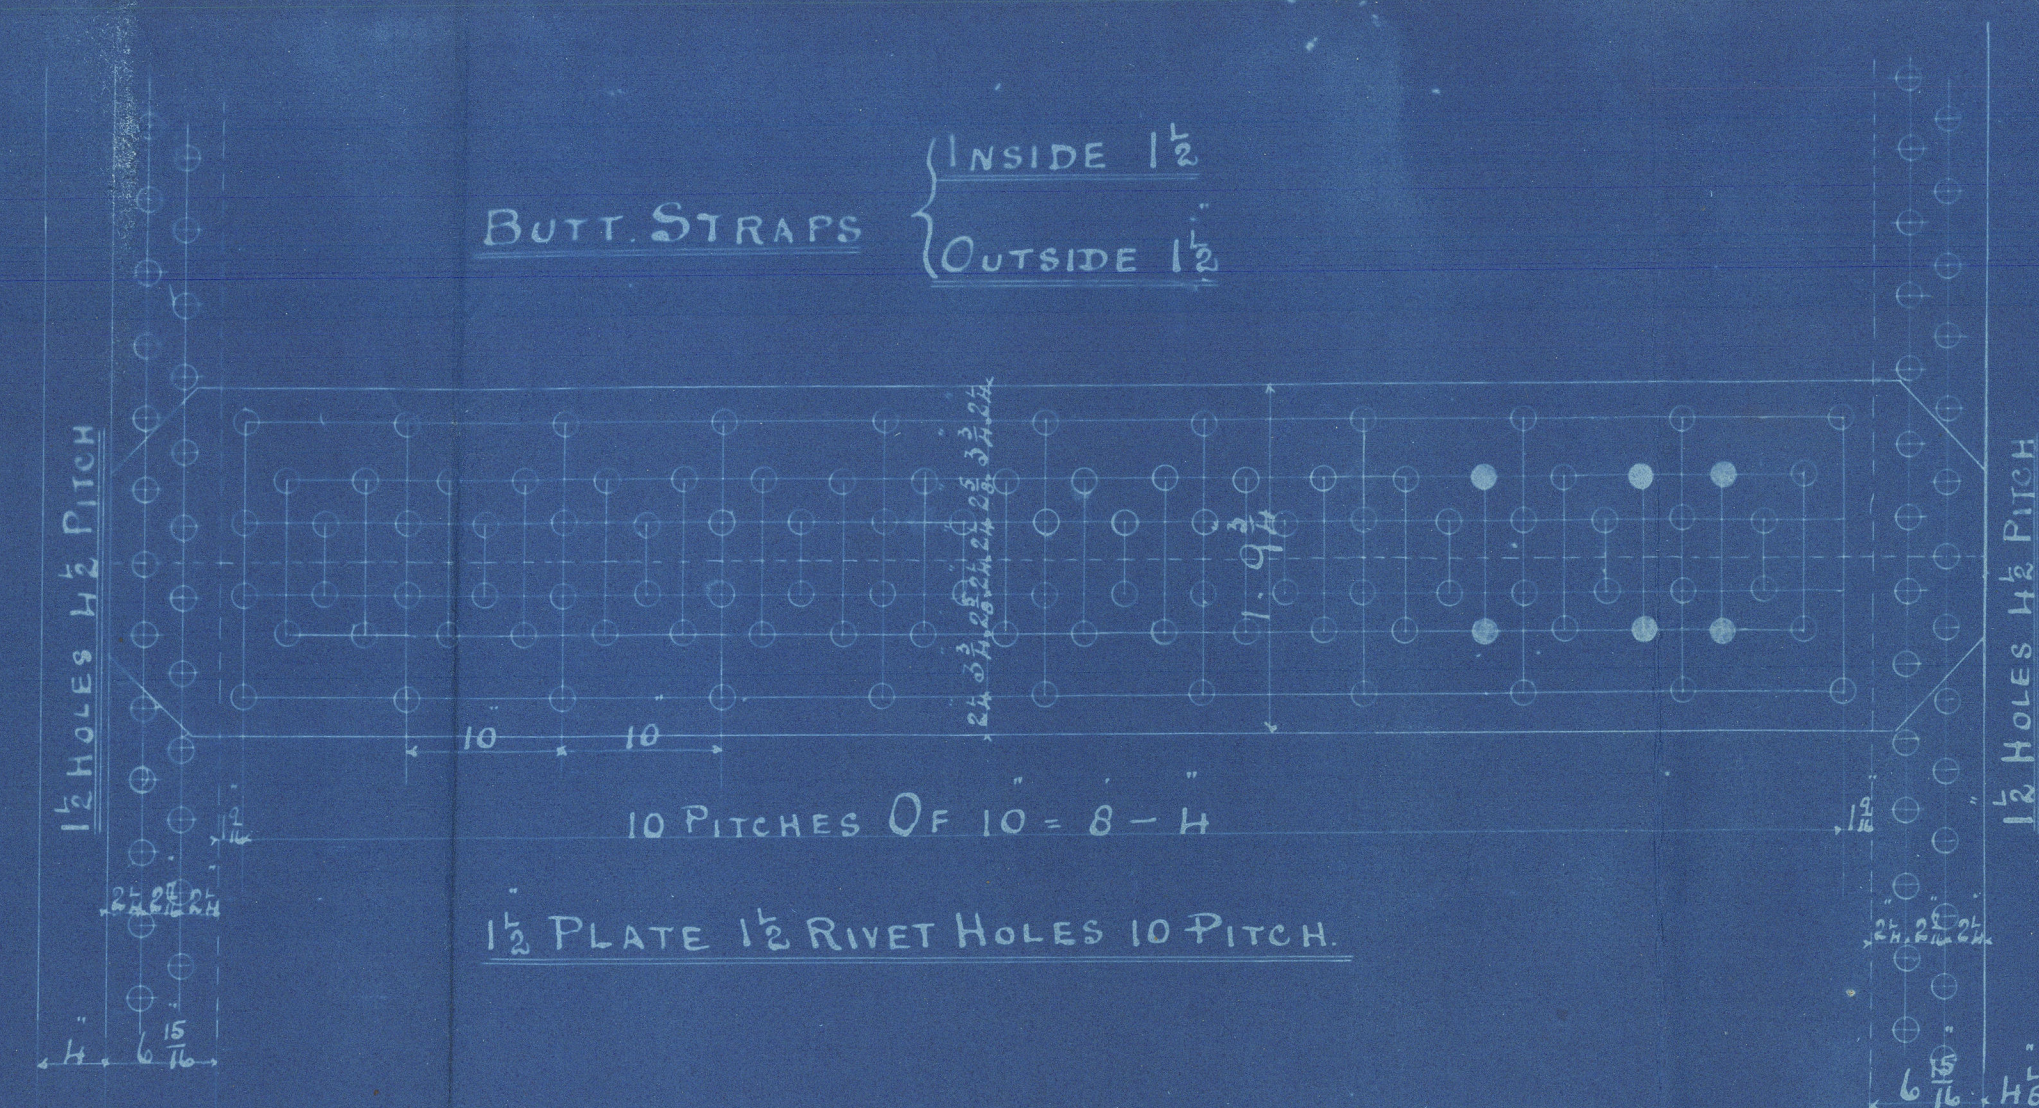




WORKING PRESSURE = 180 LBS.

TEST = 360

NOTE - ALL PLATES STAYS & TO BE OF STEEL EXCEPT OTHERWISE SHEWN

TENSILE STRENGTH OF SHELL PLATING TO BE NOT LESS THAN 28 1/2 TONS PER SQ. INCH

ALL HOLES DRILLED IN PLACE AFTER PLATES ARE BENT

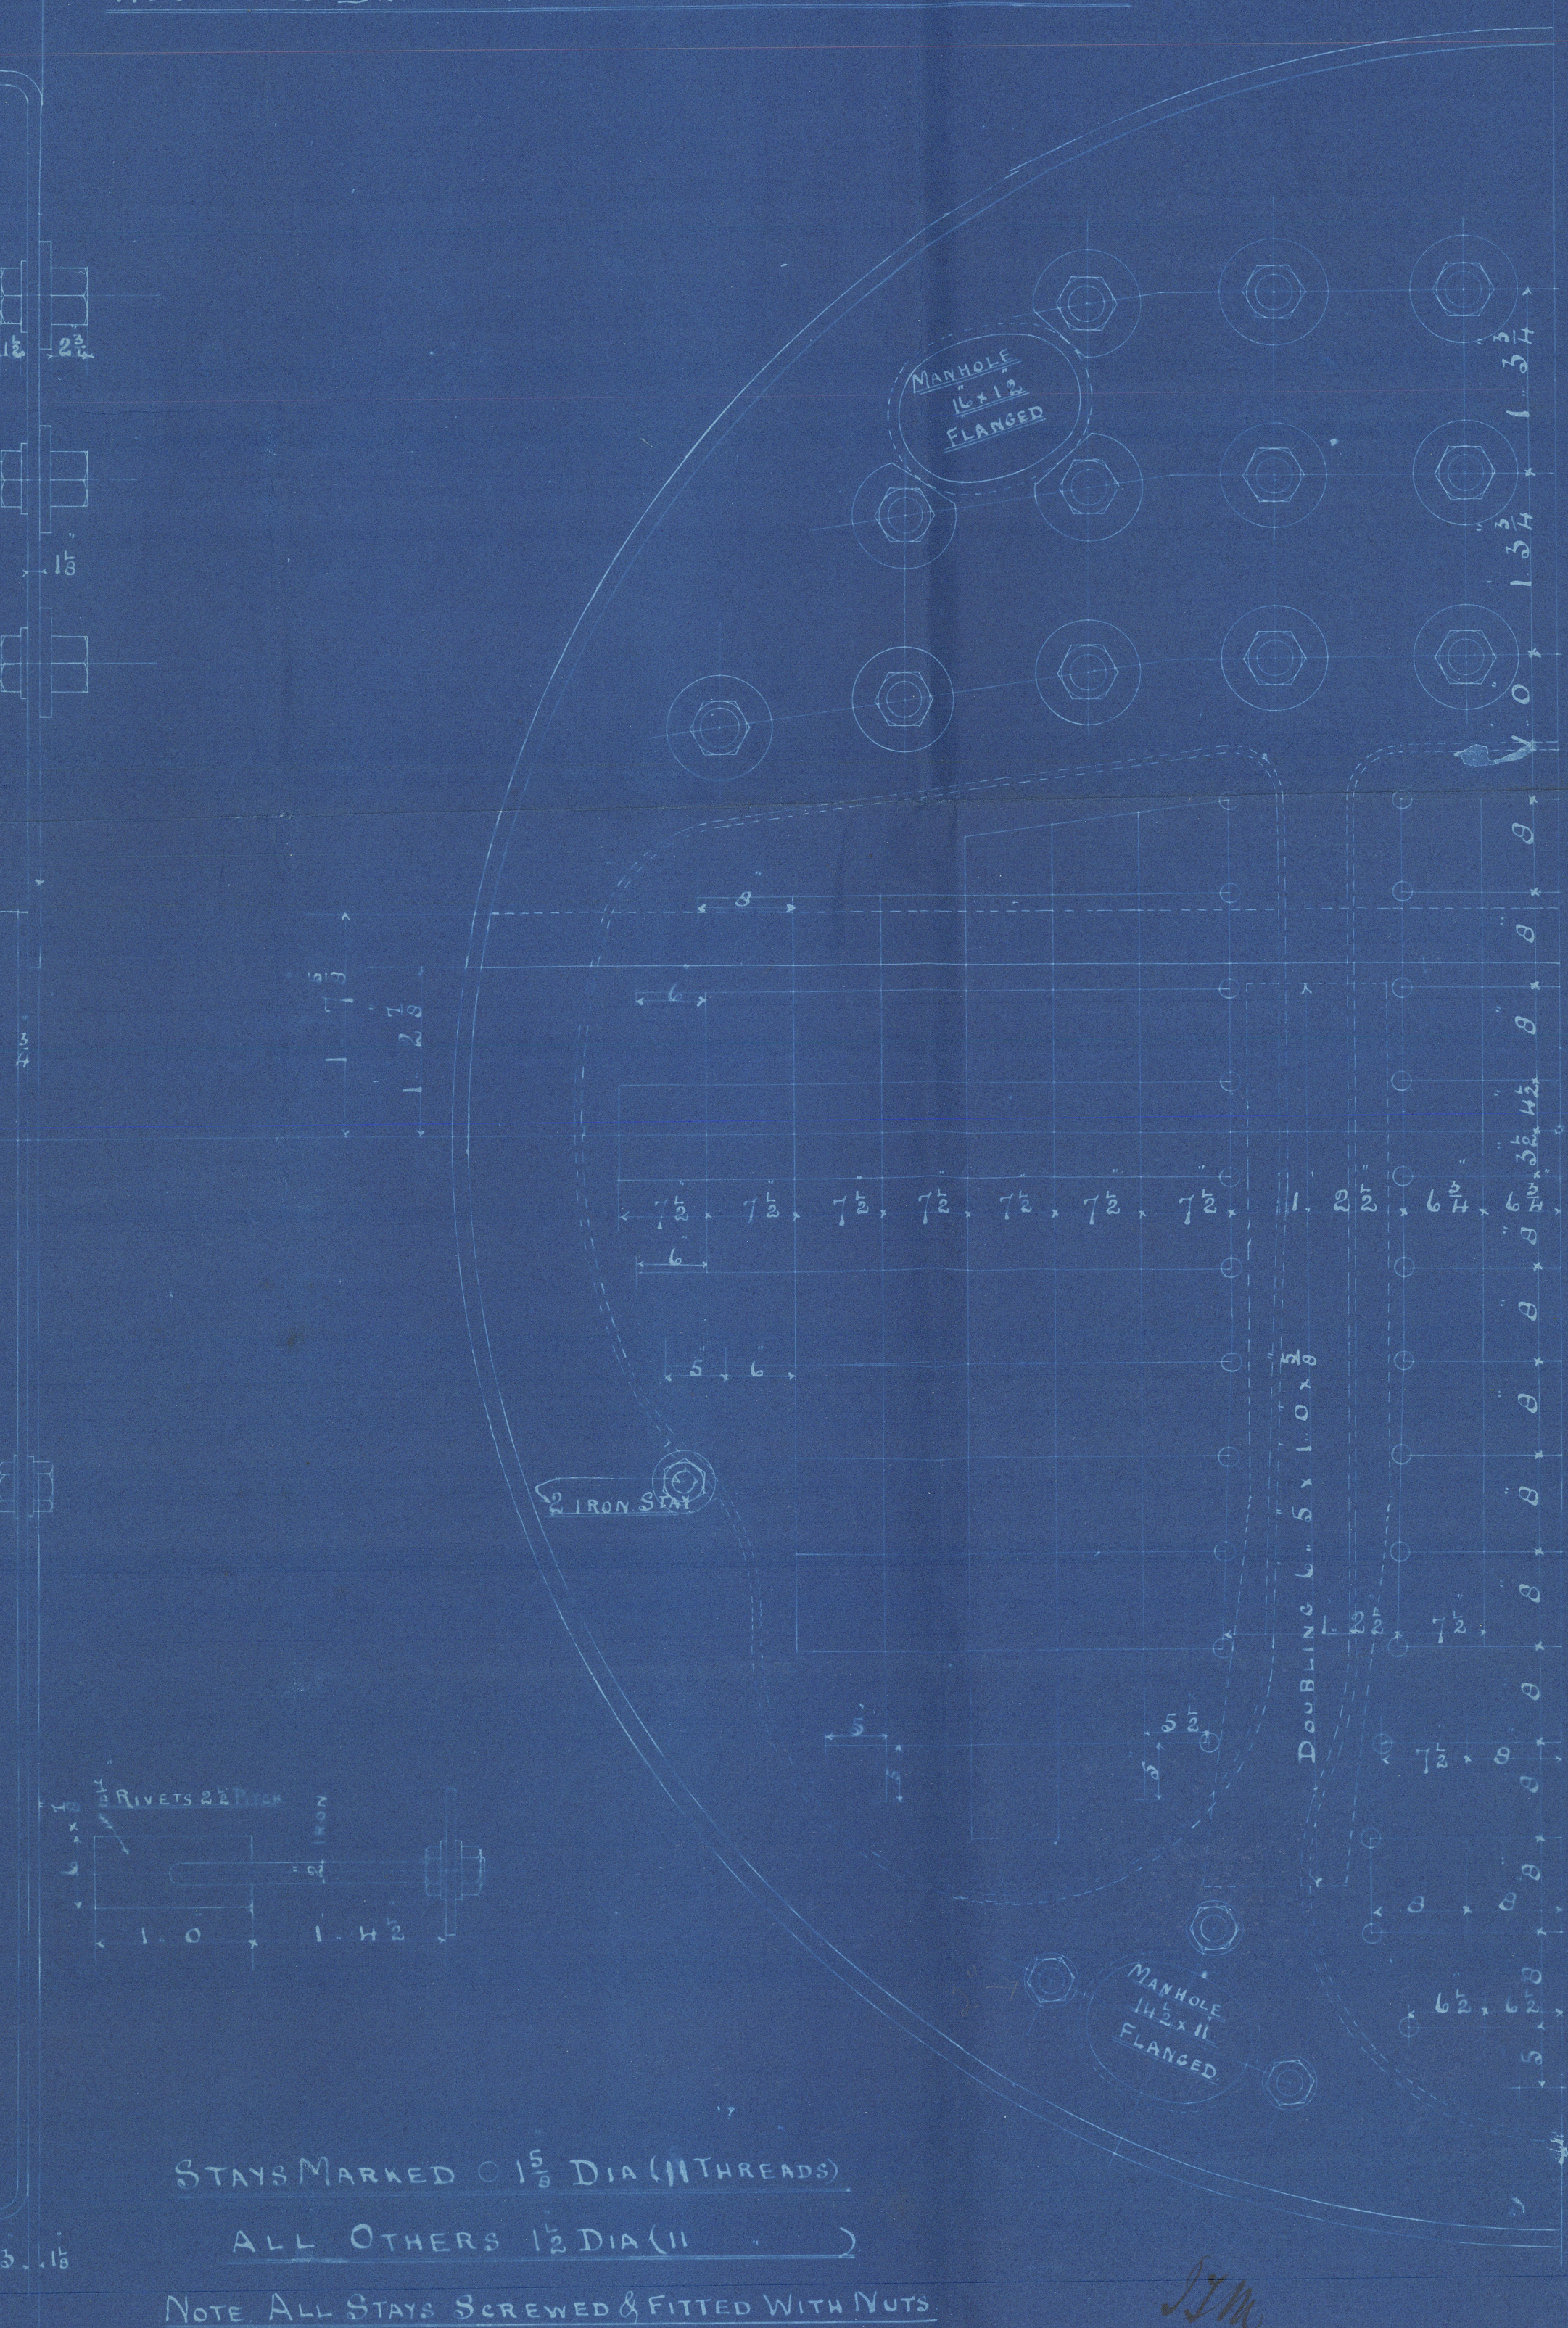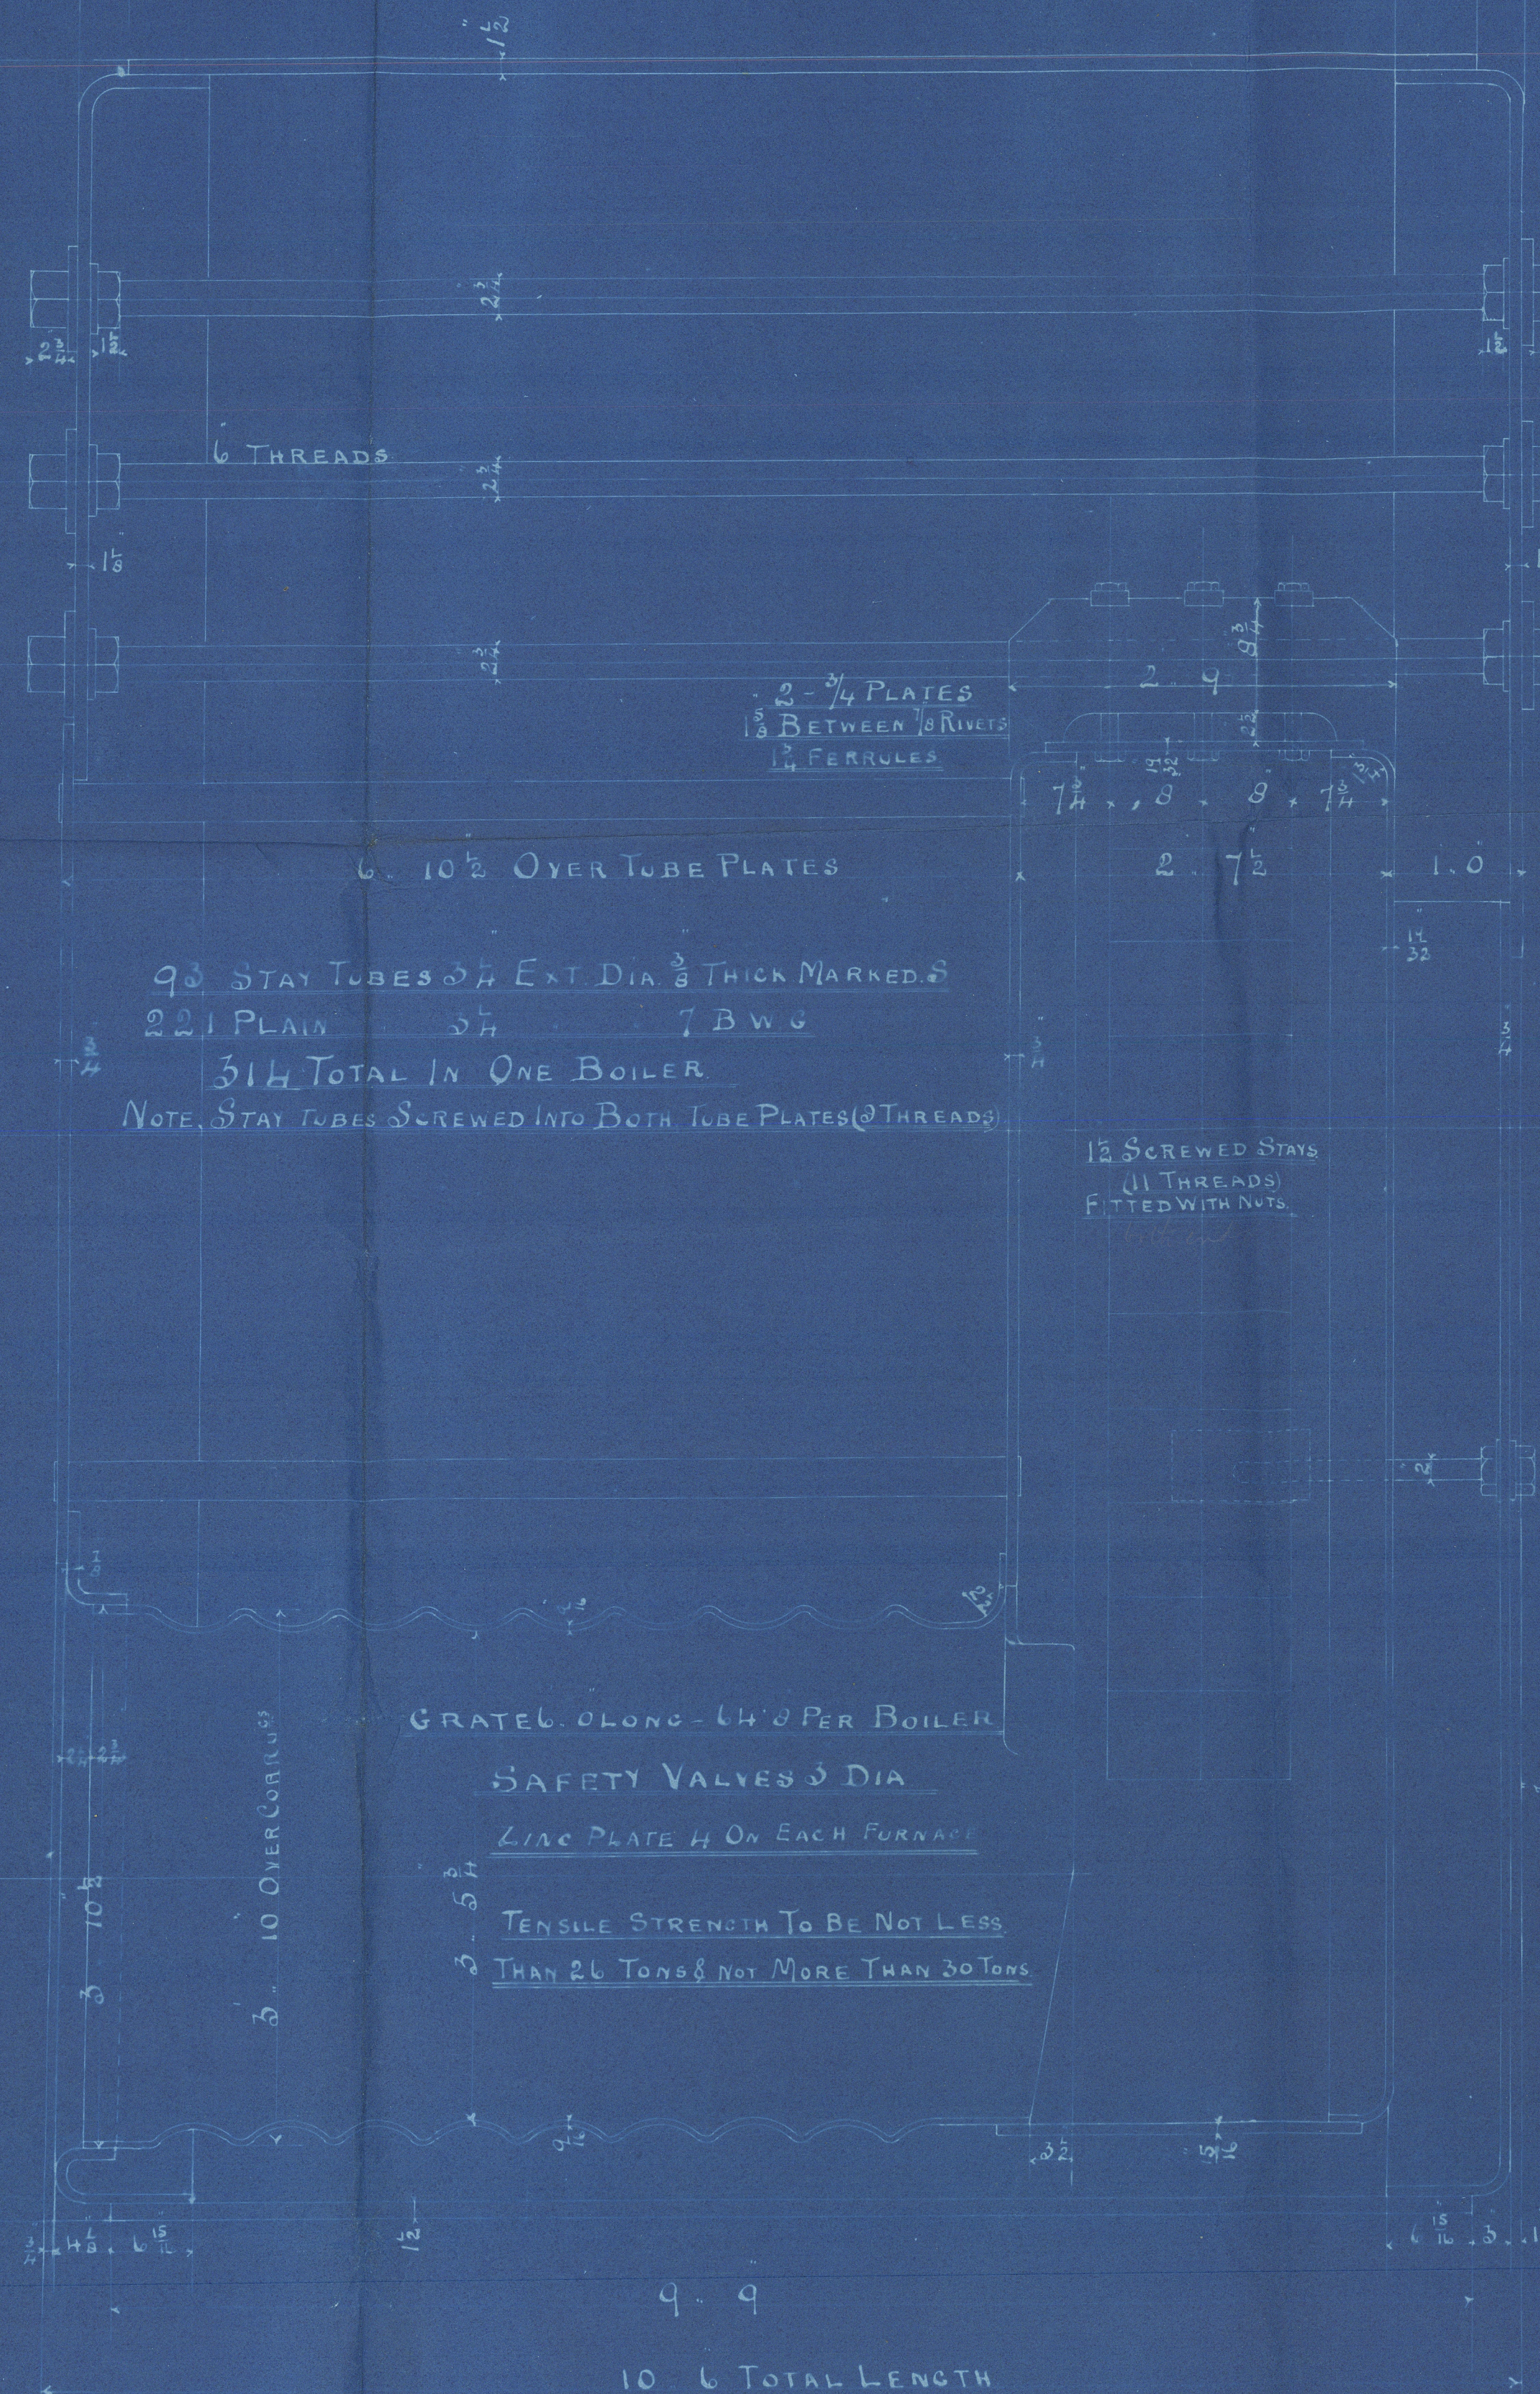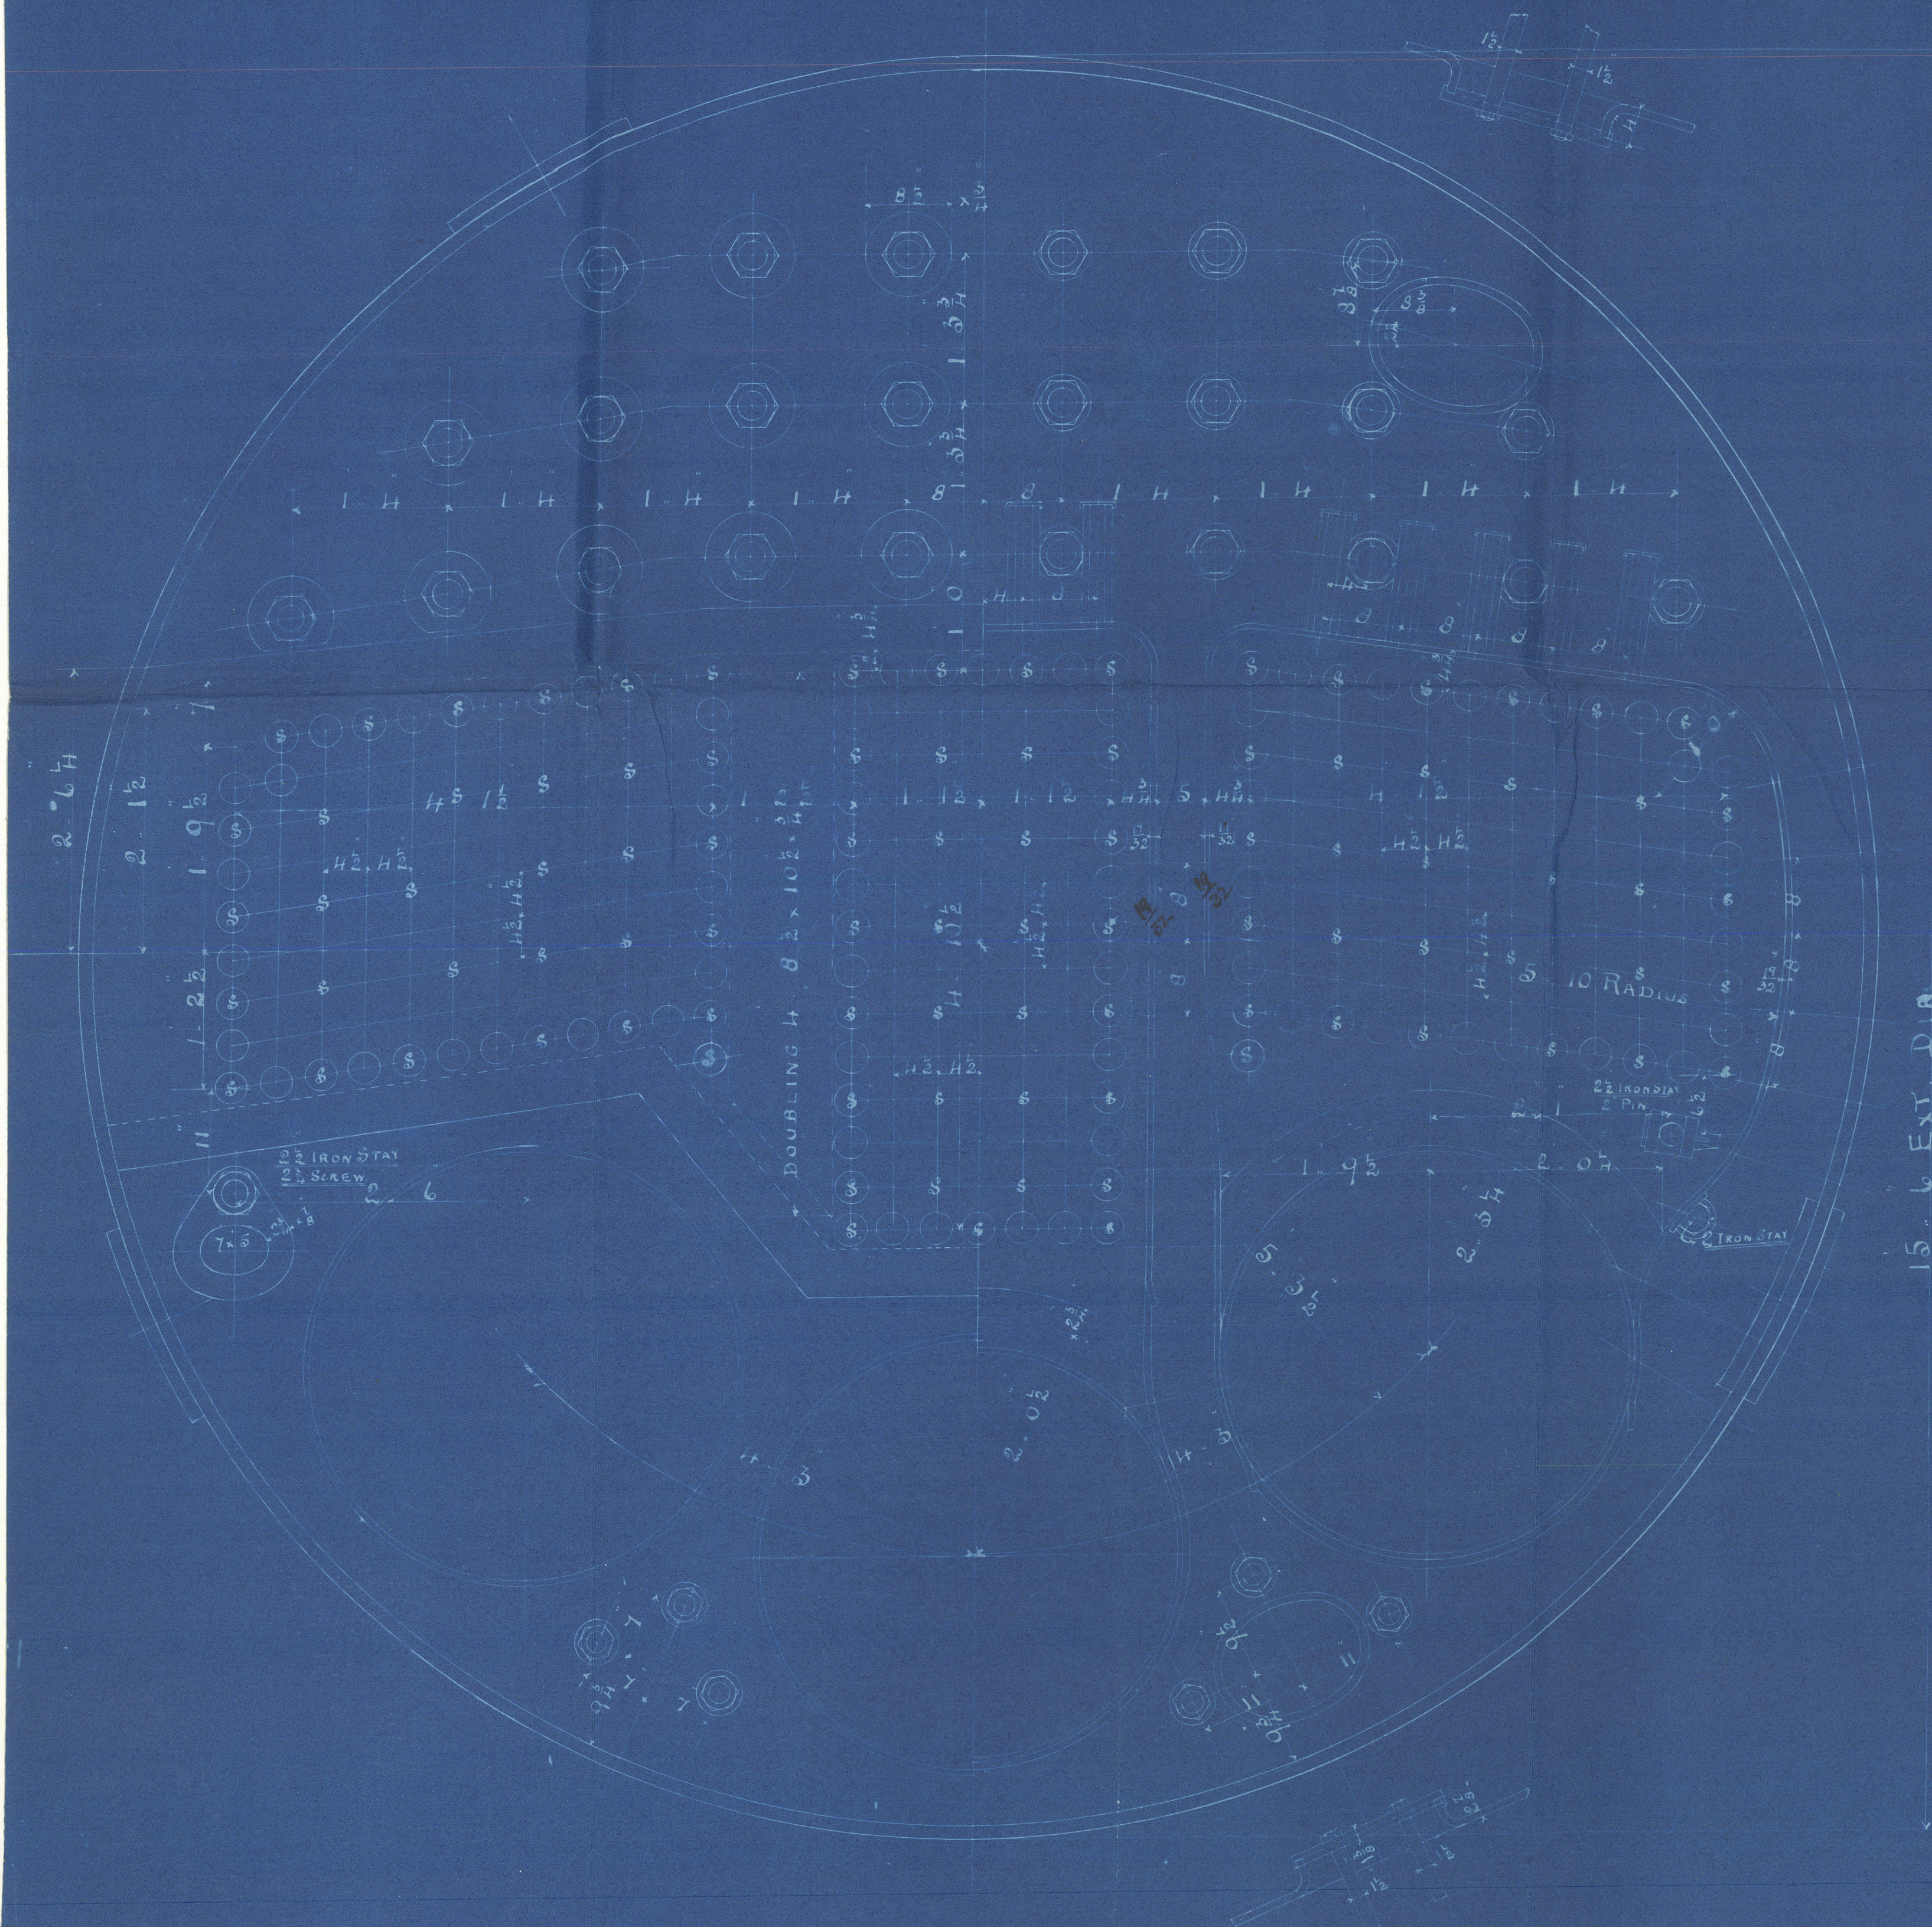

STAYS MARKED O 1 1/2" DIA (11 THREADS)

ALL OTHERS 1 1/2" DIA (11)

NOTE ALL STAYS SCREWED & FITTED WITH NUTS

2 THUS

2 OPPOSITE HAND

CONTRACT 770



N. E. M. E. CO., LIMITED, WALLSEND.

ENCLOSURE
FOR

*W. Lloyd's Register
Foundation*



4 Main Boilers.

North Eastern M. Eng. Co. Ltd

No 470.

Furness Withy & Co. 1/5 235.

Working Pressure 180 lbs.

1st two ^{boilers} marked thus.

No 5204
Lloyds Test
360 lbs.
A.C. 25-2-98

2nd two boilers marked thus.

No 5219
Lloyds Test
360 lbs.
A.C. 9-3-98

S.S. "Rapidan"

Invc. F.E. Report No 36557
W. Hpl F.E. No 10581

HPL381-0227



© 2020

Lloyd's Register
Foundation