


22.2.97
 26.2.97
 6.3.97
 20.3.97
 16.7.97
 11.8.97

PROFILE

SCALE 1/2" = ONE FOOT.

NOTE:- BULB ANGLE FRAMES IN ONE LENGTH FROM TANK SIDE TO UPPER DECK.

See also plan of erections
 attached to pre-board Rpt.

 

Nº 235

For Divisional bulks in Tanks
 see pumping plan.


two girders in d.b. extended forward

FURNISS, WITBY & CO. LIMITED.
 SHIPBUILDERS & REPAIRERS.
 WEST HARTLEPOOL.

Lloyd's Register
 Foundation

Furness Withy & Co
No. 235.

Profile.
is 'Rapidus'

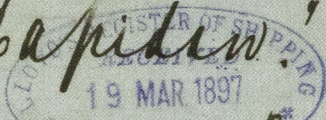


Report No. 10455

First Entry No. 10581

HPL381-0230



© 2020

Lloyd's Register
Foundation