


Furness Withy & Co.
No. 235

Cast Steel Iron Frame

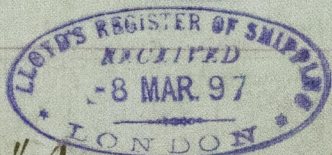

s.s. "Rapidan"
W. H'pool. Report
No. 14581

HPL381-0232




© 2019

Lloyd's Register
Foundation

CAST STEEL SCREW FRAME

SCALE $\frac{1}{2}$ " = 1 FOOT.

22. 2-97

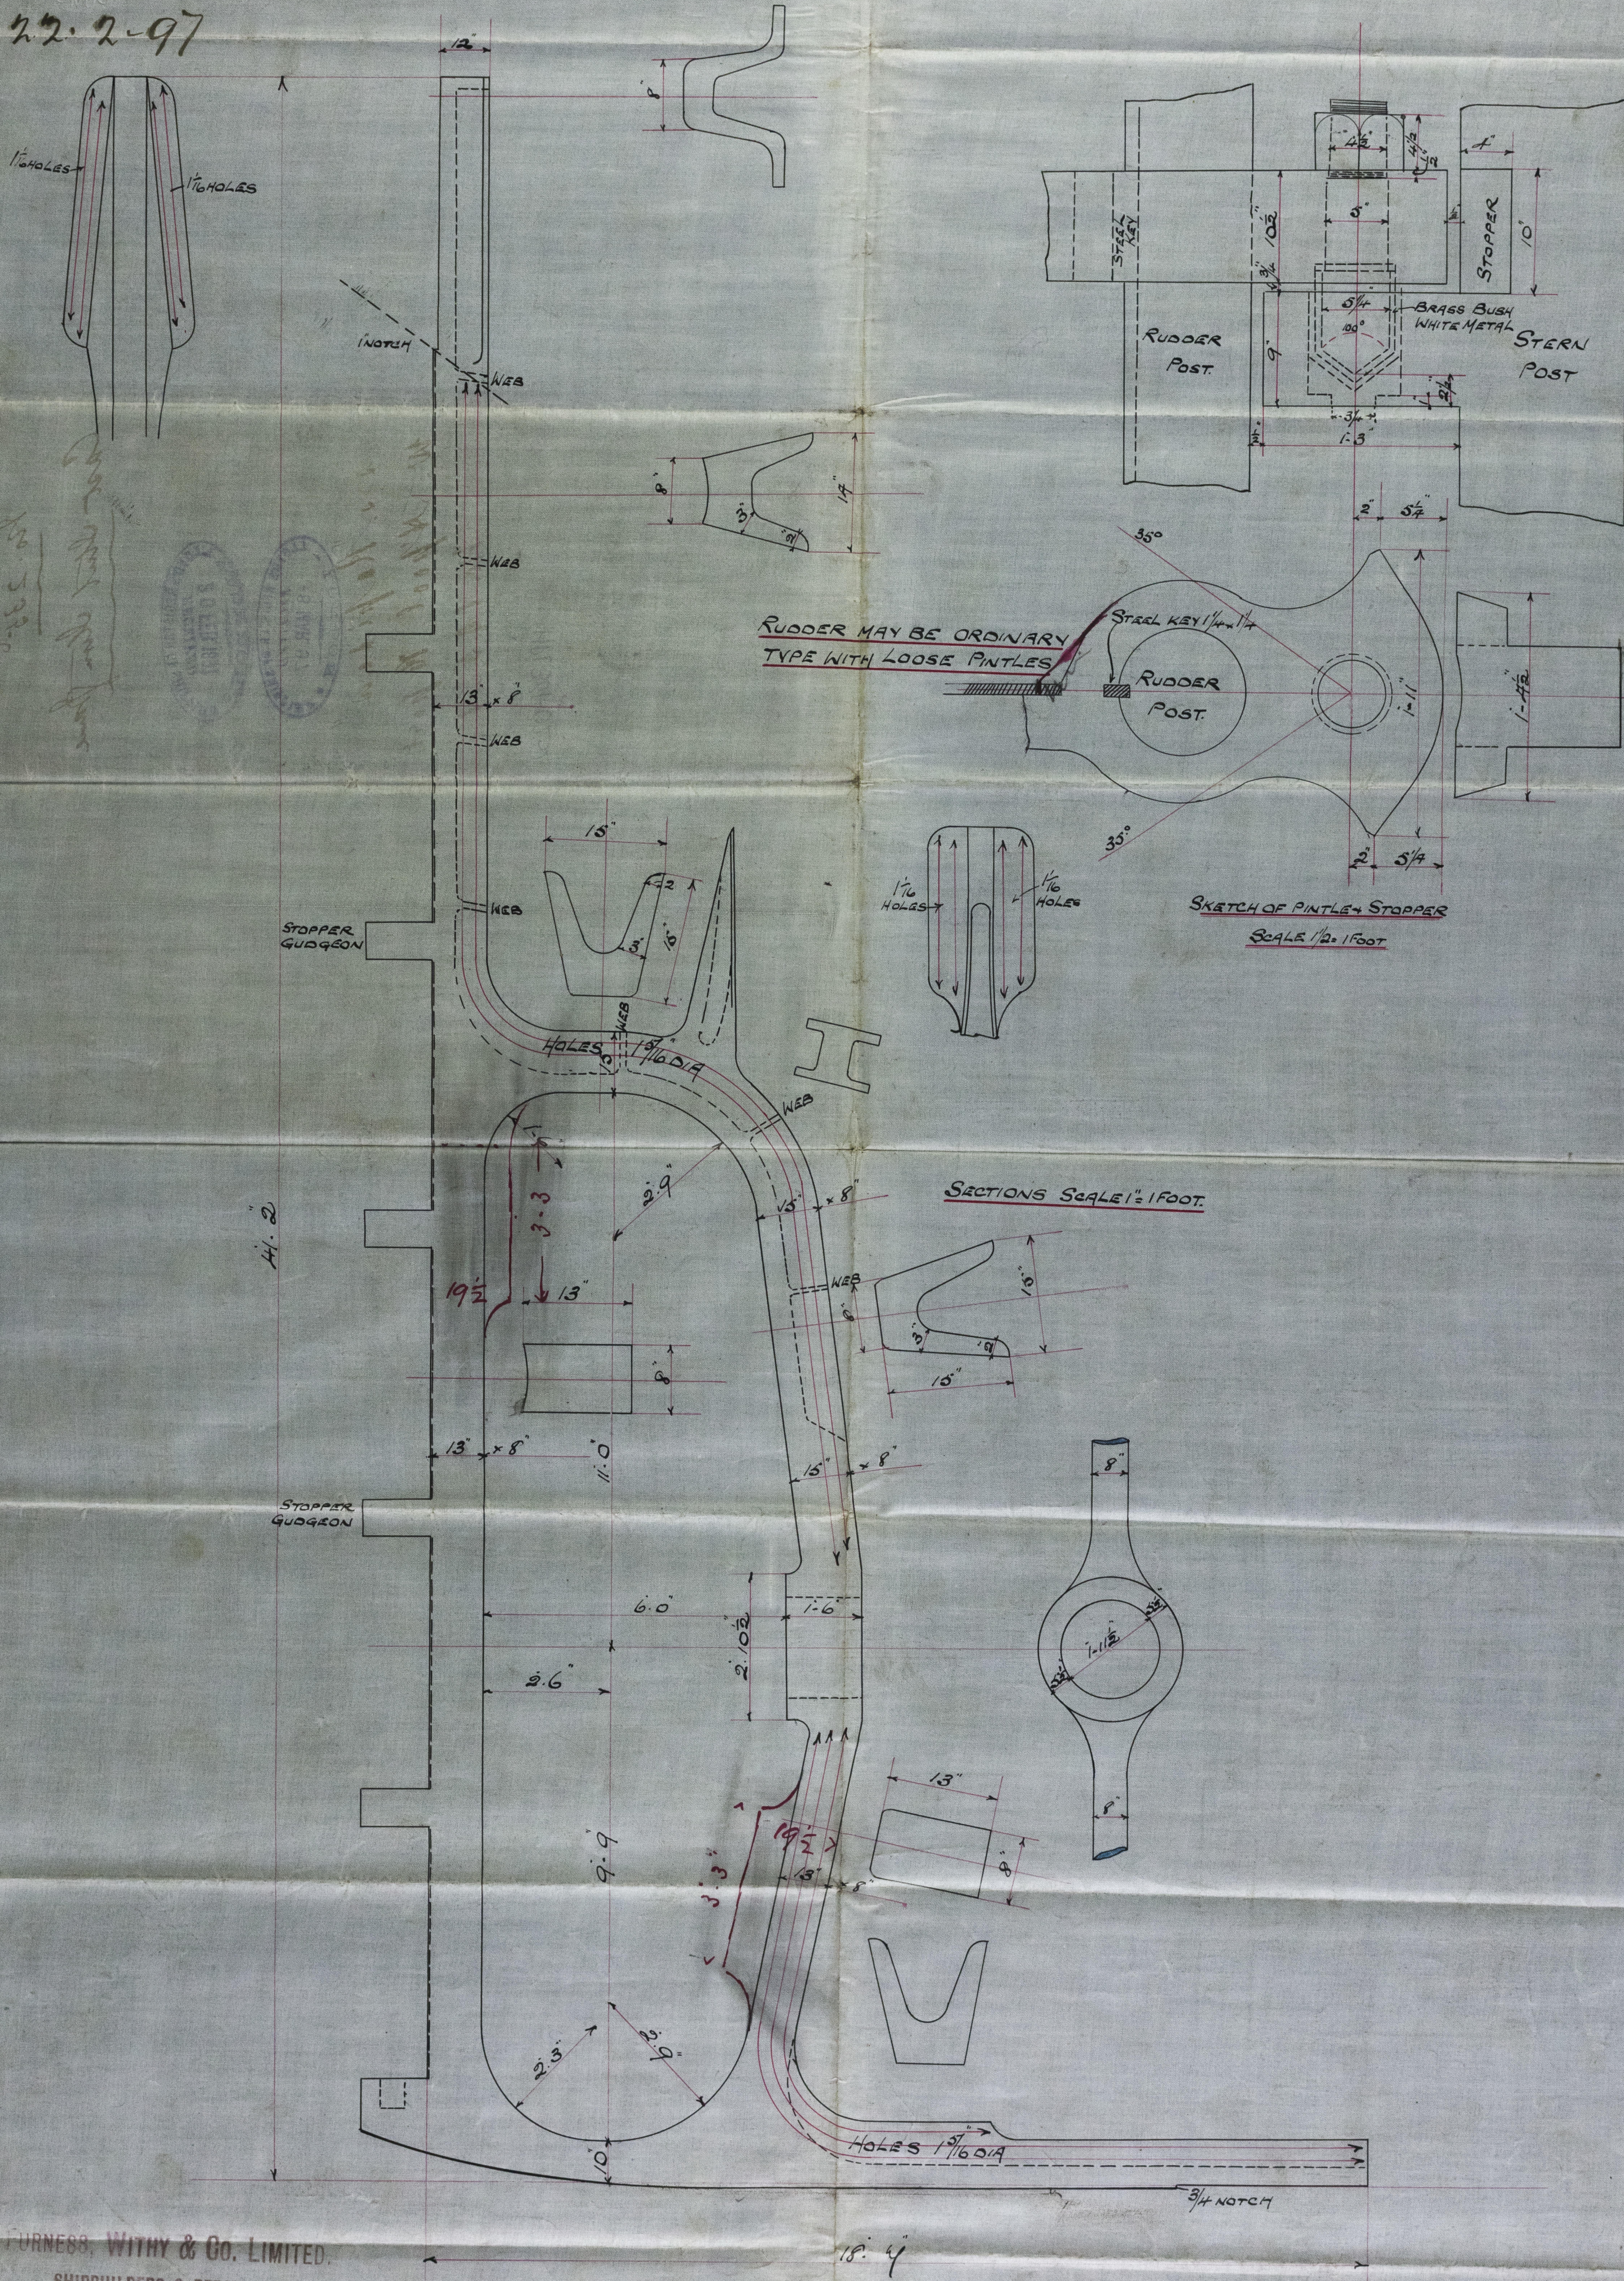

FURNESS, WITBY & CO. LIMITED.

SHIPBUILDERS & REPAIRERS.
FEB 10th 21

FEB 18th 96
T HARTLEPOOL

WEST HARTLEPOOL

Nº 235

17/1
22/497
10/3/97