


1. 1870
 2. 1871
 3. 1872
 221. 2090

S. S. Chicago 1800
(year no 232)

44 no 232 -
 - 22. 2. 97.
 1. 3. 97.
 24. 3. 97.
 12. 4. 97.
 4. 2. 98

S. S. Chicago 1800
(year no 232)

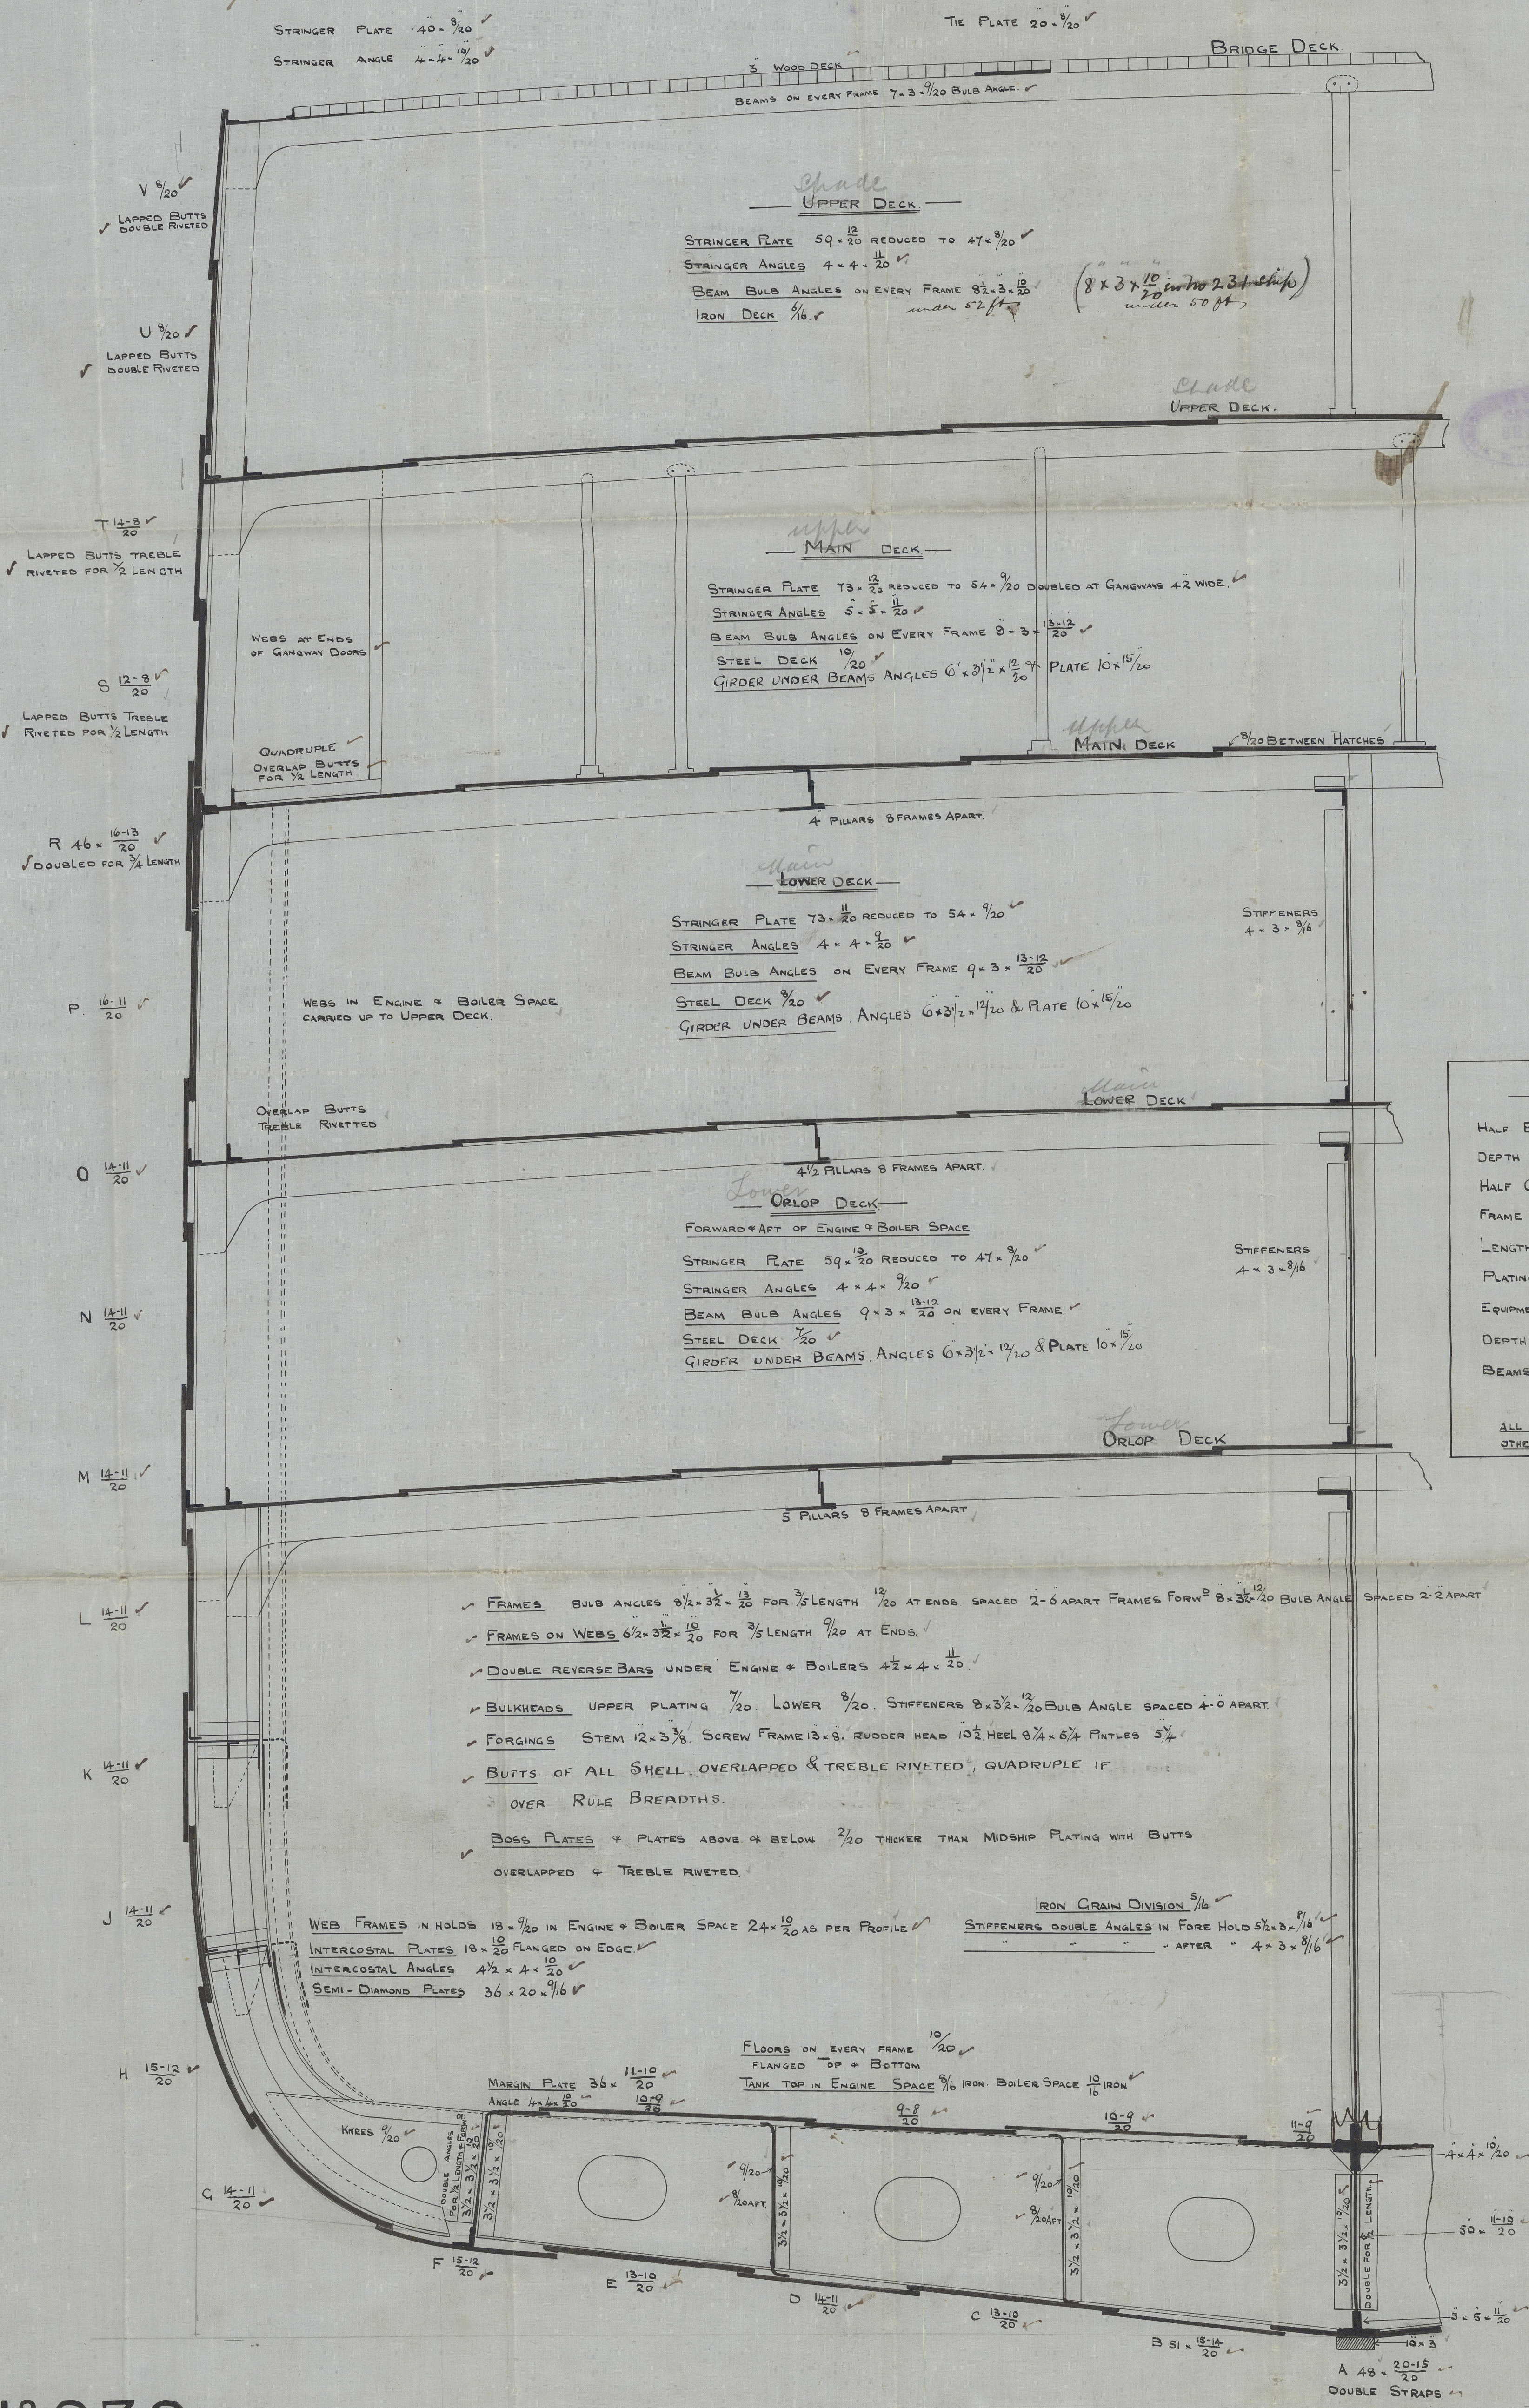

— LLOYDS NUMERALS —

HALF BEAM MOULDED 26-0 -
DEPTH OF HOLD & FLOORS 35-7 -
HALF GIATH 55-6 -
FRAME NUMBER 110-1 -
LENGTH PER RULE 412-0 -
PLATING NUMBER 52069 -
EQUIPMENT NUMBER 62295 -
DEPTH'S IN LENGTH 13-29 -
BEAMS IN LENGTH 9-09 -

— CLASS 100 A1 —

ALL SCANTINGS OF STEEL EXCEPT WHERE
OTHERWISE SPECIFIED.

N^o 232.

FURNESS, WITBY & CO. LIMITED.
SHIPBUILDERS & REPAIRERS.
WEST HARTLEPOOL.
AUGUST 18th 1897

Furness Withy & Co Ltd

At No 232.

via Sec.


Ship.

W. H. Pool. Report

No. 10687

HPL383-0024

DOCK DECK

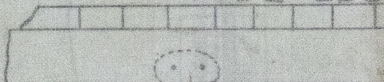

(side)



© 2020

Lloyd's Register
Foundation