


Furness Withy & Co.
Nos. 231 & 232



Collars at top of
deep tank

no. 232 - s.i. Chicago
w. N'pool. Report no. 1068

HPL383-0028

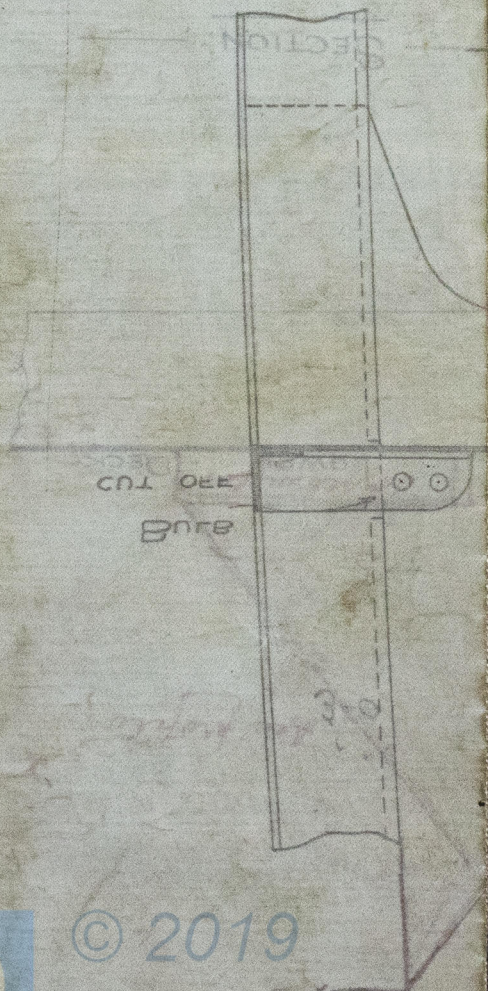

© 2019

Lloyd's Register
Foundation


9.3.97

S . S . N^o 231. + 232.


— WATERTIGHT LOWER DECK. —

— IN WAY OF DEEP TANK. —

— Scale 1/1000. —

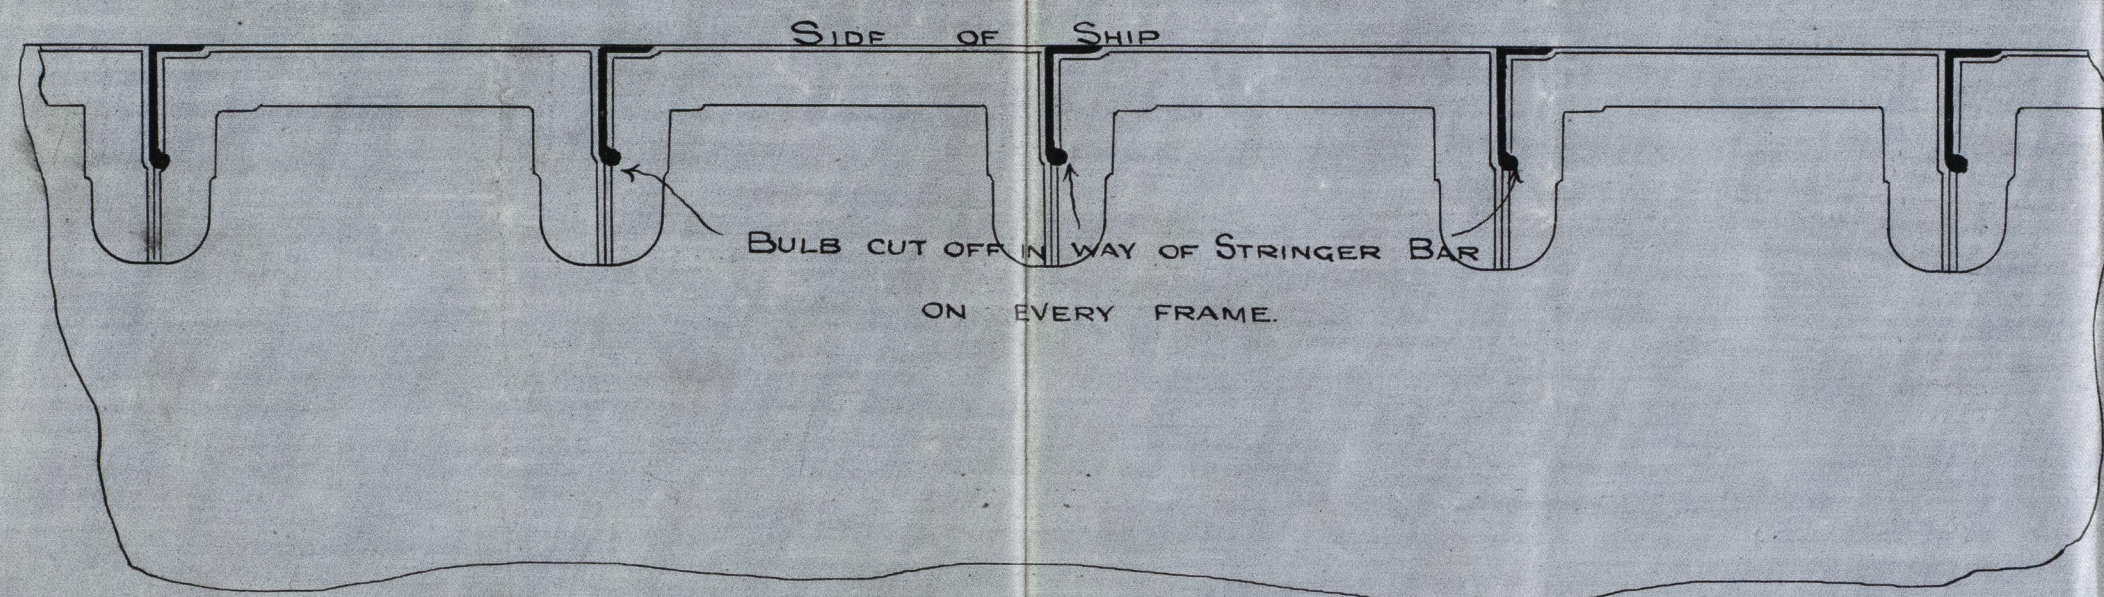

— PLAN OF LOWER DECK. —

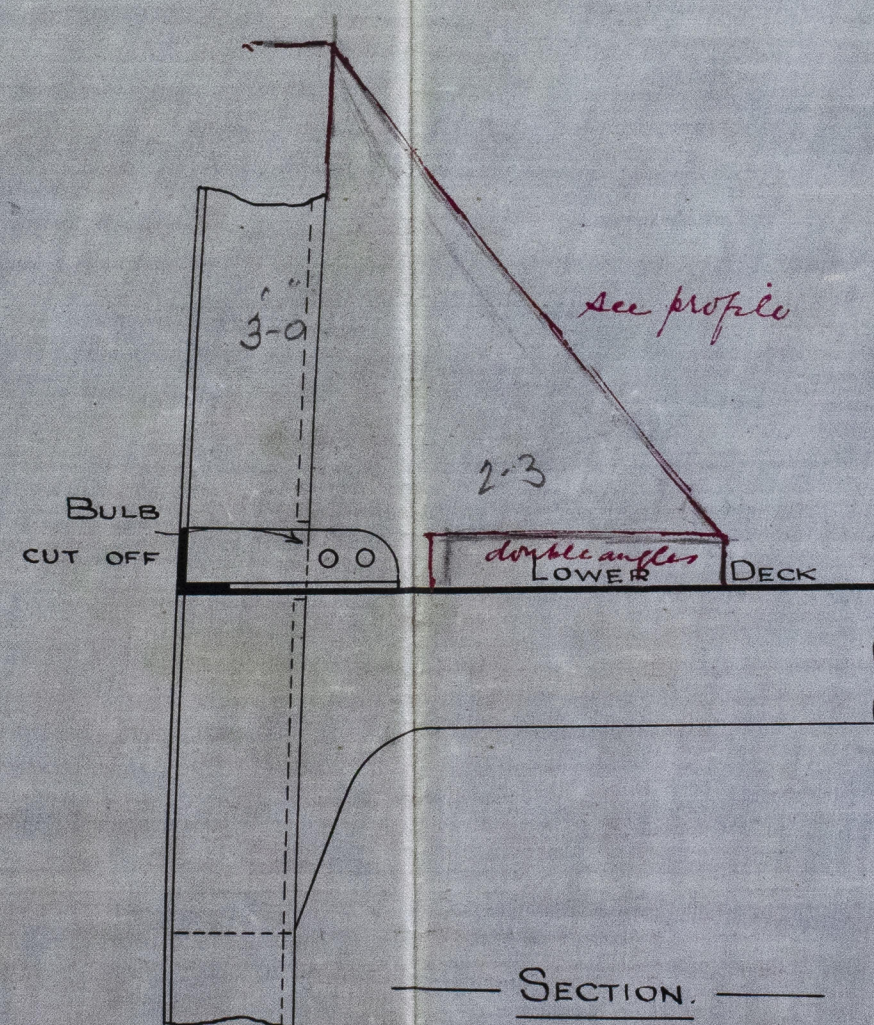

FURNESS, WITBY & CO. LIMITED
SHIPBUILDERS & REPAIRERS
WEST HARTLEPOOL

J.V.L.
9/3/97

5/3/97. S.W.D.