

Lloyd's Register of British and Foreign Shipping.

(Report on Vessel No. 10 709 Port WEST HARTLEPOOL)Hpool
No. 3833 a

SHIP FORGINGS OR CASTINGS.

I have to report that the undermentioned Iron or Steel Forgings or Castings,
 manufactured by The Darlington Forge Co.
 of Darlington for the Vessel No. 237, being built
 by Messrs Furness Withy & Co. of Hartlepool
 have been inspected by me as set forth below, and found to be, so far as can be seen,
sound


Mark on Forgings.

Lloyd's

No. 3833 aH.C.Rough CannonSunderland
31.8.98

	STERN FRAME.	RUDDER FRAME.	STEM.
Material* ...	<u>Scrap iron</u>	<u>Scrap iron</u>	<u>Scrap iron</u>
How made ...	<u>Forged</u>	<u>Forged</u>	<u>Forged</u>
Dimensions ...	<u>11" x 6 1/2"</u>	<u>9" x 4 7/8"</u>	<u>11" x 2 3/4"</u>
Progress on Inspection	<u>Smithed</u>	<u>Forged & smithed</u>	<u>Forged</u>
Date when Inspected	<u>March 11/98</u>	<u>May 5th to July 7/98</u>	<u>March 11/98</u>

SKETCHES OF FRAMES SHOWING POSITION AND DESCRIPTION OF WELDS OF FORGINGS, OR PARTICULARS OF TESTS APPLIED TO CASTINGS.

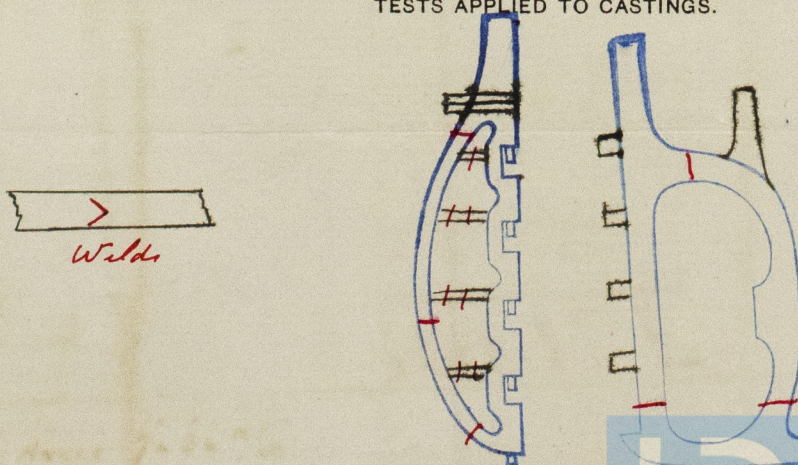

Fee (if any chargeable) £ : :

To be paid at

* If of Iron, state whether scrap or puddled Iron.