


30-7-98
12-8-98
20-8-98

PROFILE

SCALE $\frac{1}{8}$ IN. = ONE FOOT.

Beams marked A Bulbs $11 \times \frac{12}{20}$ single ang. $3\frac{1}{2} \times 3\frac{1}{2} \times \frac{9}{20}$.
" " B " $11\frac{1}{2} \times \frac{10}{20}$ or $11 \times \frac{12}{20}$ ang. $3\frac{1}{2} \times 3\frac{1}{2} \times \frac{9}{20}$. (Covering plates $24 \times \frac{6}{20}$ with large gussets)

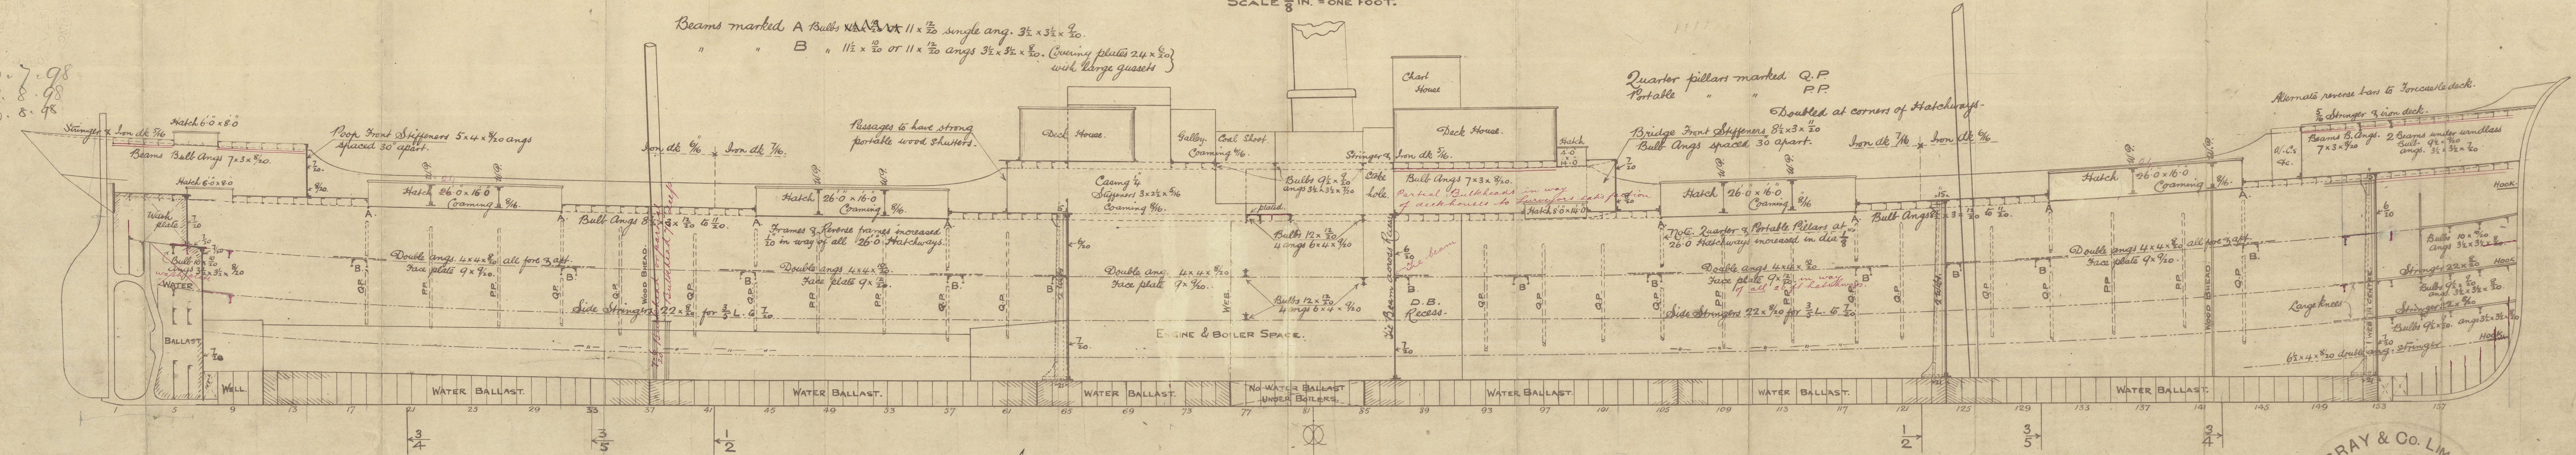

576

30-7-98
12-8-98

W. GRAY & Co. LIMITED
WEST HARTLEPOOL

© 2021
576
Lloyd's Register
Foundation
HPL384-0063



W Gray & Co.
No. 576.

Profile

ss "Raitkwaite"
W. H'pool. Report
No. 10802.

HPL384 - 0063



© 2021

Lloyd's Register
Foundation