


W. Gray 176. 112
No. 576

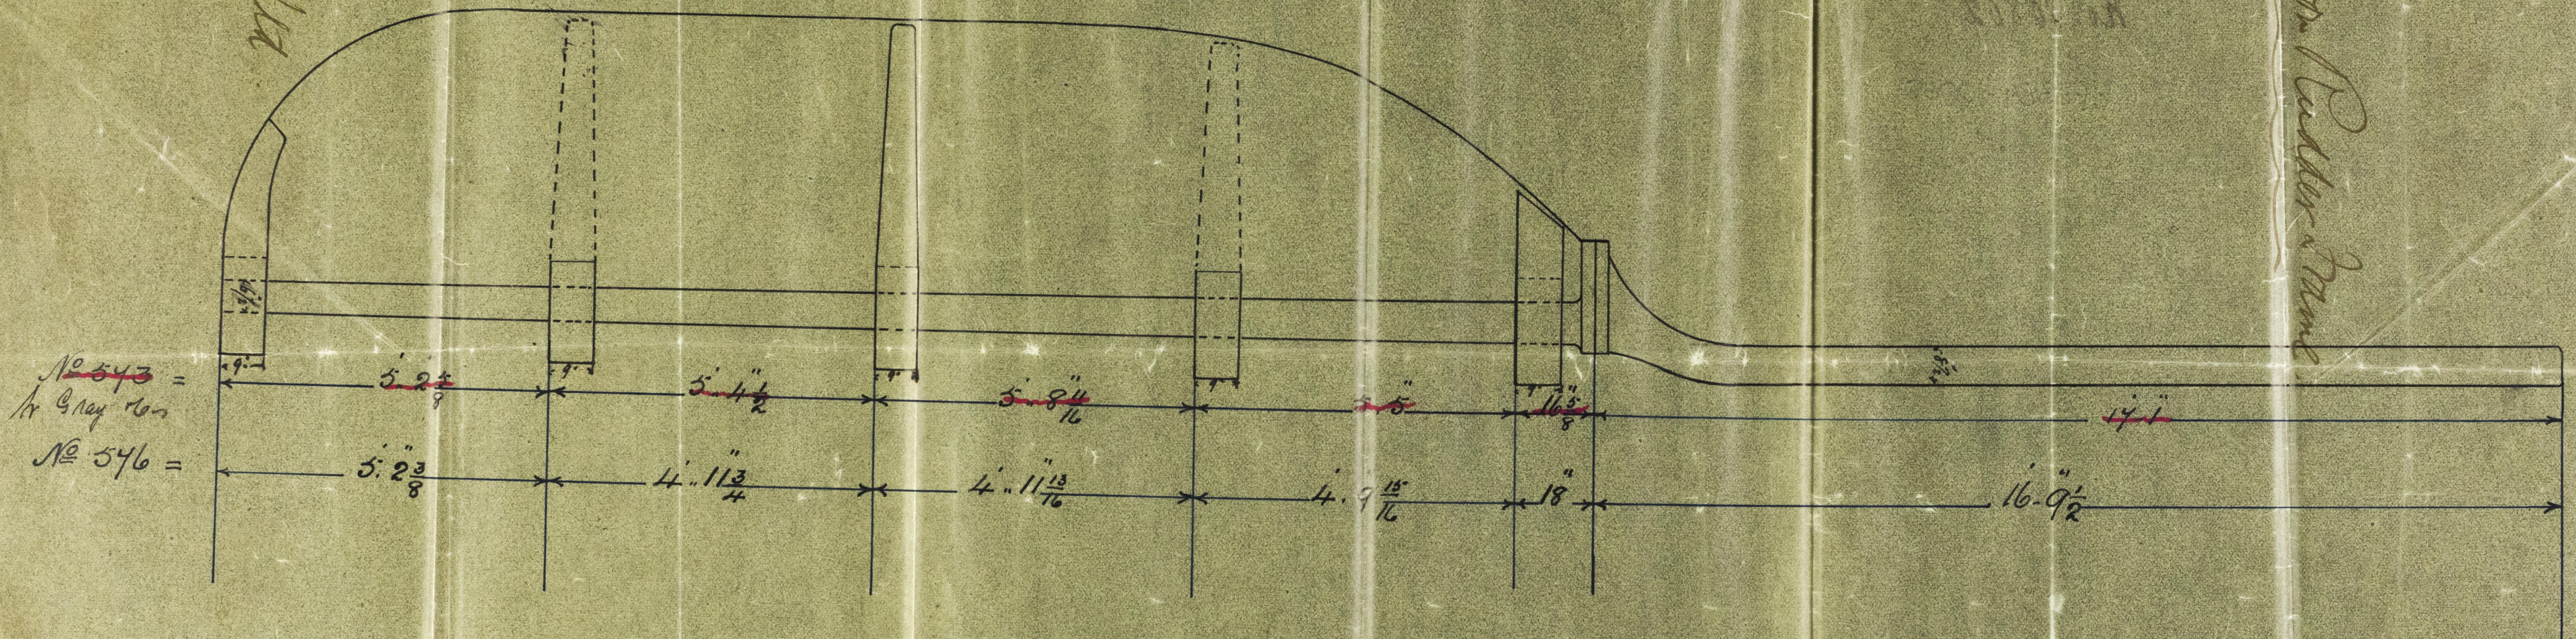

The Rudder Frame for No. 546 is made according to the plan approved for No. 543, only the distances between the gudgeons are less than 543.

W. Gray 176
No. 576
W. Gray 176
No. 576

W. Gray 176
No. 576

576
576

Wfray No.

No. 576.

Single plate rudder

s.s. "Raitkwaite"

W. It pool. Report

No. 10802

HPL384-0065



© 2019

Lloyd's Register
Foundation