

## Lloyd's Register of British and Foreign Shipping.

(Report on Vessel No. 10810 Port WEST HARTLEPOOL.)

Wpool  
No. 3864 A. SHIP FORGINGS OR CASTINGS. and S.S. "Degama"

I have to report that the undermentioned Iron <sup>and</sup> or Steel Forgings <sup>and</sup> or Castings,  
 manufactured by Robt. Read & Co. & The Darlington Forge Co.

of Stockton & Darlington for the Vessel No. 240, being built

by Furness Brothers Co. of Hartlepool

have been inspected by me as set forth below, and found to be, so far as can be seen,

sound. The Rudder has been tested as required by the  
Rules and found satisfactory

Mark on Forgings.

Lloyd's

No. 3864 A

No. 6.

Hugh Cameron


Sunderland

10. 10. 98

|                        | STERN FRAME.  | RUDDER FRAME.                        | STEM.               |
|------------------------|---|--------------------------------------|---------------------|
| Material*              | <u>Scrap</u>  | <u>Siemens Steel</u>                 | <u>Scrap</u>        |
| How made               | <u>Forged</u>   | <u>Cast</u>                          | <u>Forged</u>       |
| Dimensions             | <u>11' + 6 1/2"</u>   | <u>As per plan attached</u>          | <u>11' + 2 3/4"</u> |
| Progress on Inspection | <u>-</u>  | <u>Cast tested</u>                   | <u>Forged</u>       |
| Date when Inspected    | <u>Forged Smithed</u><br><u>May 16<sup>th</sup> to July 28/98</u> | <u>July 27. Aug 12. Sept 9-21/98</u> | <u>July 13/98</u>   |

SKETCHES OF FRAMES SHOWING POSITION AND DESCRIPTION OF WELDS OF FORGINGS, OR PARTICULARS OF  
 TESTS APPLIED TO CASTINGS.

Welds

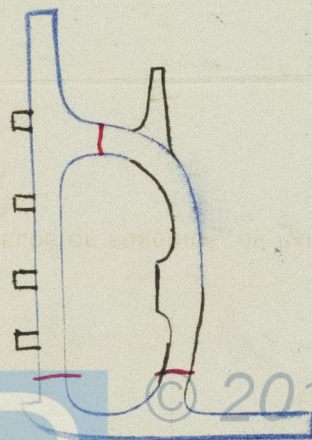

Fee (if any chargeable) £ : :

To be paid at

\* If of Iron, state whether scrap or puddled Iron.