


WORKING PRESS - 170 LBS TO LLOYDS SURVEY.


Shell plates to have an ultimate tensile strength of 24 to 30 tons

Main stays 27 to 32


Other plates & stays	"	"	"	"	"	"	"	26 to 30
----------------------	---	---	---	---	---	---	---	----------

 

N^o 578.

16 - 6 Centres

HPL384-0233

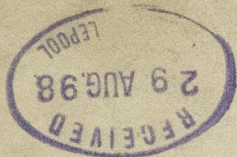

W. Gray & Co.

S.S. N^o 578


2. Steel Boilers

by

Central Maine Engine Works.

170. lbs W. P.

29-8-98.

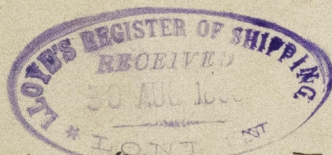

S.S. "Diredale"

2677

Sturdy test

3440 lbs

1887

24-3-99

W. H. pool. Report

No. 10859



© 2021

The
Lengih.

15-3

10-3

Lloyd's Register

Foundation

HP 2384-0233

1578.