


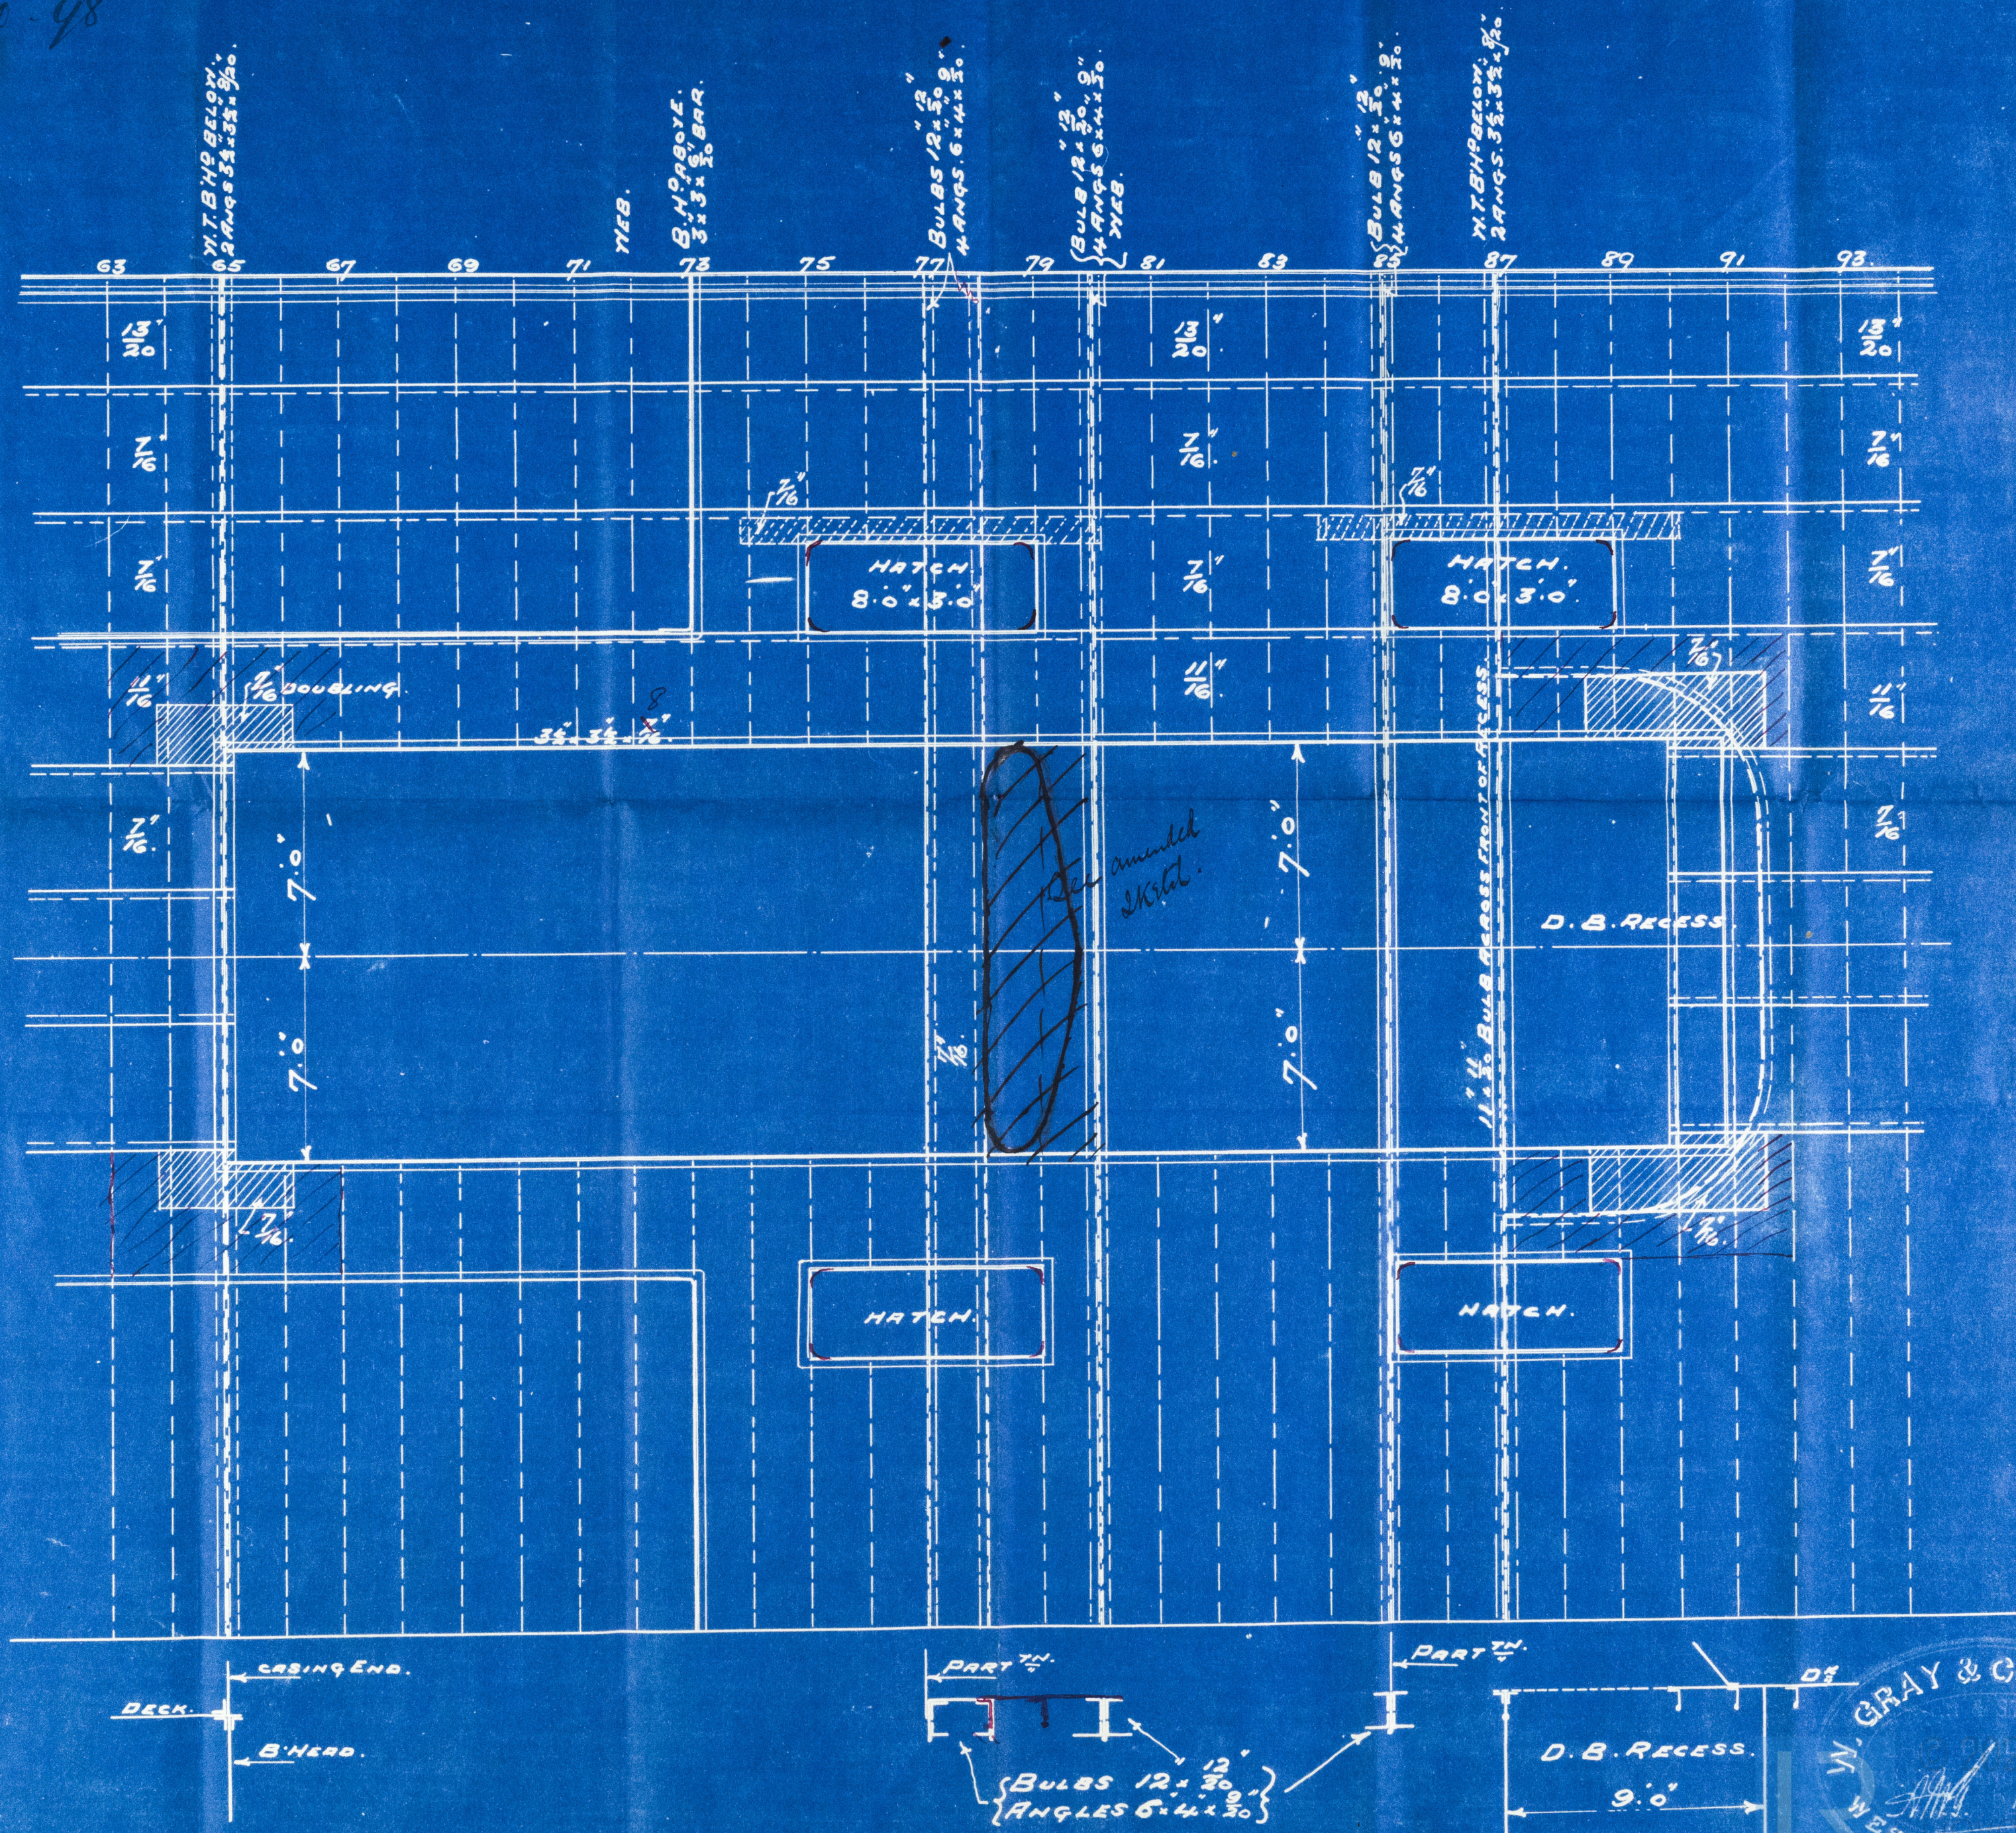

24.10.98

S. S. No 578.  
PART UPPER DECK PLAN SHEWING  
OPENINGS IN WAY OF MACHINERY.  
SCALE  $\frac{1}{4}$  = ONE FOOT.



J.F.L.  
24/10/98

WPL384-0235






W Bay & Co.  
No. 578.

Deck Plan  
in way of E & B space.  
s.s. "Airedale"  
W. H. Pool. Report  
No. 10859

HIPL384-0235

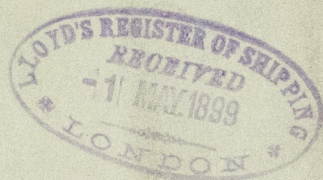

© 2021

Lloyd's Register  
Foundation