



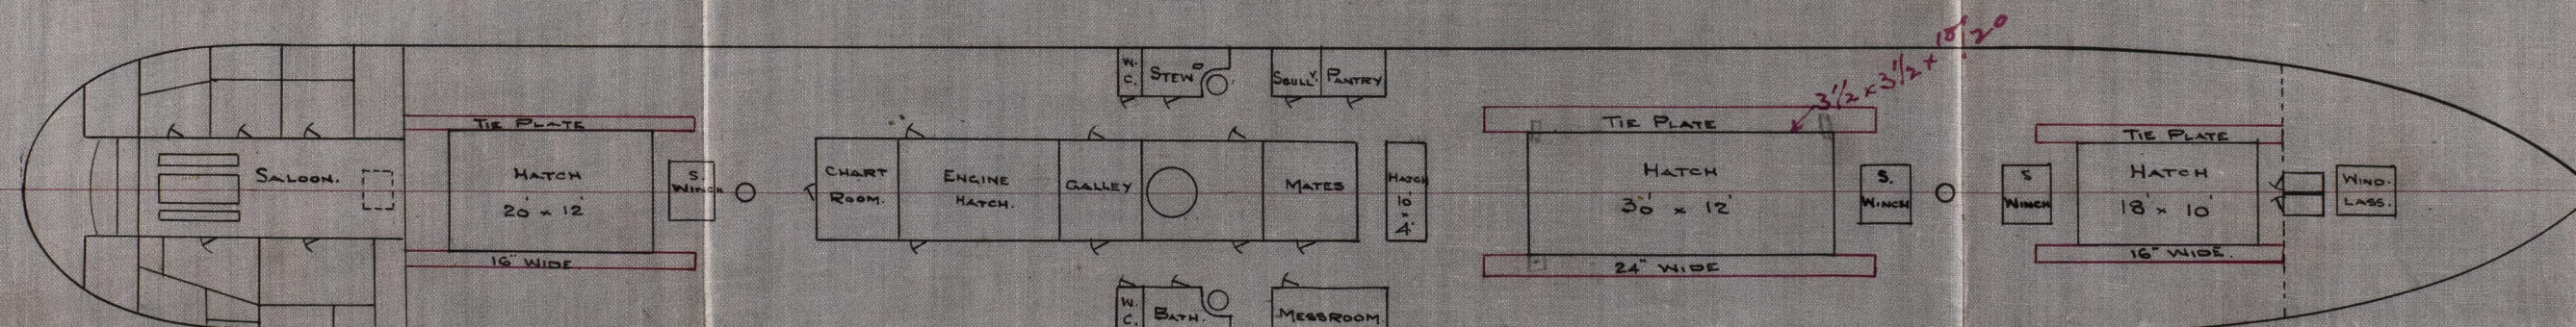

25.11.98

S.S. "JOHN PENDER"

SCALE $\frac{1}{16}$ " = 1 FOOT.

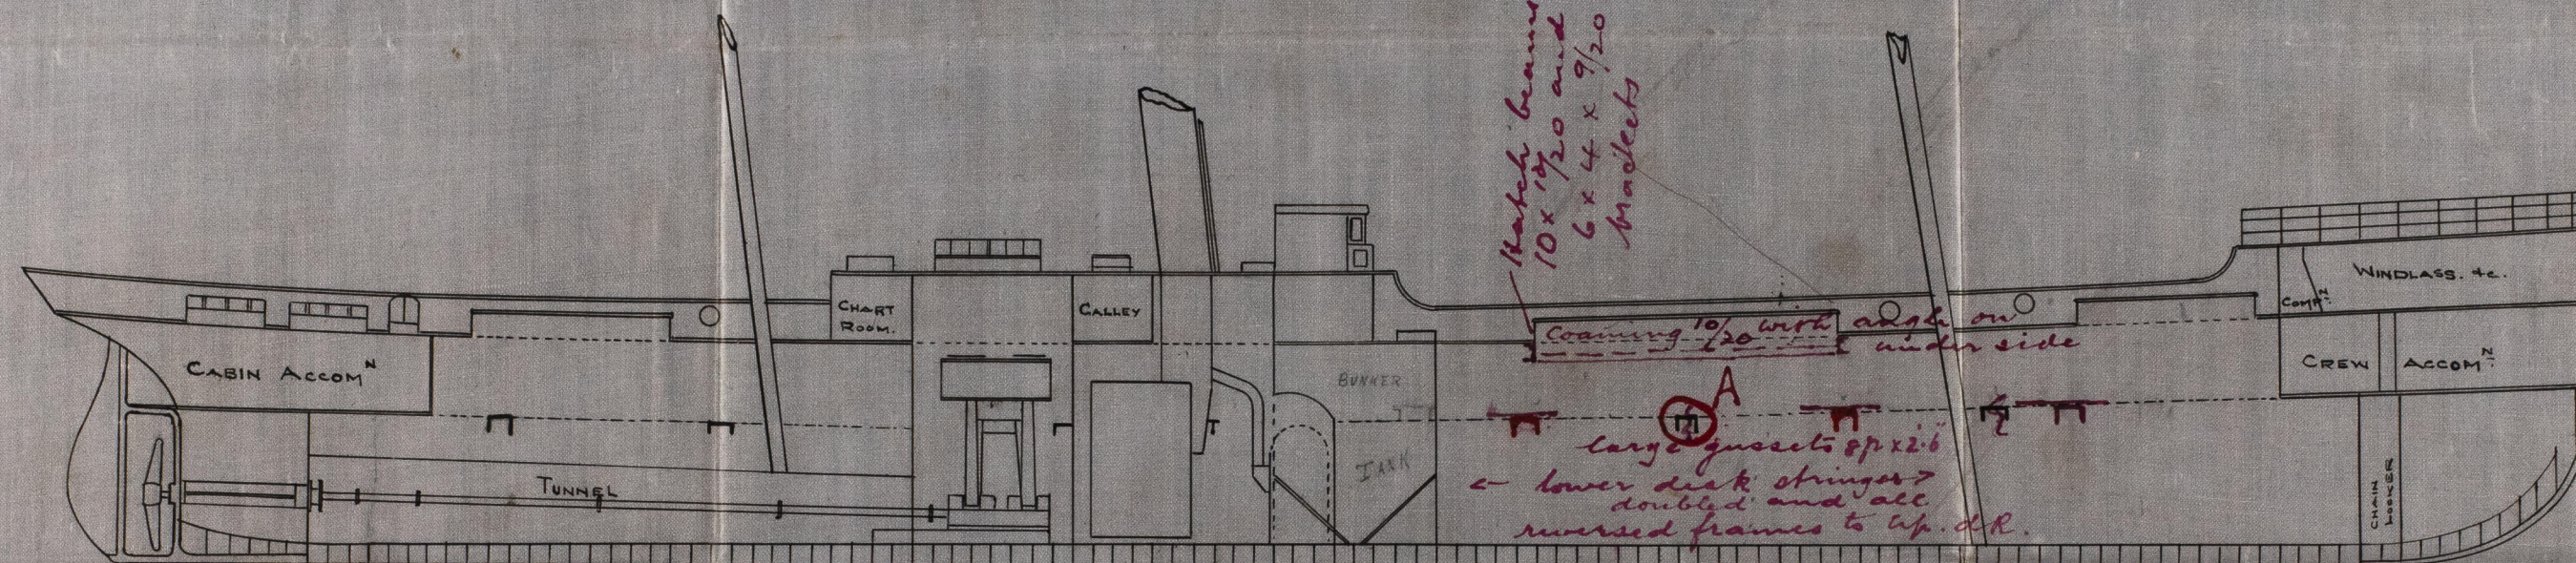

Lloyd's Register Foundation

HPL 385-0030




S.S. John Pender

24.11.98.



W. H. Pool. Report
no. 10 888

WPL385-0080

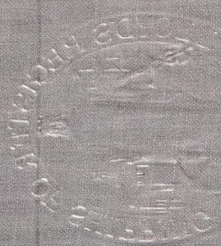

S.S. JOHN PENDER

Scale 1/2 inch = 1 foot

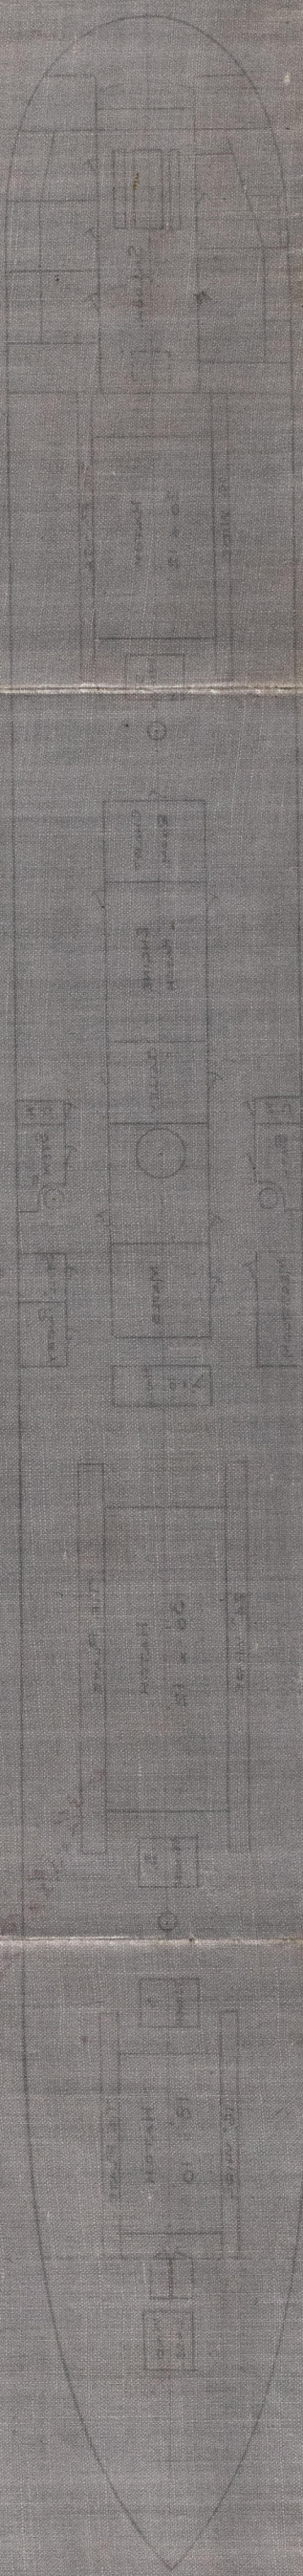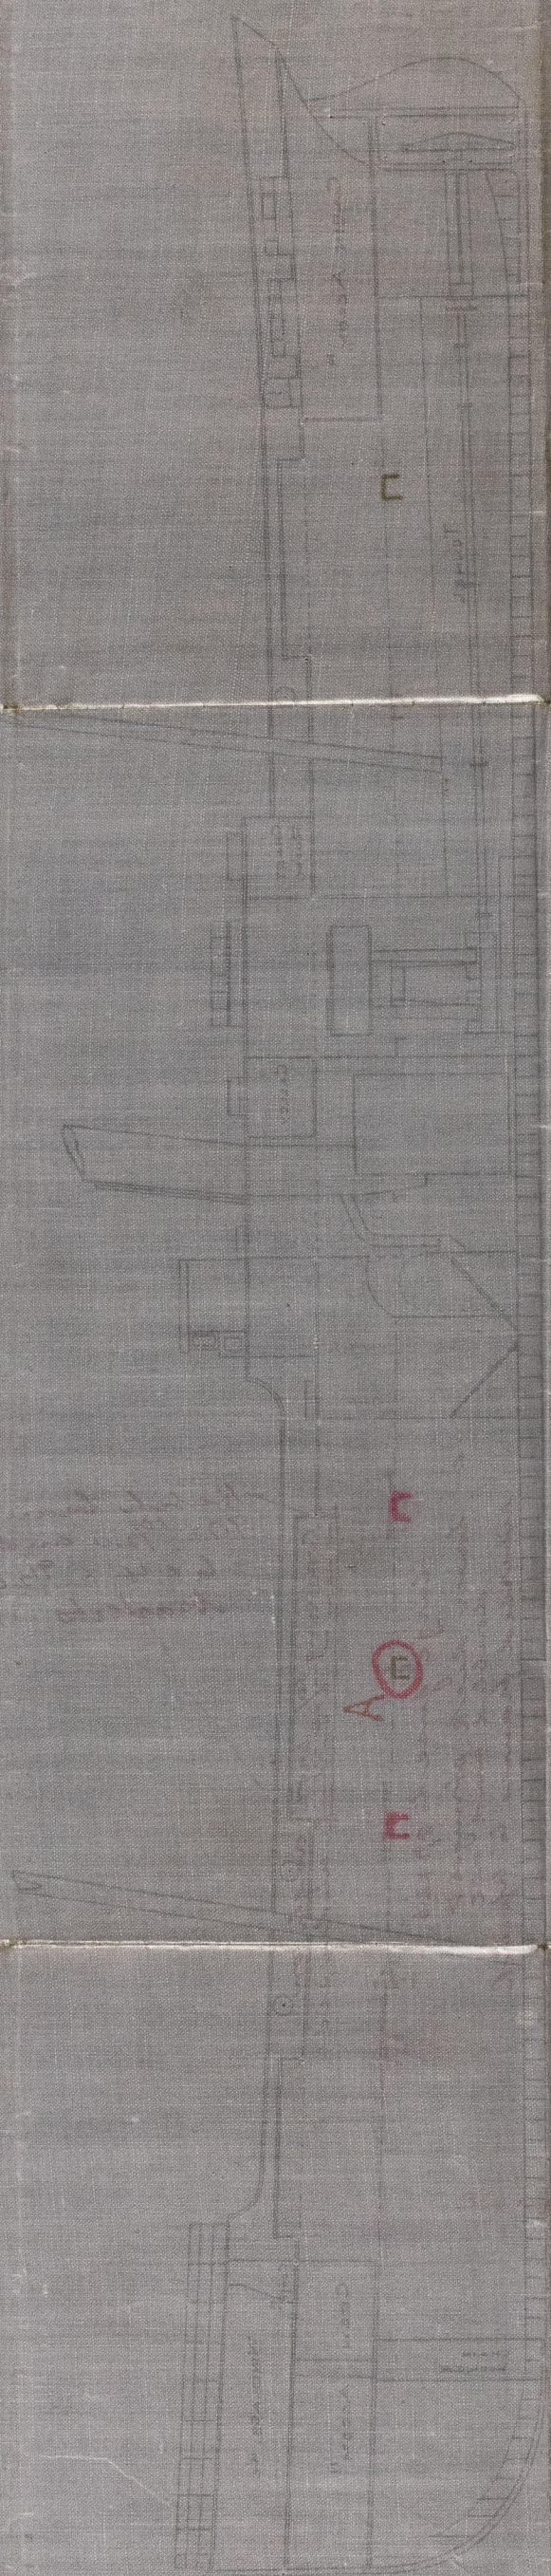

24/11/98
P. H. J.



© 2020

Lloyd's Register
Foundation