


Iron S. S. Walton Report No. 11,600

Rev 12/1/77

LENGTH PER RULE ..... 216' 9"  
BREADTH ..... Do ..... 30' 10"  
DEPTH TO TOP FLOORS 17' 6"  
CLASSIFICATION ..... 100 A

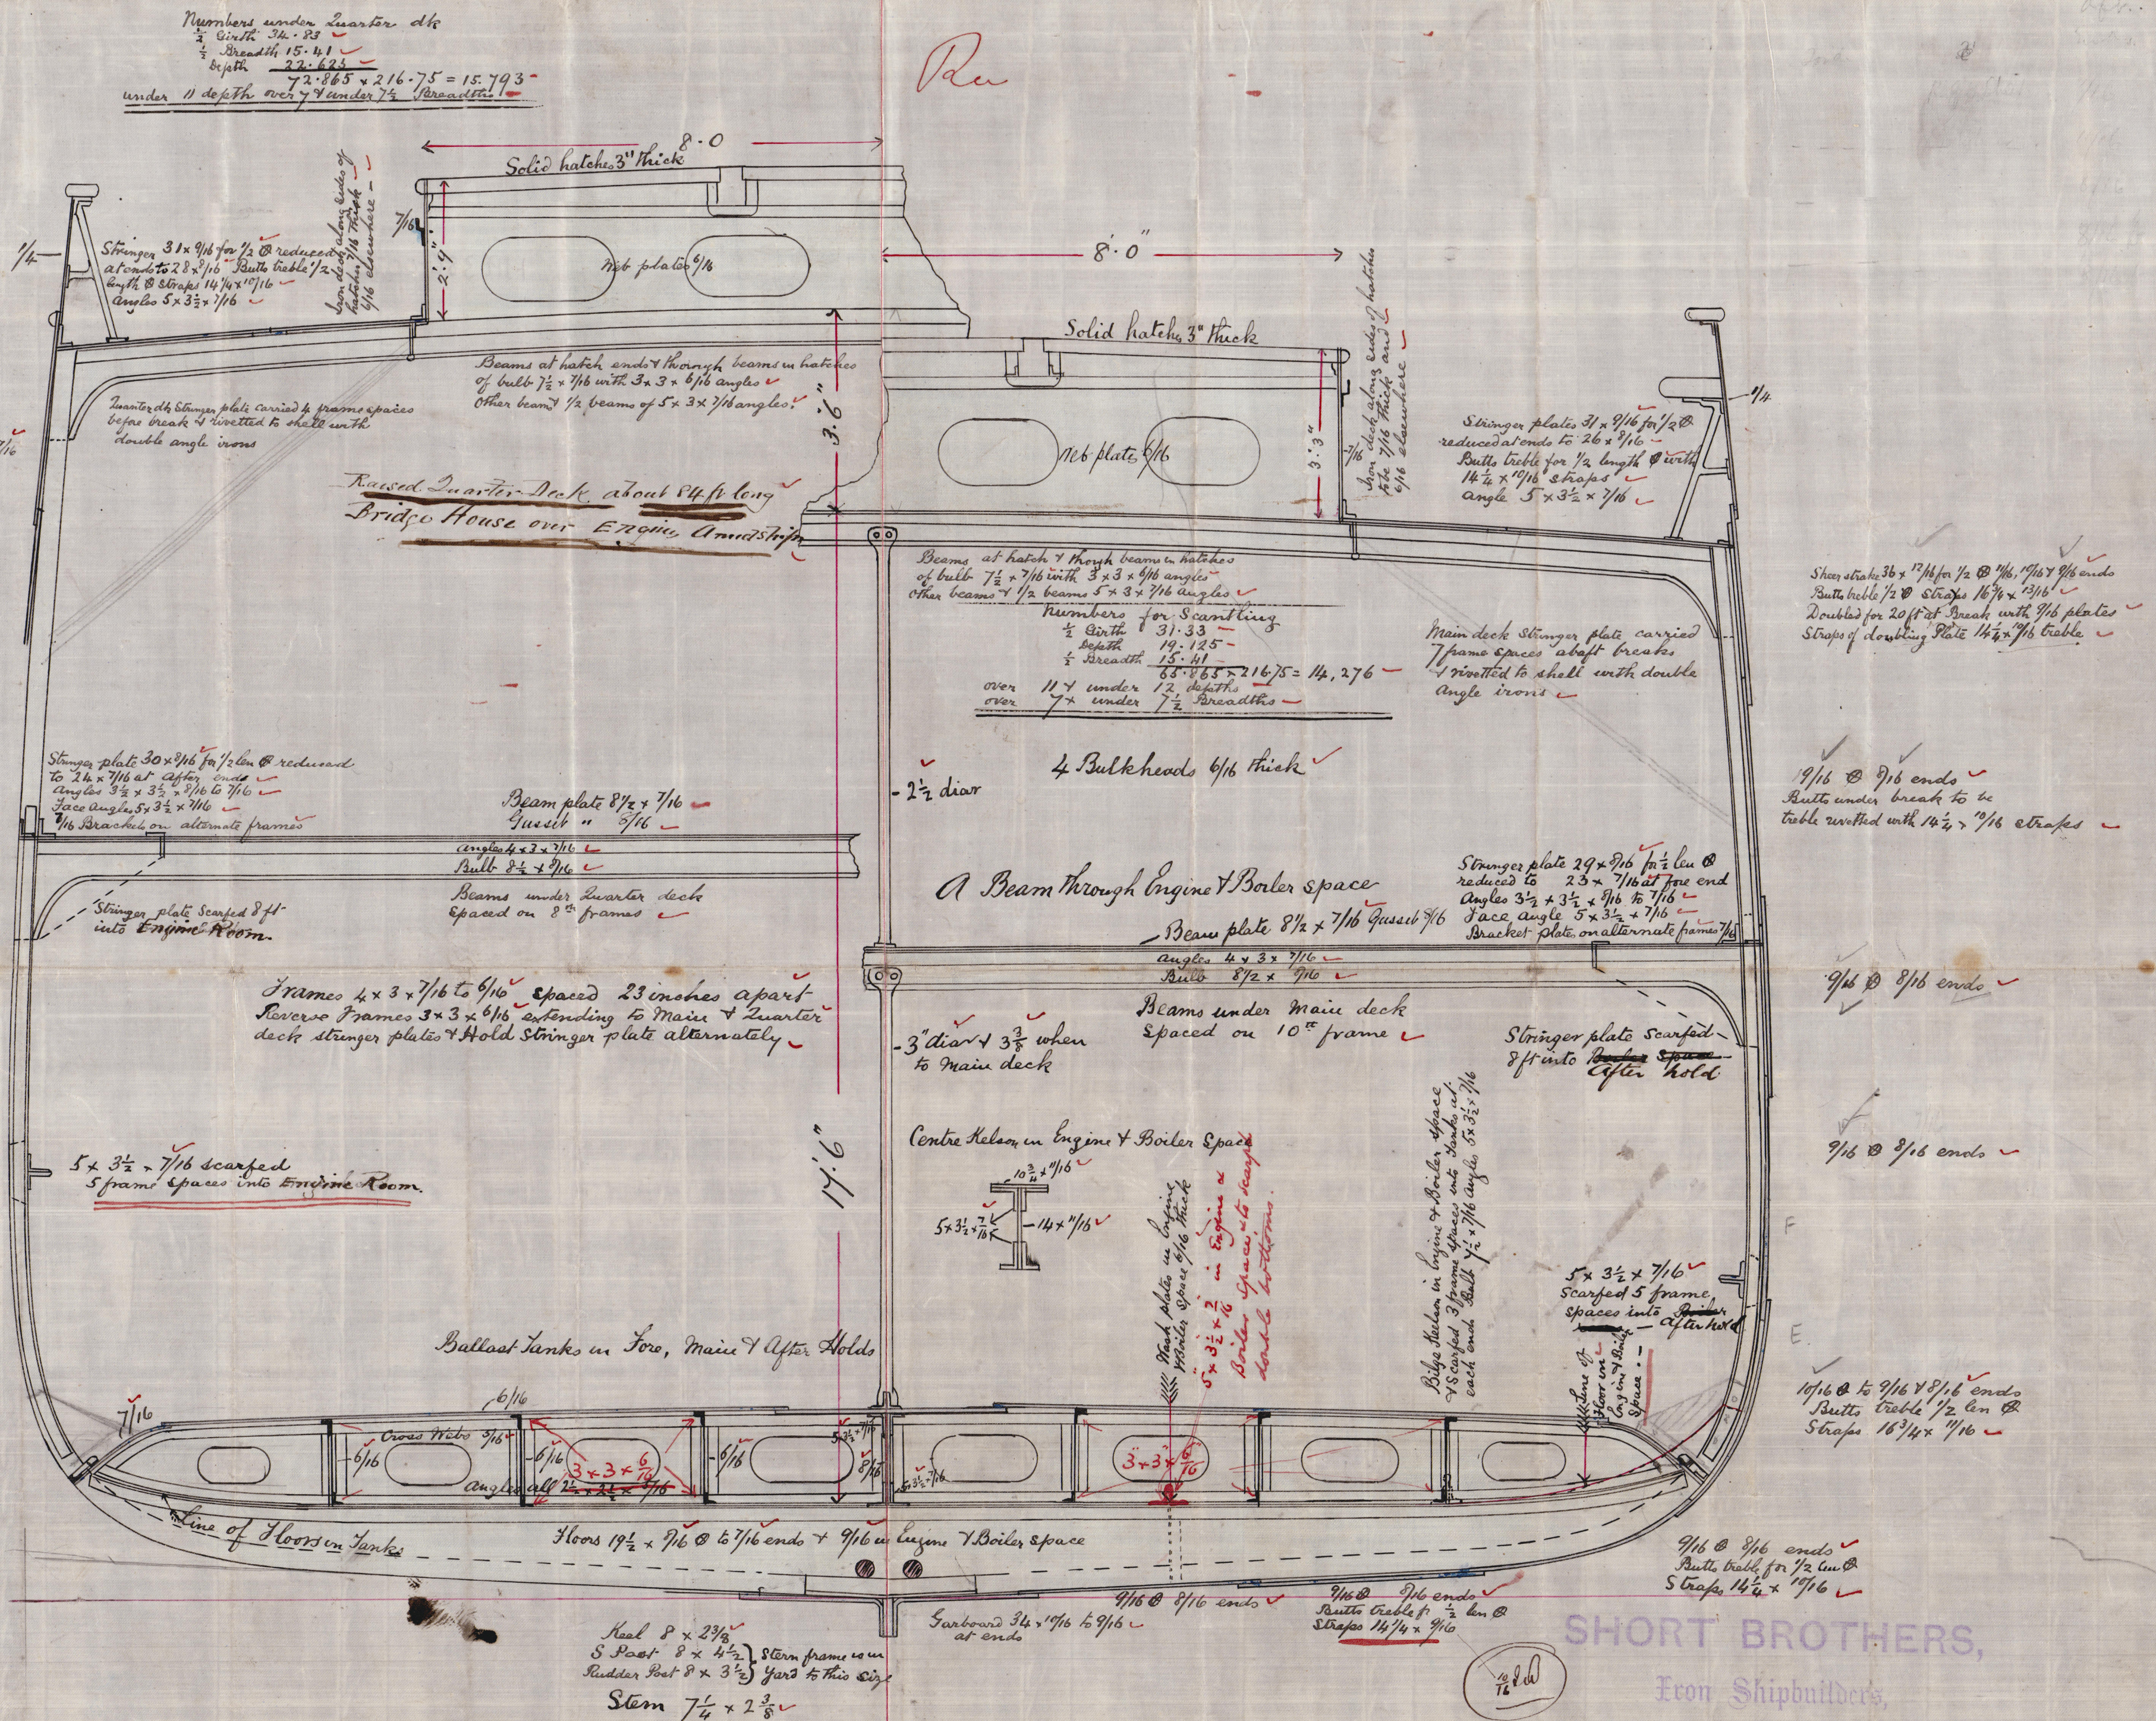

SUNDERLAND

© 2020

Lloyd's Register  
Foundation

HPL 386-0075