



30.9.98

ARRANGEMENT OF STRINGERS & C IN WAY OF BOILERS

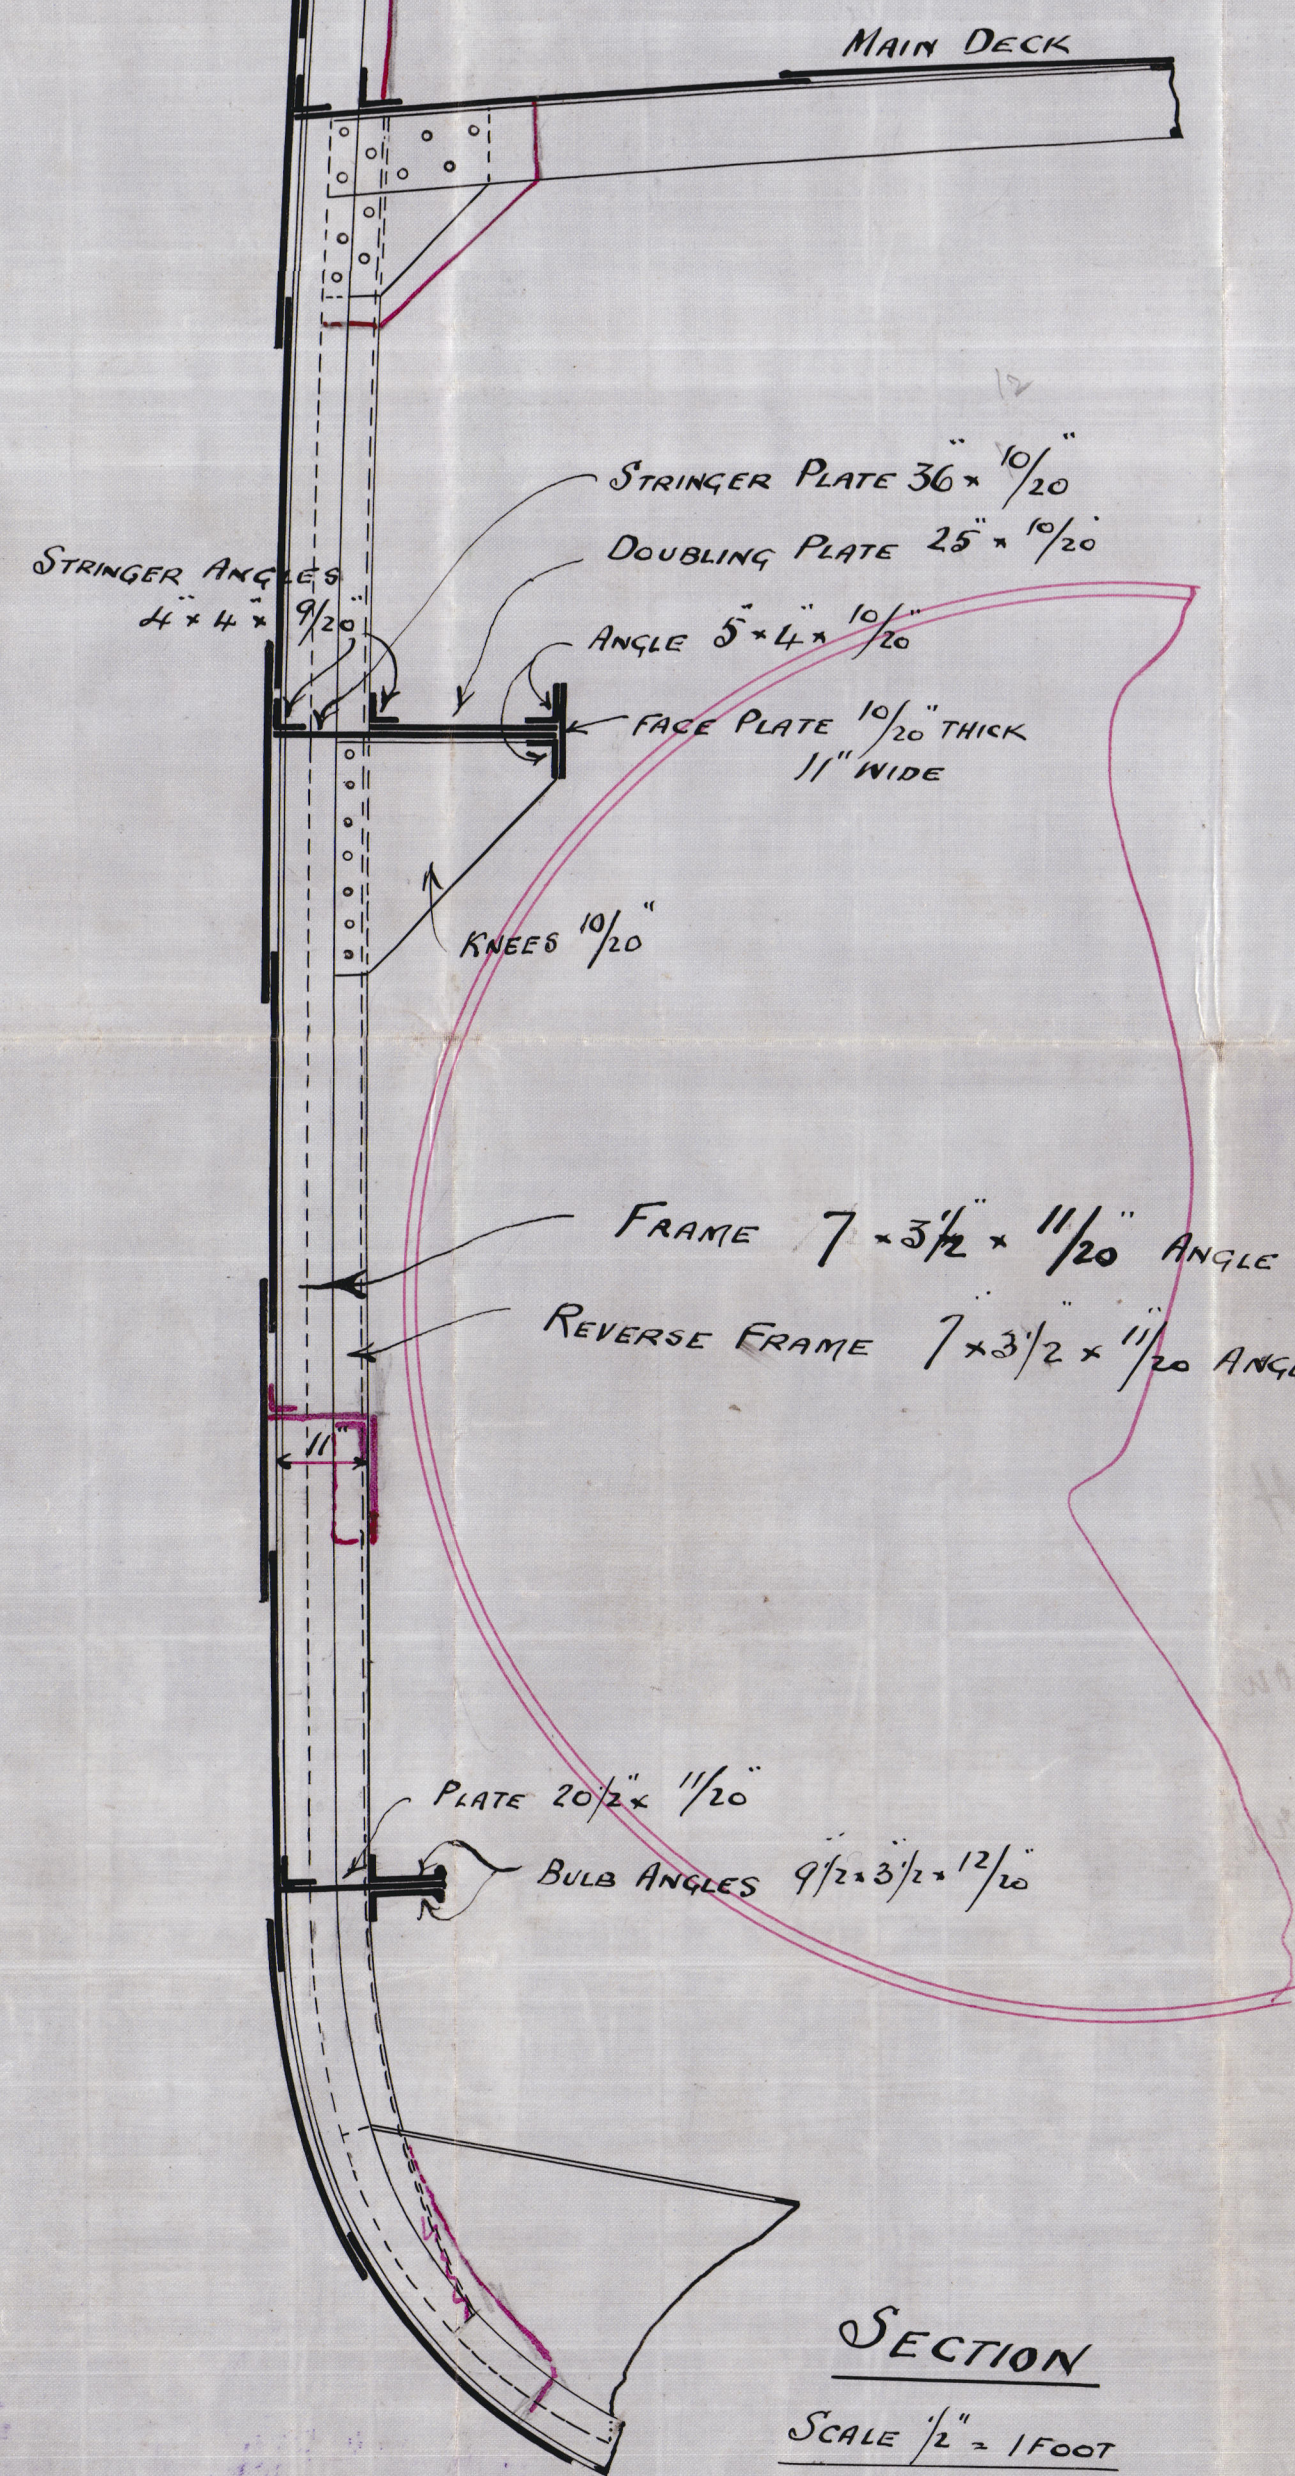

SECTION
SCALE 1/2" = 1 FOOT

N^{os} 243 & 4

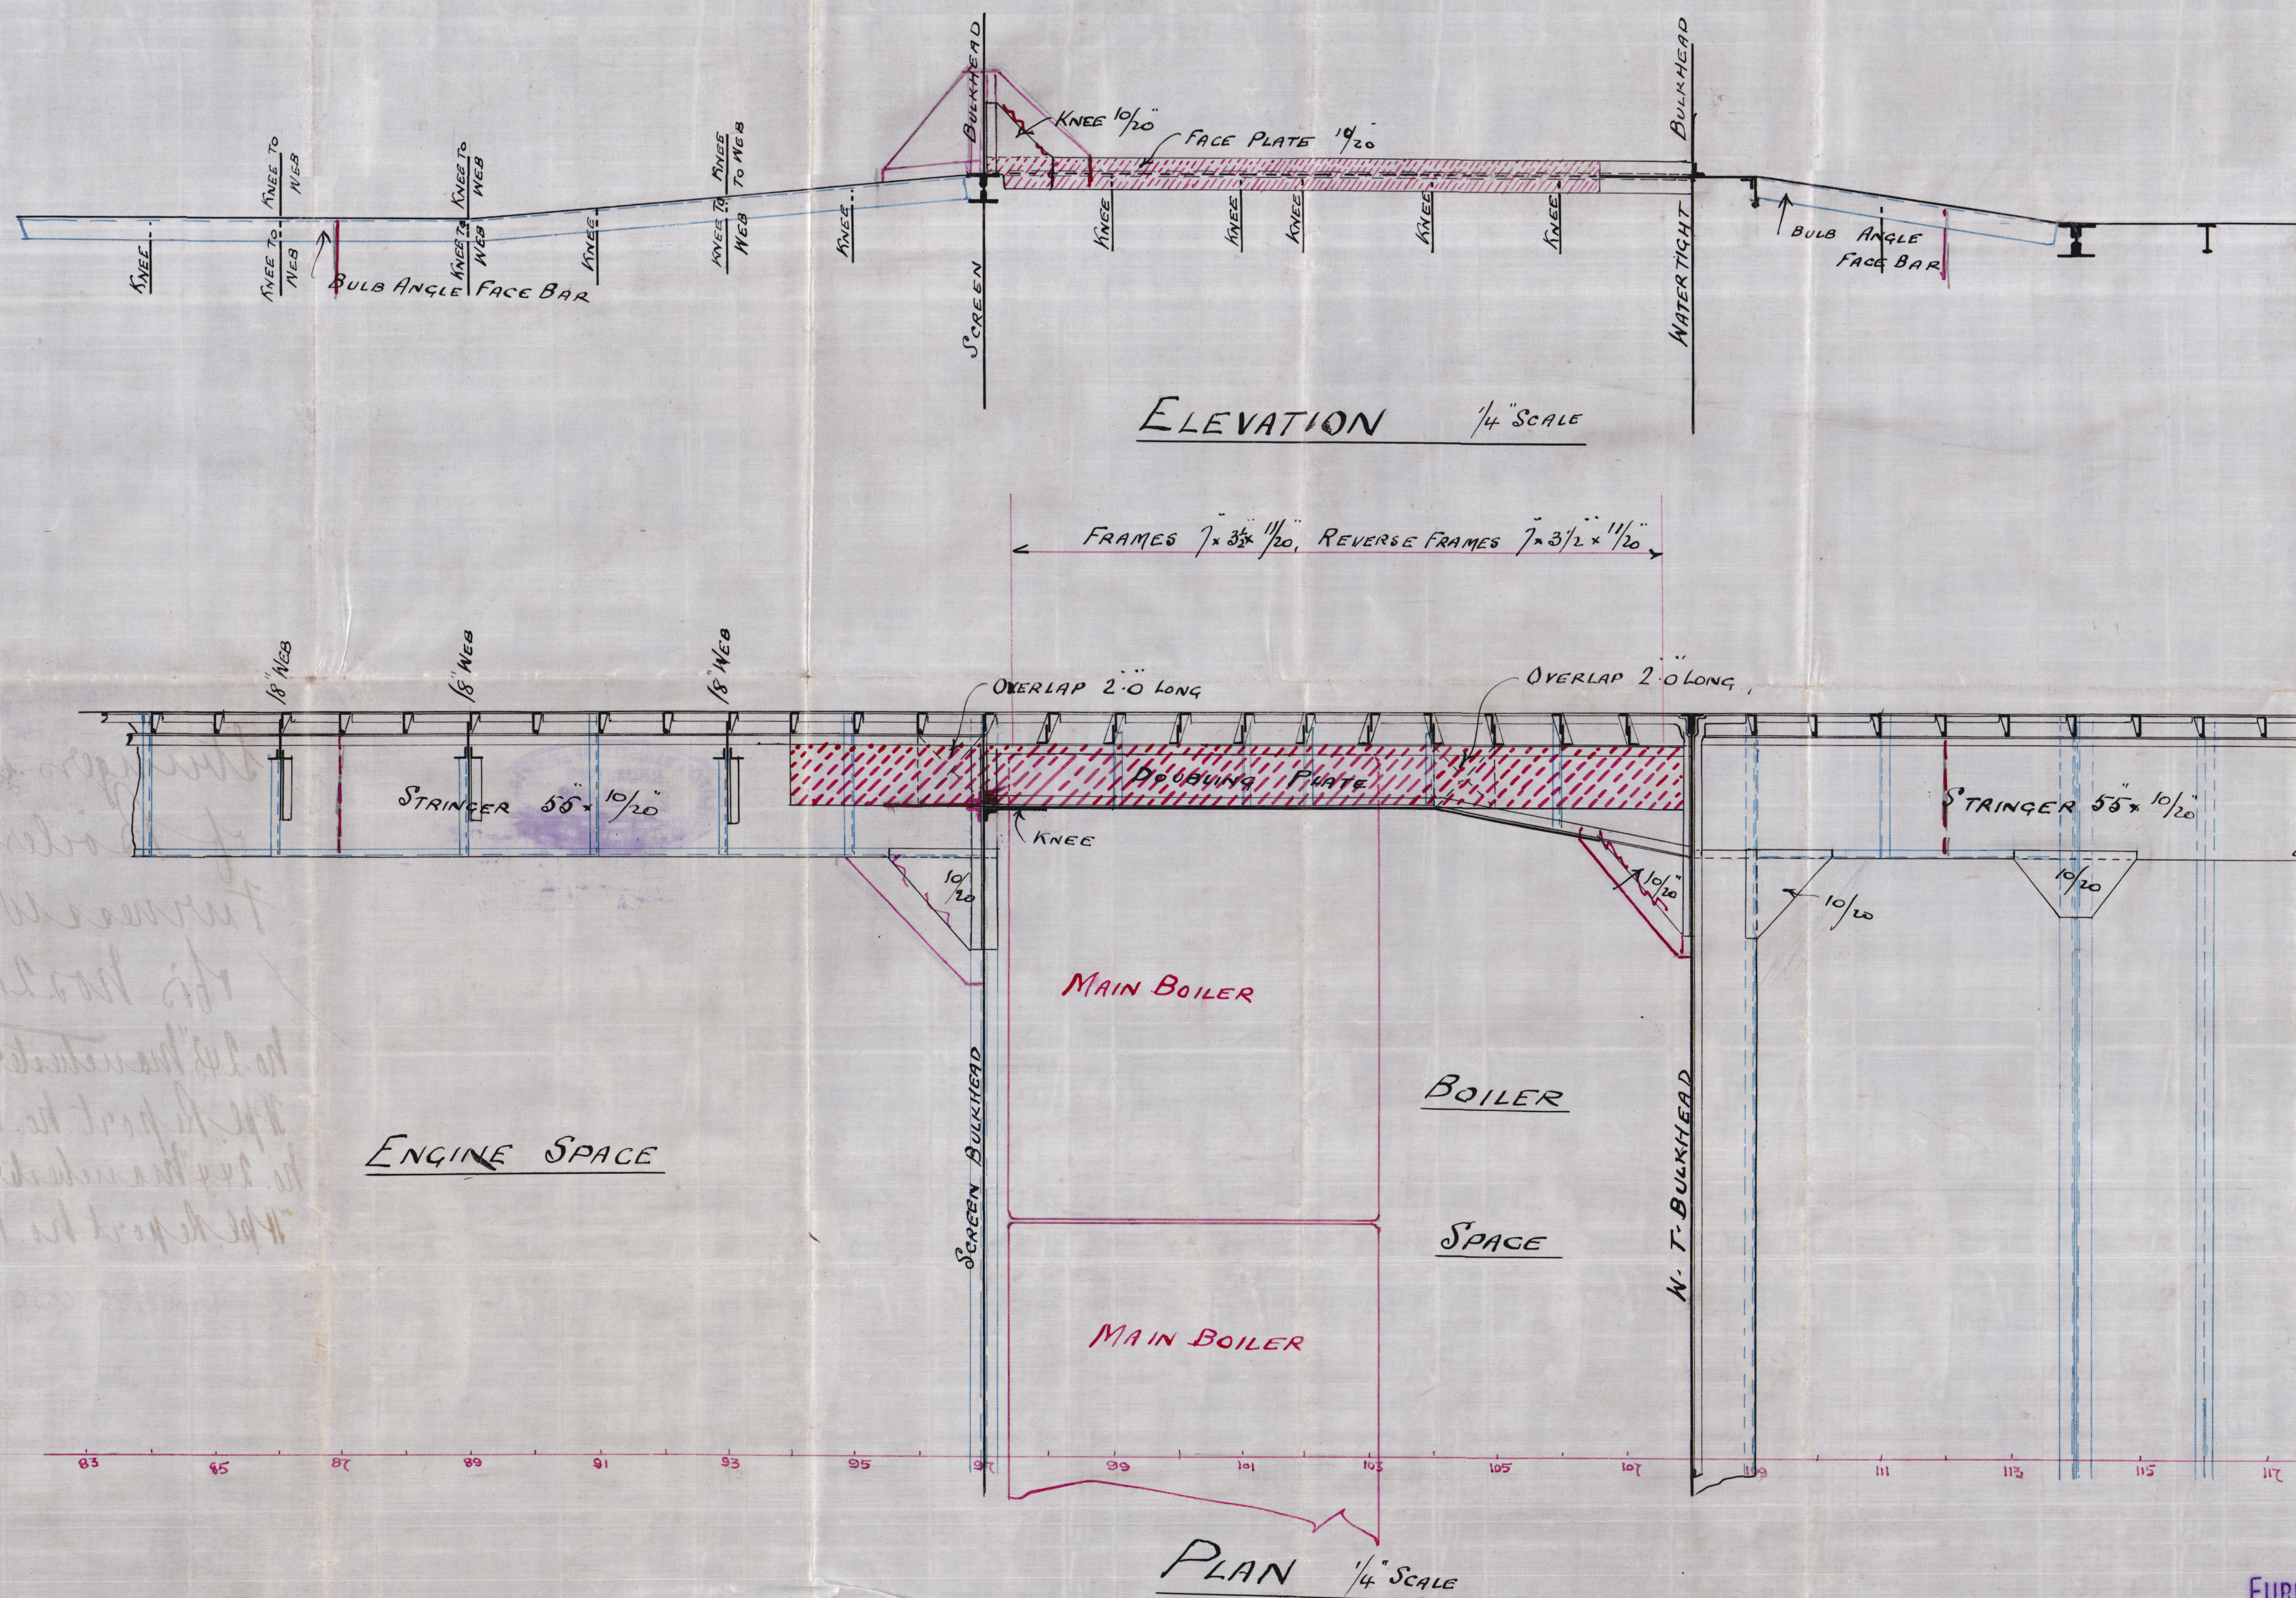

ELEVATION 1/4" SCALE

PLAN 1/4" SCALE

48
30.9.98

FURNESS, WITHEY & CO. LIMITED.
SHIPBUILDERS & REPAIRERS,
WEST HARTLEPOOL.

27th Sept 1898.



Stringers in way
of Boilers
Furness Withy
his nos 243 & 244
no. 243 "Manchester Corporation"
Hpl. Report no. 11003
no. 244 "Manchester Commercial"
Hpl. Report no. 11052

HPL 386-6250



© 2020

Lloyd's Register
Foundation