



*See plan
25.10.49*

12
W. S. S. C. L. A. M.
SECTION THRO COAL BUNKERS
SCALE $\frac{1}{4}$ " = ONE FOOT

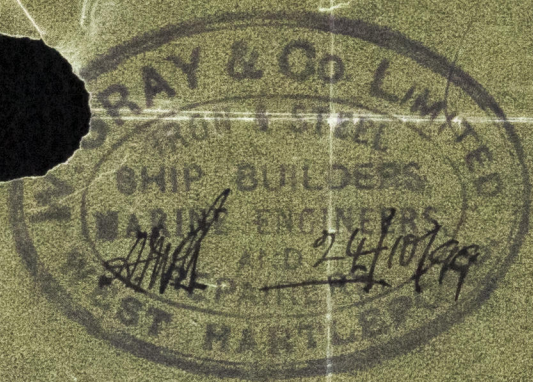

HPL387-0131

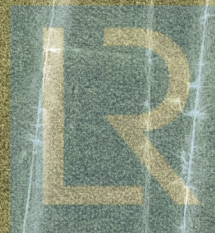

© 2020
Lloyd's Register
Foundation

S. S. Clam
Protection of under
Side of Supply
Lanes



© 2020

Lloyd's Register
Foundation