

For the information of Surveyors and the Committee only.

Received at W. Hartlepool Office. 12. 8. 1899

Lloyd's Register of British and Foreign Shipping.

W. Hartlepool (Report on Vessel No. 11052 Port W. Hartlepool)
"Manchester Commerce"

No. 3922 a SHIP FORGINGS OR CASTINGS.

The words FORGINGS or CASTINGS, IRON or STEEL, should be struck out as may be required.

I have to report that the undermentioned Iron or ~~Steel~~ Forgings or Castings, manufactured by The Darlington Forge Co. of Darlington for the Vessel No. 244, being built by Messrs Furness Brothers & Co. of Hartlepool have been inspected by me as set forth below, and found to be, so far as can be seen, sound

Mark on Forgings.


Lloyd's
No. 3922 a
No. 6

Wm. Cannon

Surveyor General
11/8/99

	STERN FRAME.	RUDDER FRAME.	STEM.
Material*	<u>Scrap Iron</u>	<u>Scrap Iron</u>	<u>Scrap Iron</u>
How made	<u>Forged</u>	<u>Forged</u>	<u>Forged</u>
Dimensions	<u>12 x 7 3/4</u>	<u>10 1/2 - 5 1/4</u>	<u>12 x 3 3/8</u>
Progress on Inspection	<u>Forged & Smithed</u>	<u>Forged & Smithed</u>	<u>Forged</u>
Date when Inspected	<u>January 8th to Feb'y 27/99</u>	<u>April 7th to July 10/99</u>	<u>April 12/99</u>

SKETCHES OF FRAMES SHOWING POSITION AND DESCRIPTION OF WELDS OF FORGINGS, OR PARTICULARS OF TESTS APPLIED TO CASTINGS.

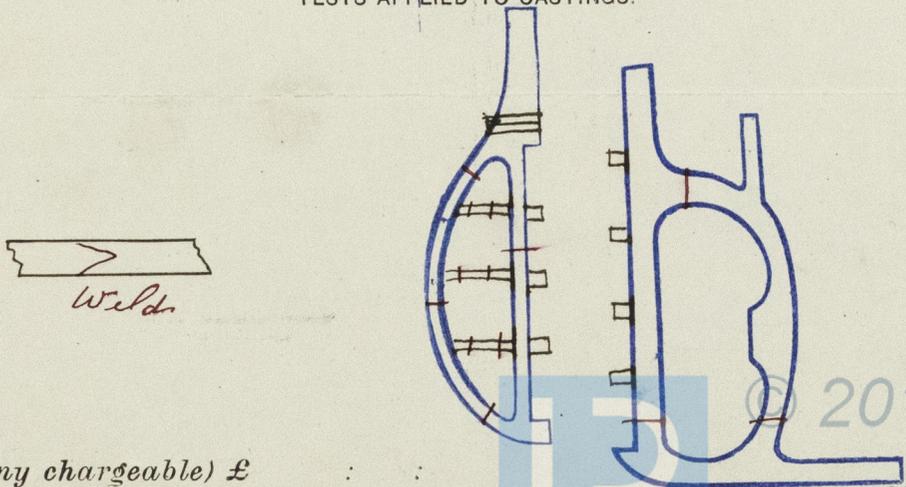

Fee (if any chargeable) £

To be paid at

* If of Iron, state whether scrap or puddled Iron.

