

MIDSHIP SECTION

SCALE 2" = 1' FOOT

430' x 48' x 34'-ODM


BRIDGE DECK

STRINGER PLATE 60 x 7/20

STRINGER ANGLE 3 1/2 x 3 1/2 x 7/20

BEAMS ON EVERY FRAME 6 1/2 x 3 x 7/20 BULB ANGLES

IRON DECK 5/16

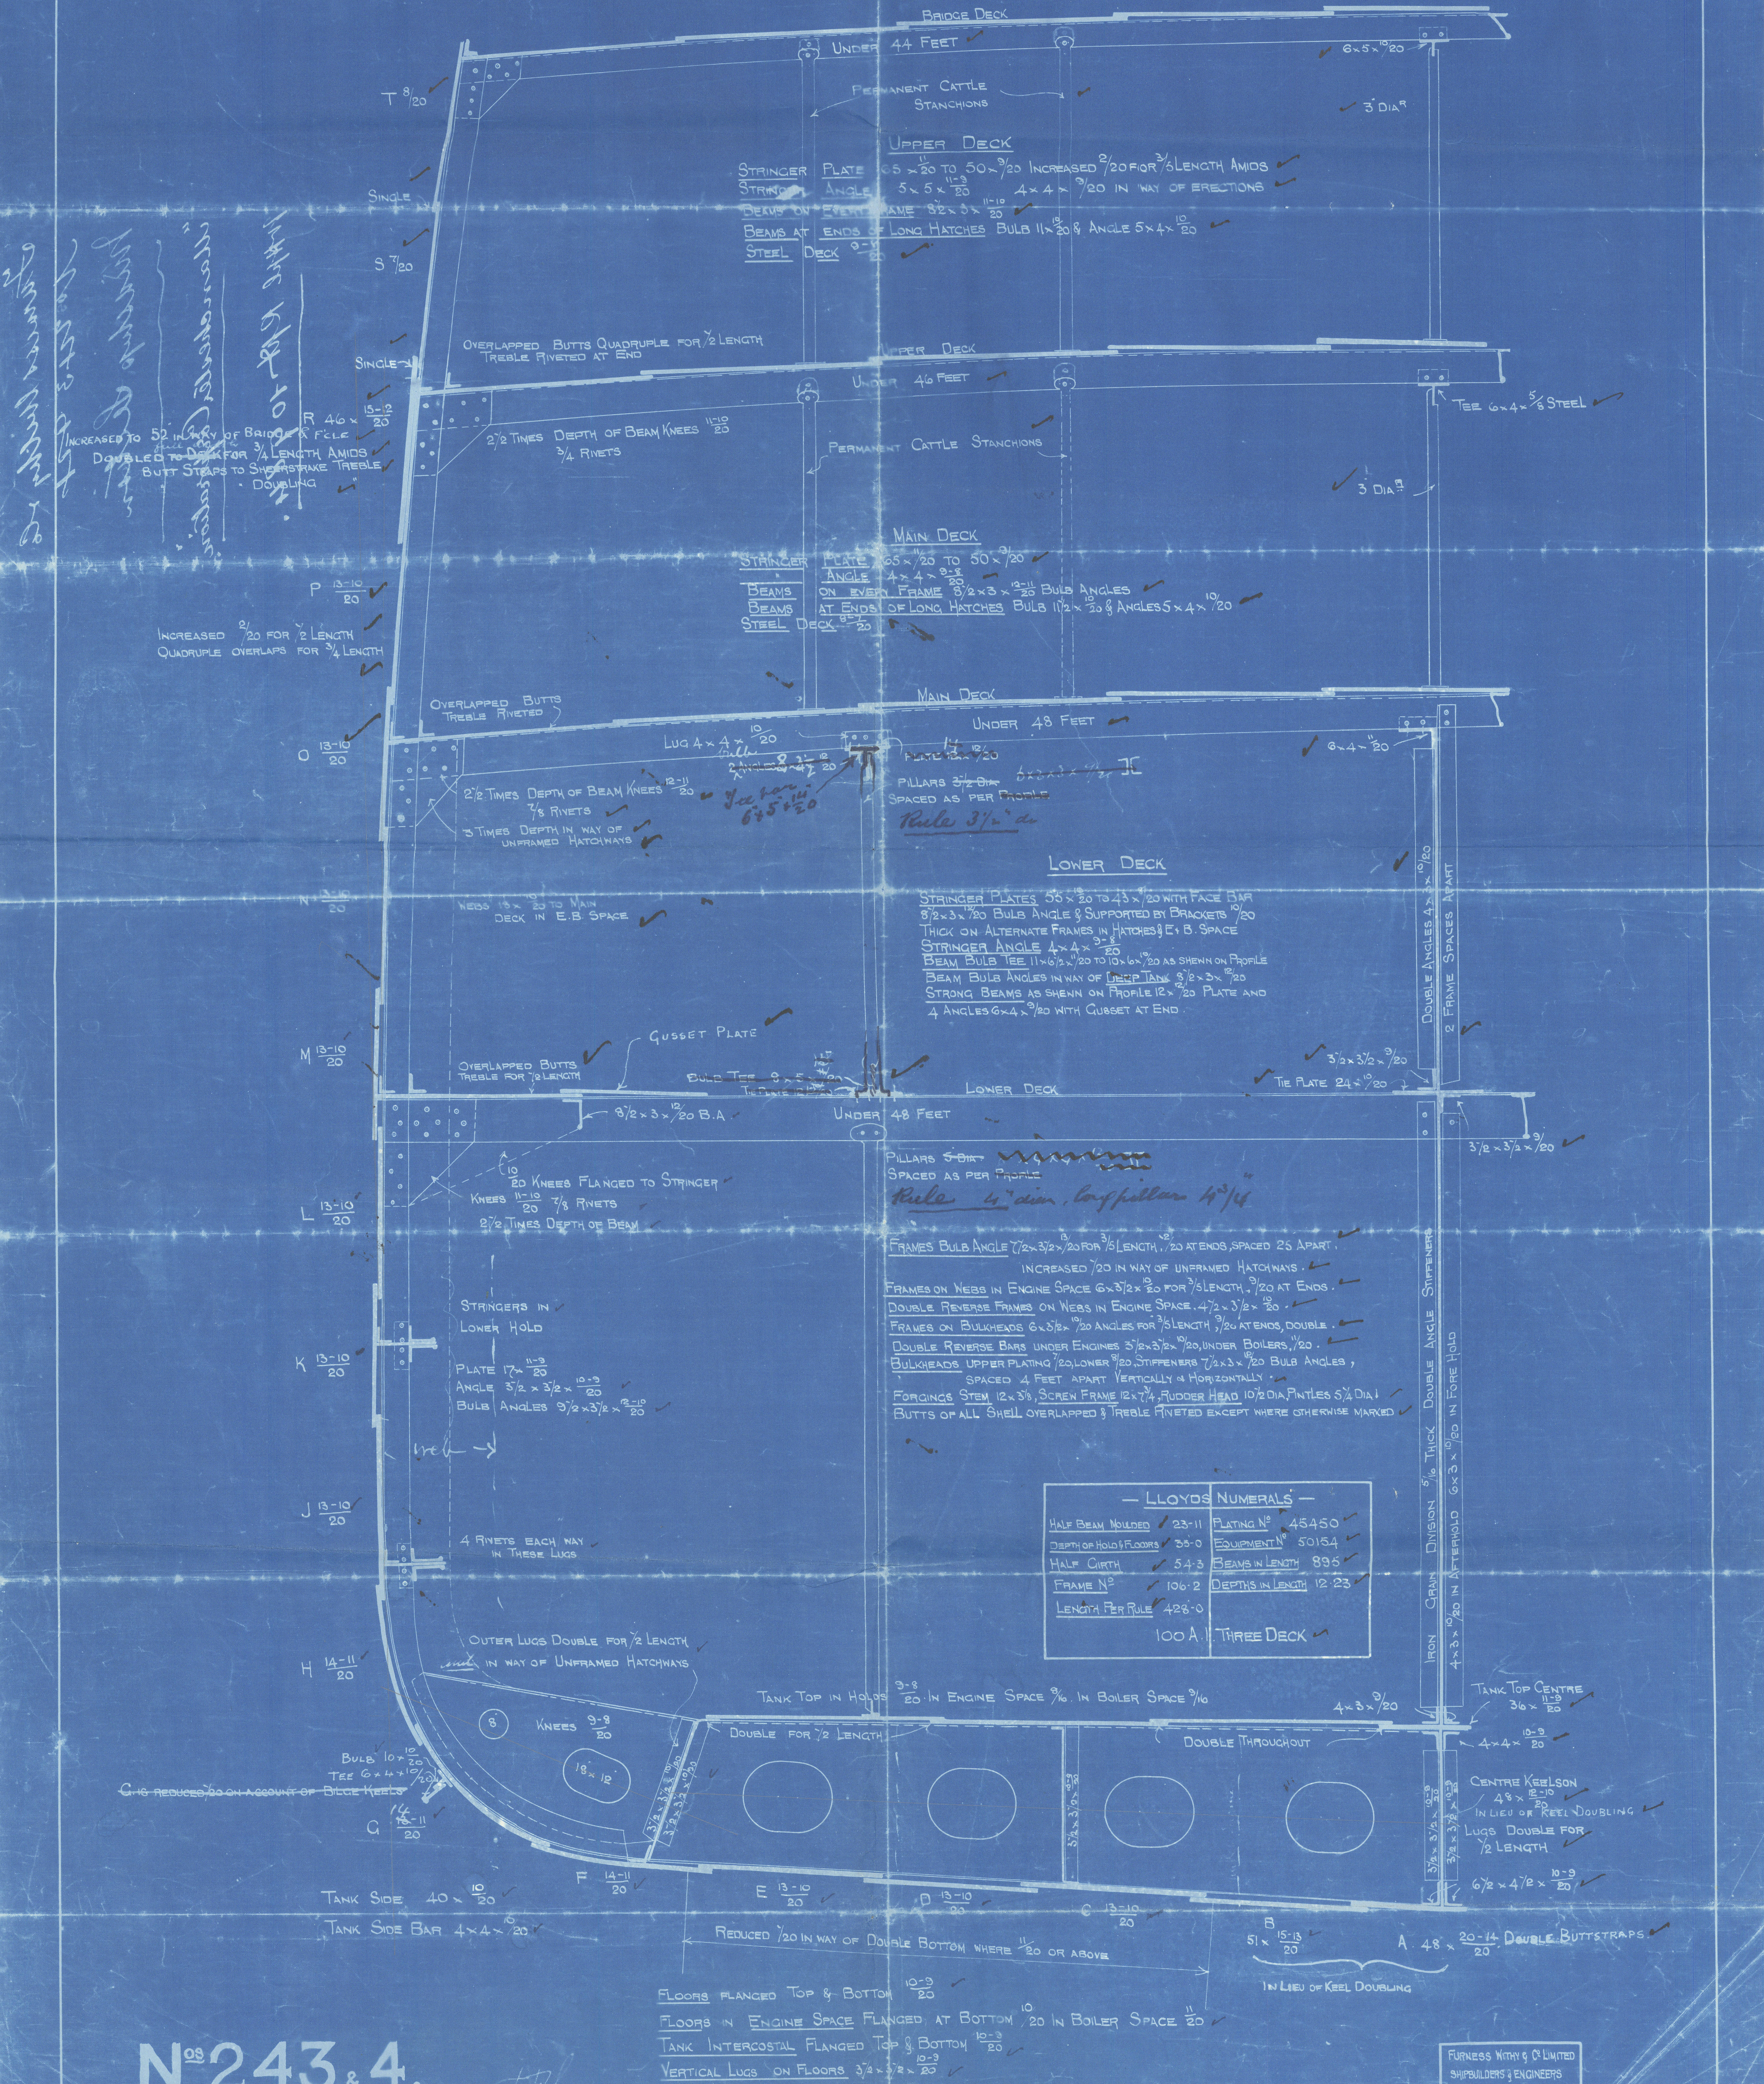

N^{os} 243 & 4.

FURNISS WITBY & CO LIMITED
 SHIPBUILDERS & ENGINEERS
 WEST HARTLEPOOL

Furness Withy & Co's
No 243 & 244



N^o 243.
Manchester Corporation

Hpl Report No. 11003

N^o 244.
Manchester Commerce
Hpl Rpt. 11052.

HPL 387-0200



© 2020

Lloyd's Register
Foundation