


11.11.98  
13.12.98

# PROFILE.

SCALE 1/8" = 1 FOOT

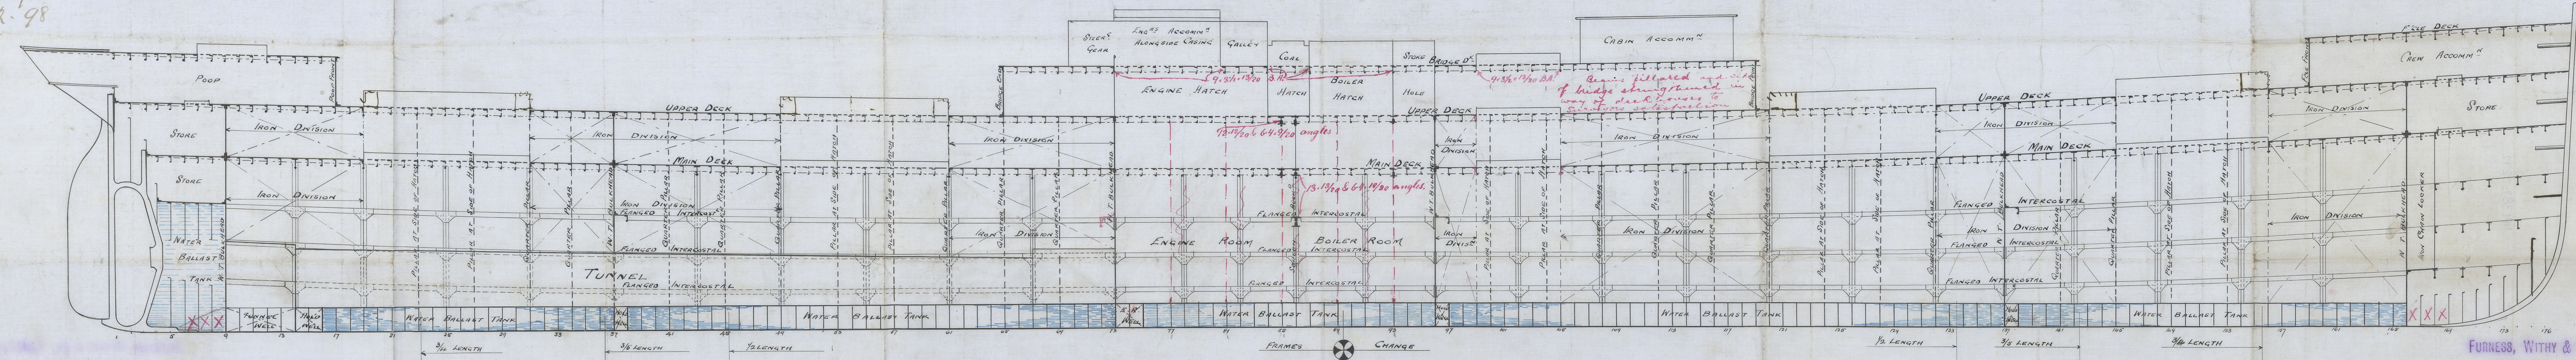

N<sup>o</sup> 245.

11.11.98

Handwritten notes on the right margin, including '11.11.98' and '13.12.98'.

FURNESS, WITBY & CO., LIMITED.  
SHIPBUILDERS & REPAIRERS  
WEST HARTLEPOOL.

7 Nov 7 1898

Lloyd's Register  
Foundation



Lurner Withy & Co


At no 245

Profile

"Verona"

Hpl. Report no. 1043

HPL387-0292

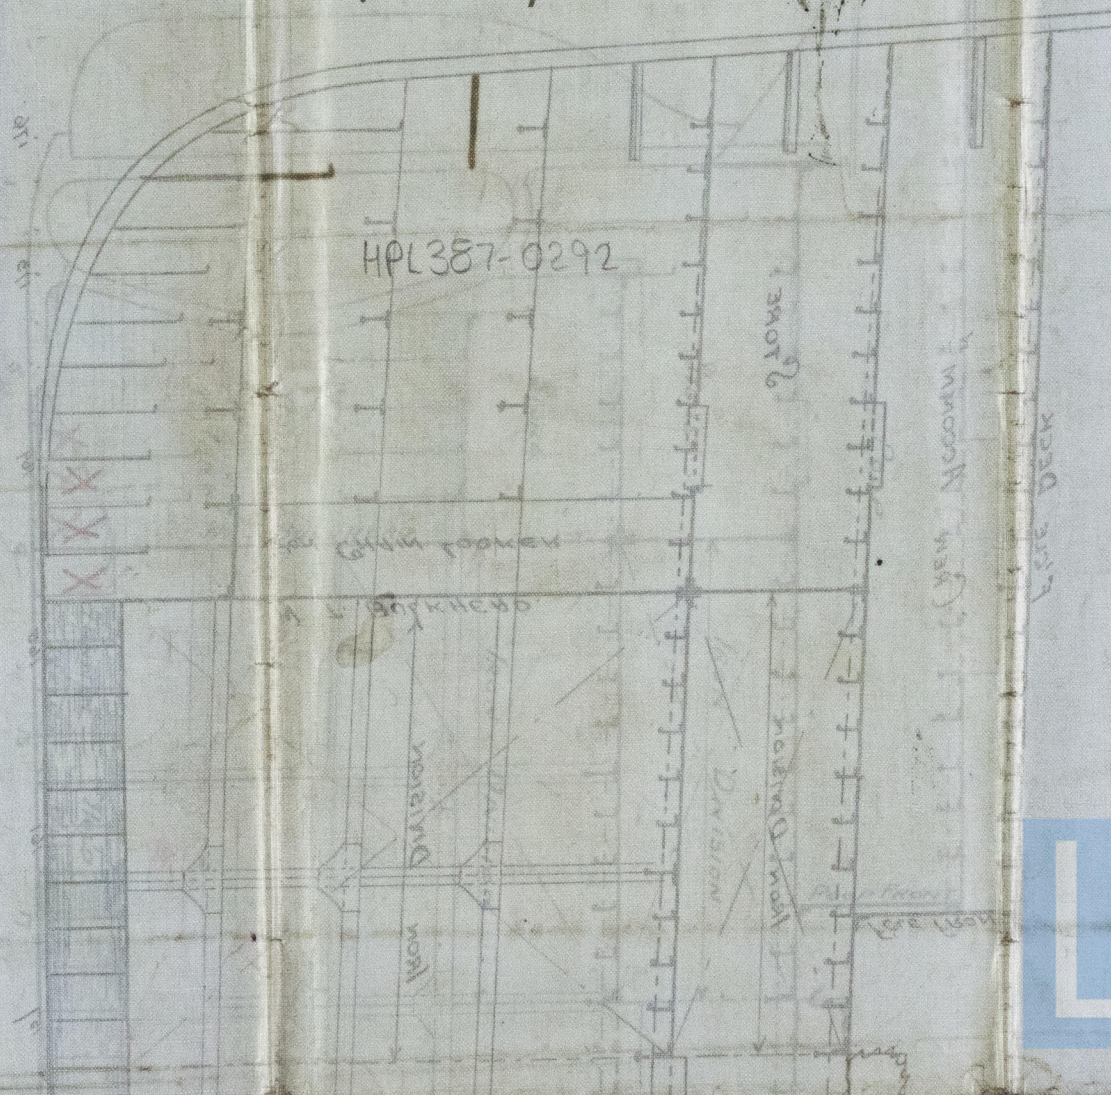

© 2020

Lloyd's Register  
Foundation