





CAST STEEL SCREW FRAME.

SCALE $\frac{1}{2}$ " = ONE FOOT.

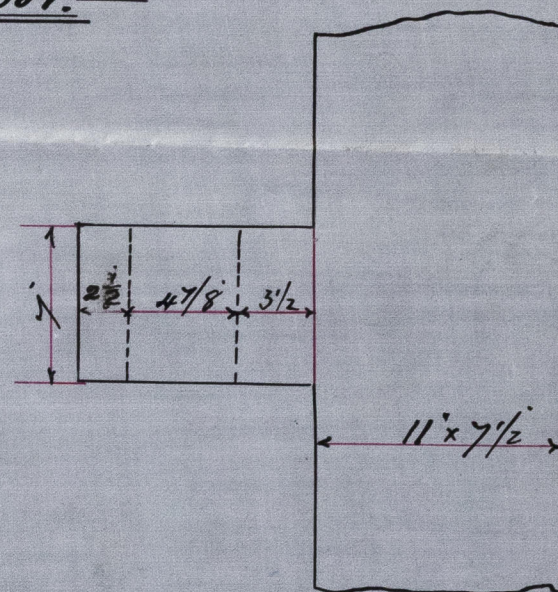

SKETCH OF GUDGEON.

SCALE $1\frac{1}{2}" = \text{ONE FOOT.}$ —

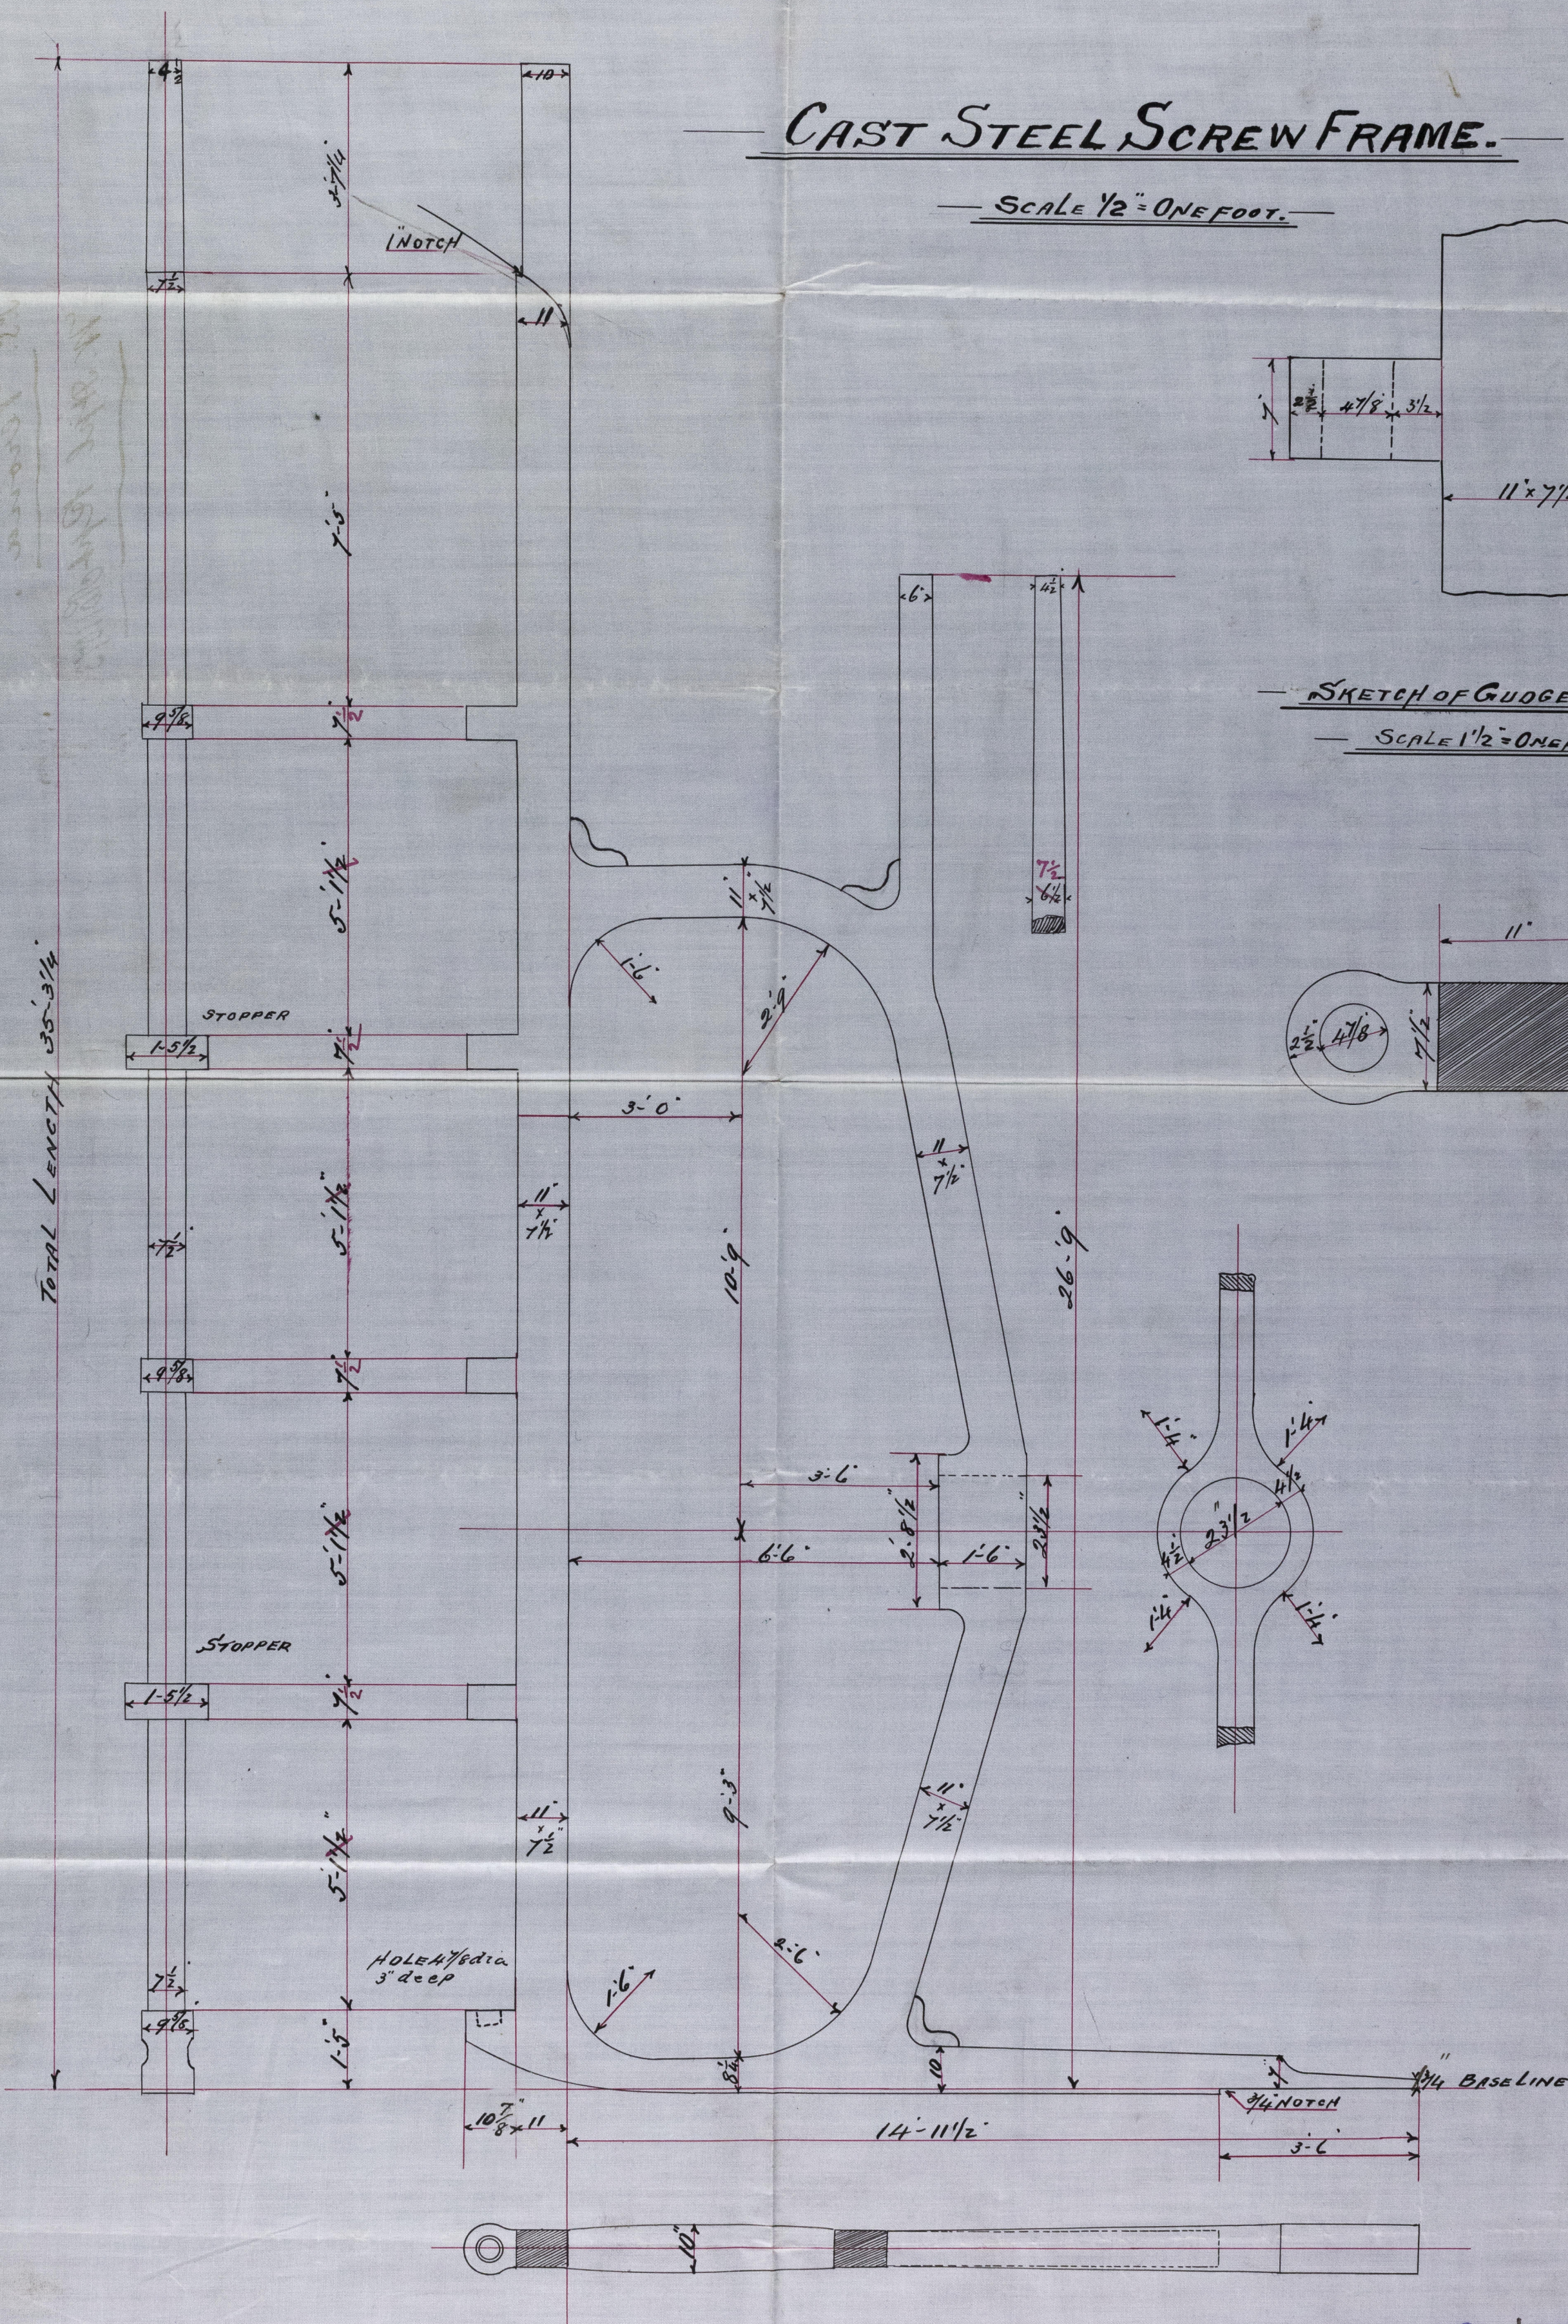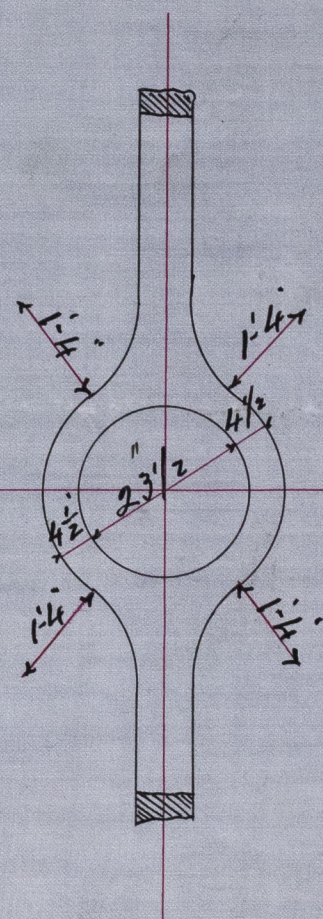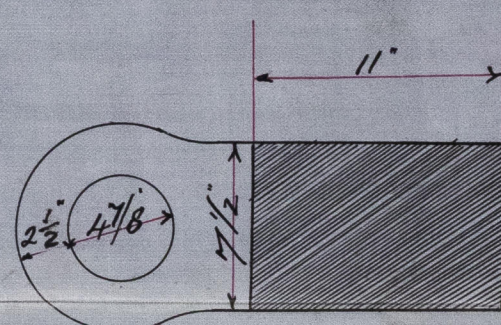

N^o 245.

FURNESS, WITTH & CO., LIMITED.

SHIPBUILDERS & REPAIRERS.

WEST HARTLEPOOL

Nov 10th/98

© 2019

Lloyd's Register
HPL 378-0294
Foundation

Lloyd's Register
Foundation