


18.8.99

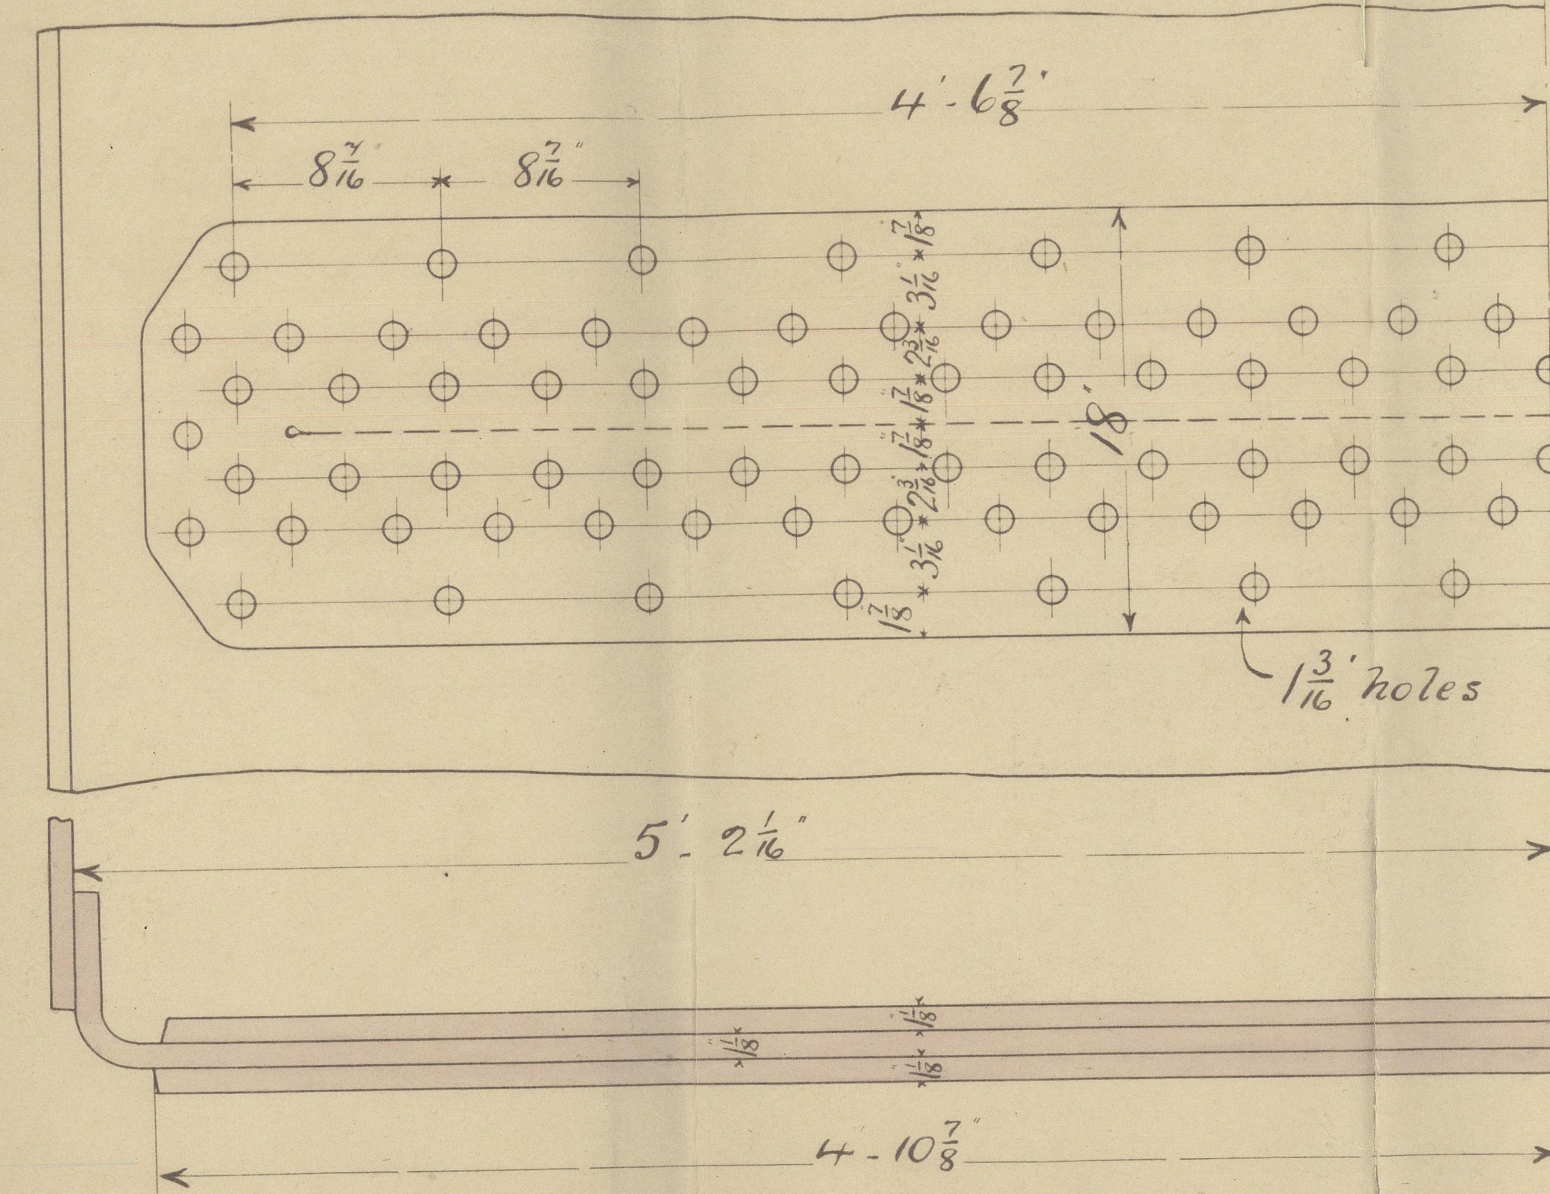

18.8.99





403

BOILERS No 604.

WORKING PRESS - 160 LBS TO LLOYD'S SURVEY

SCALE 1" = 1 FT

Shell plates to have a tensile strength of 27 to 30 tons
Main stays 27 to 32 tons
Other plates & stays 26 to 30 tons

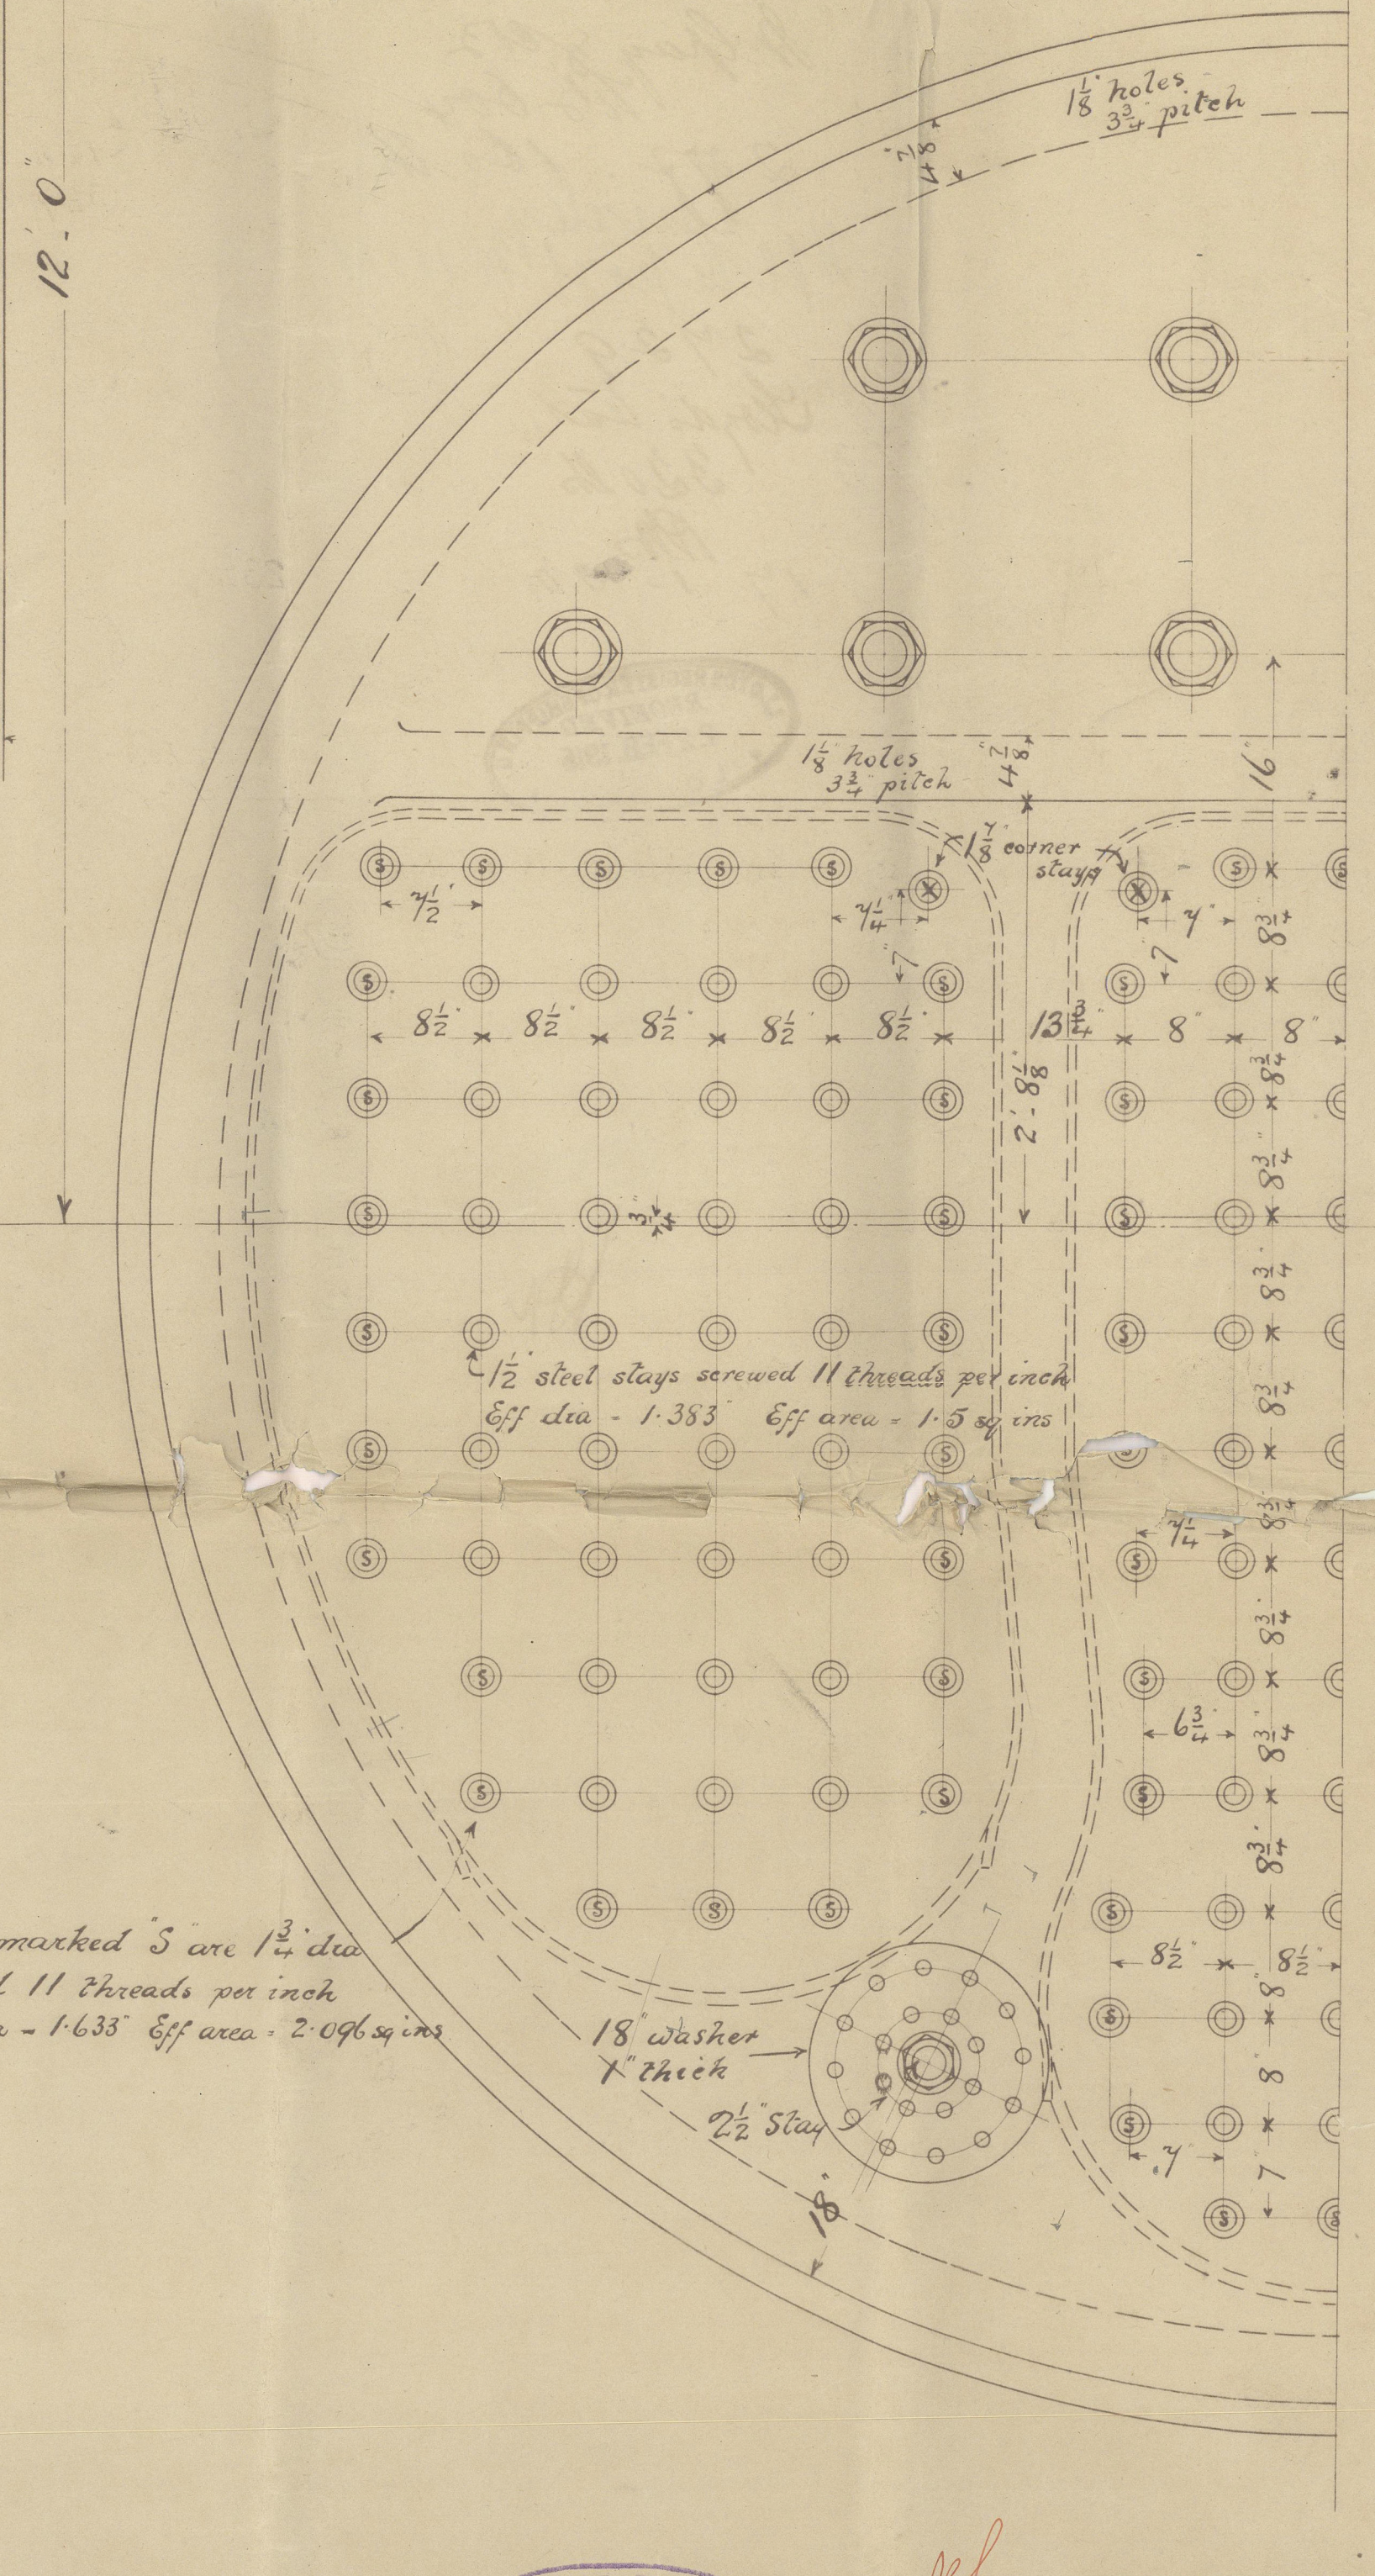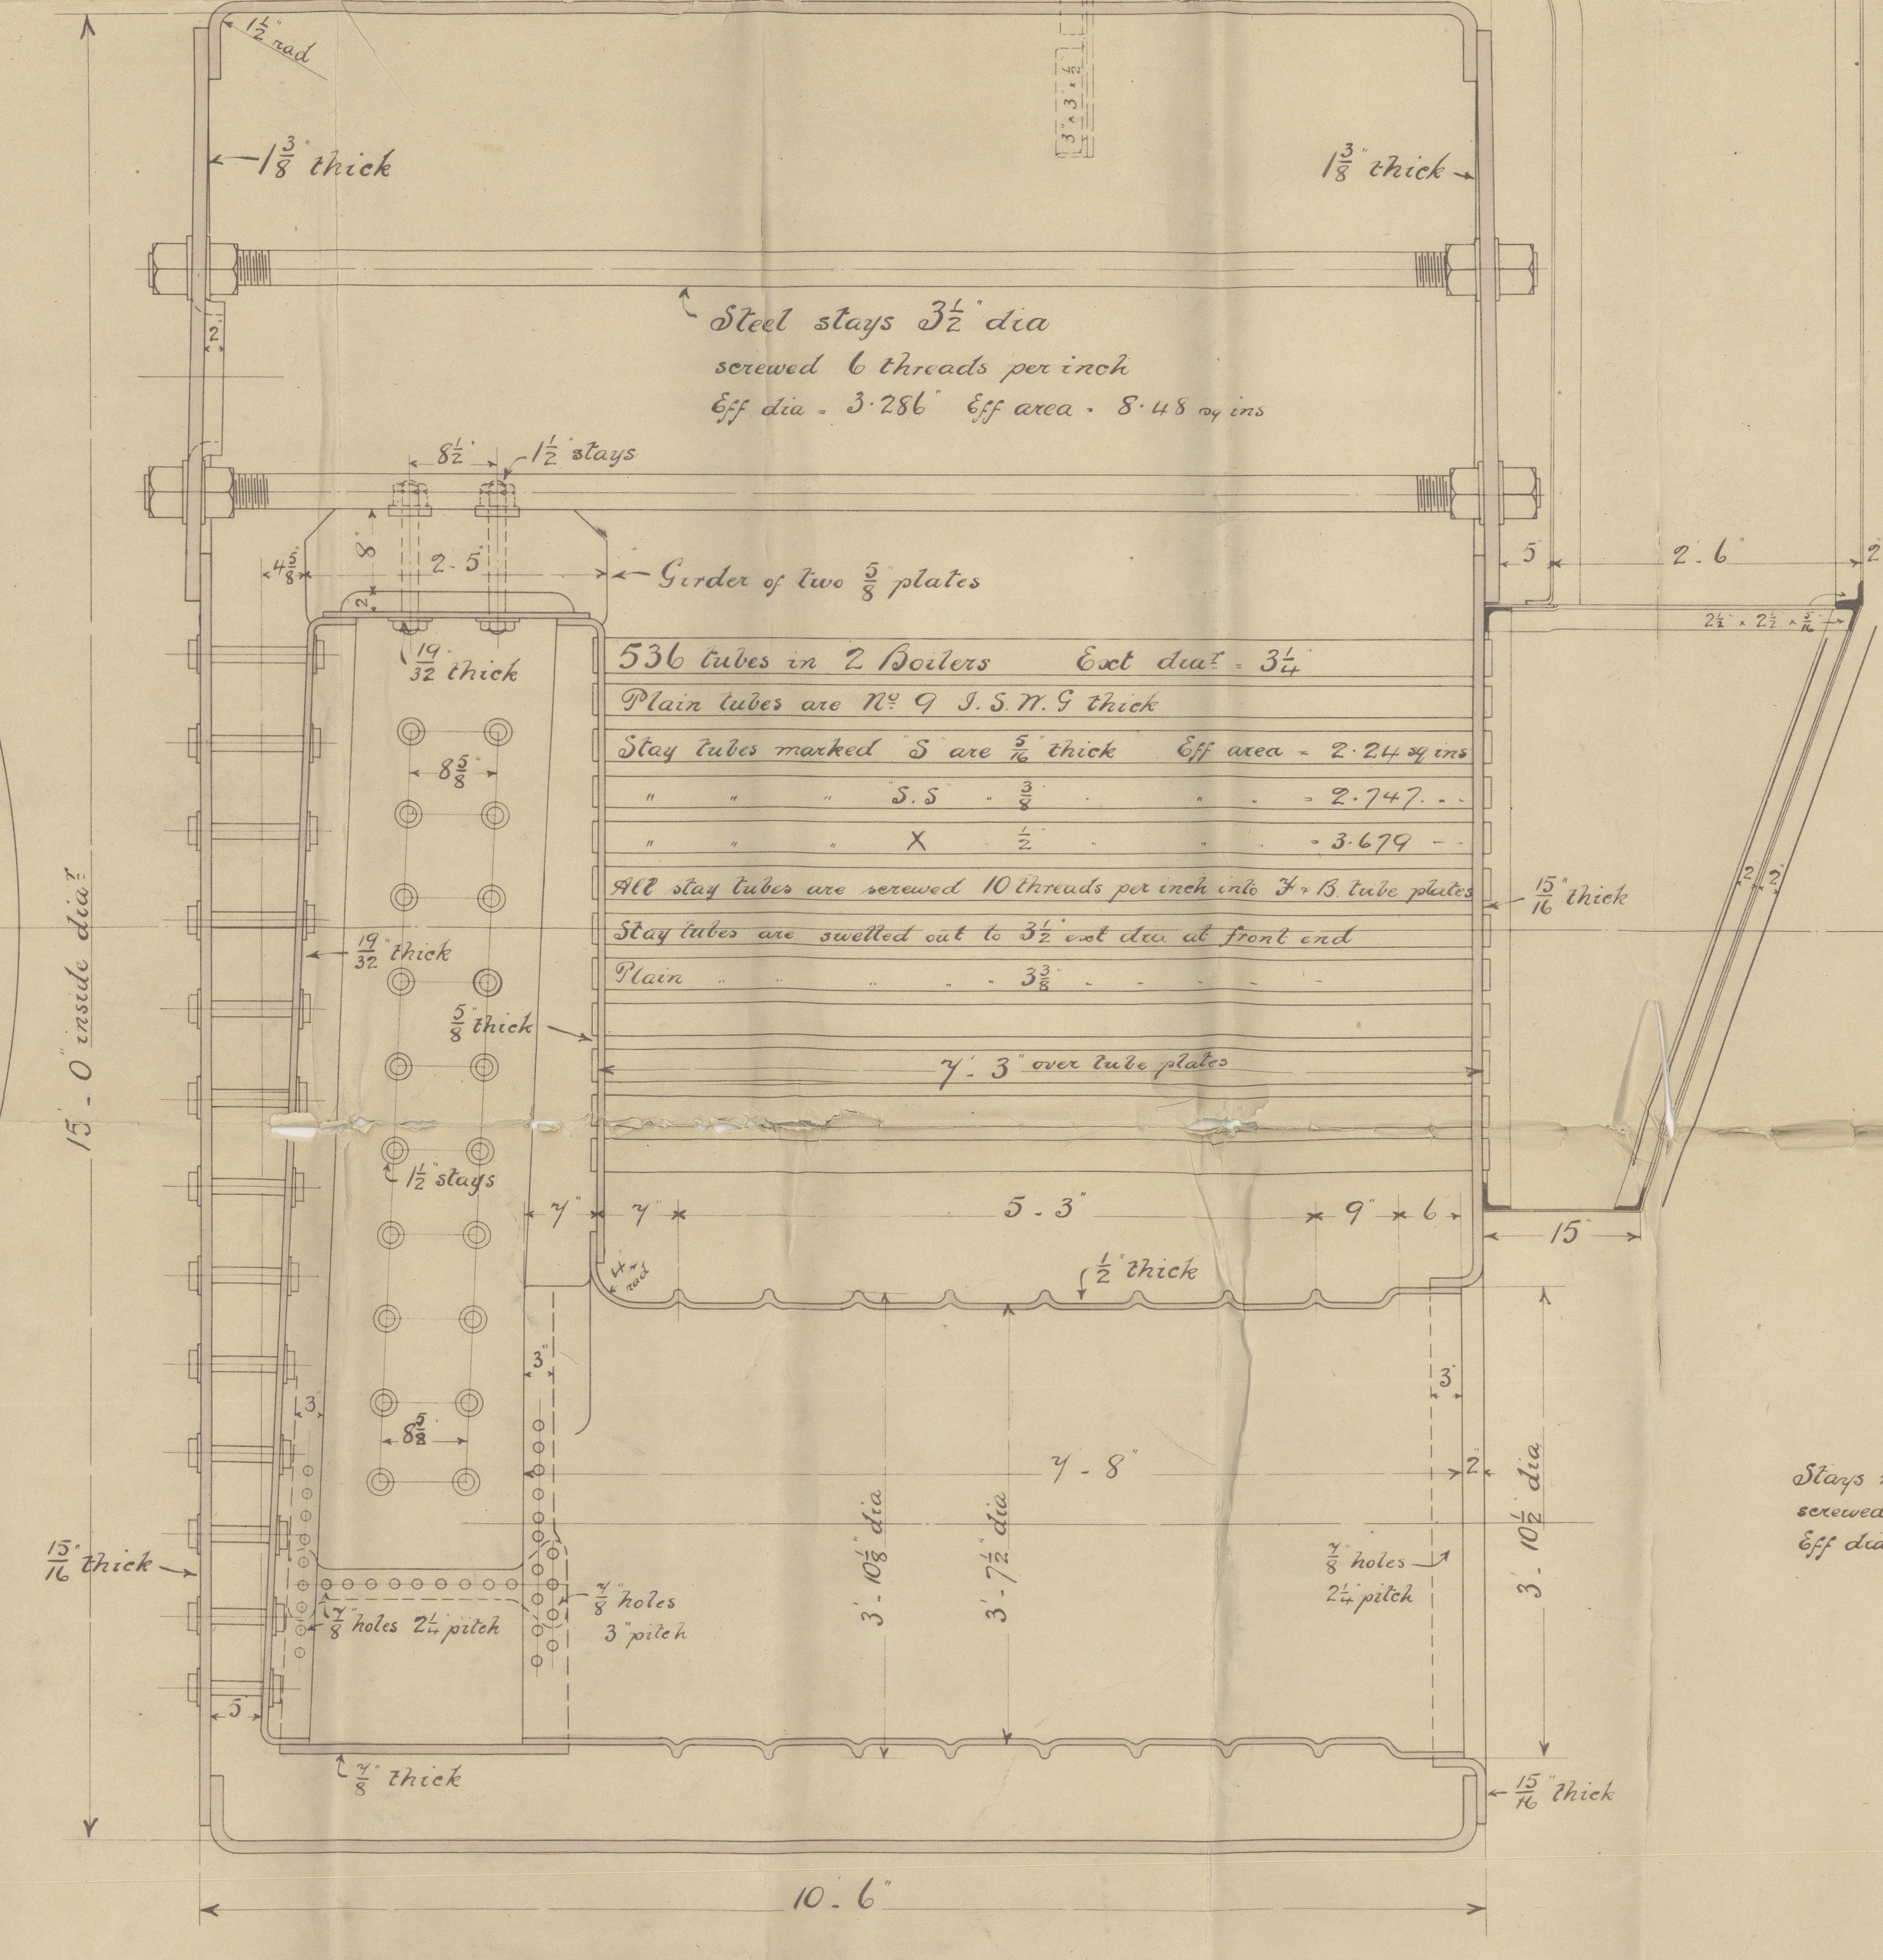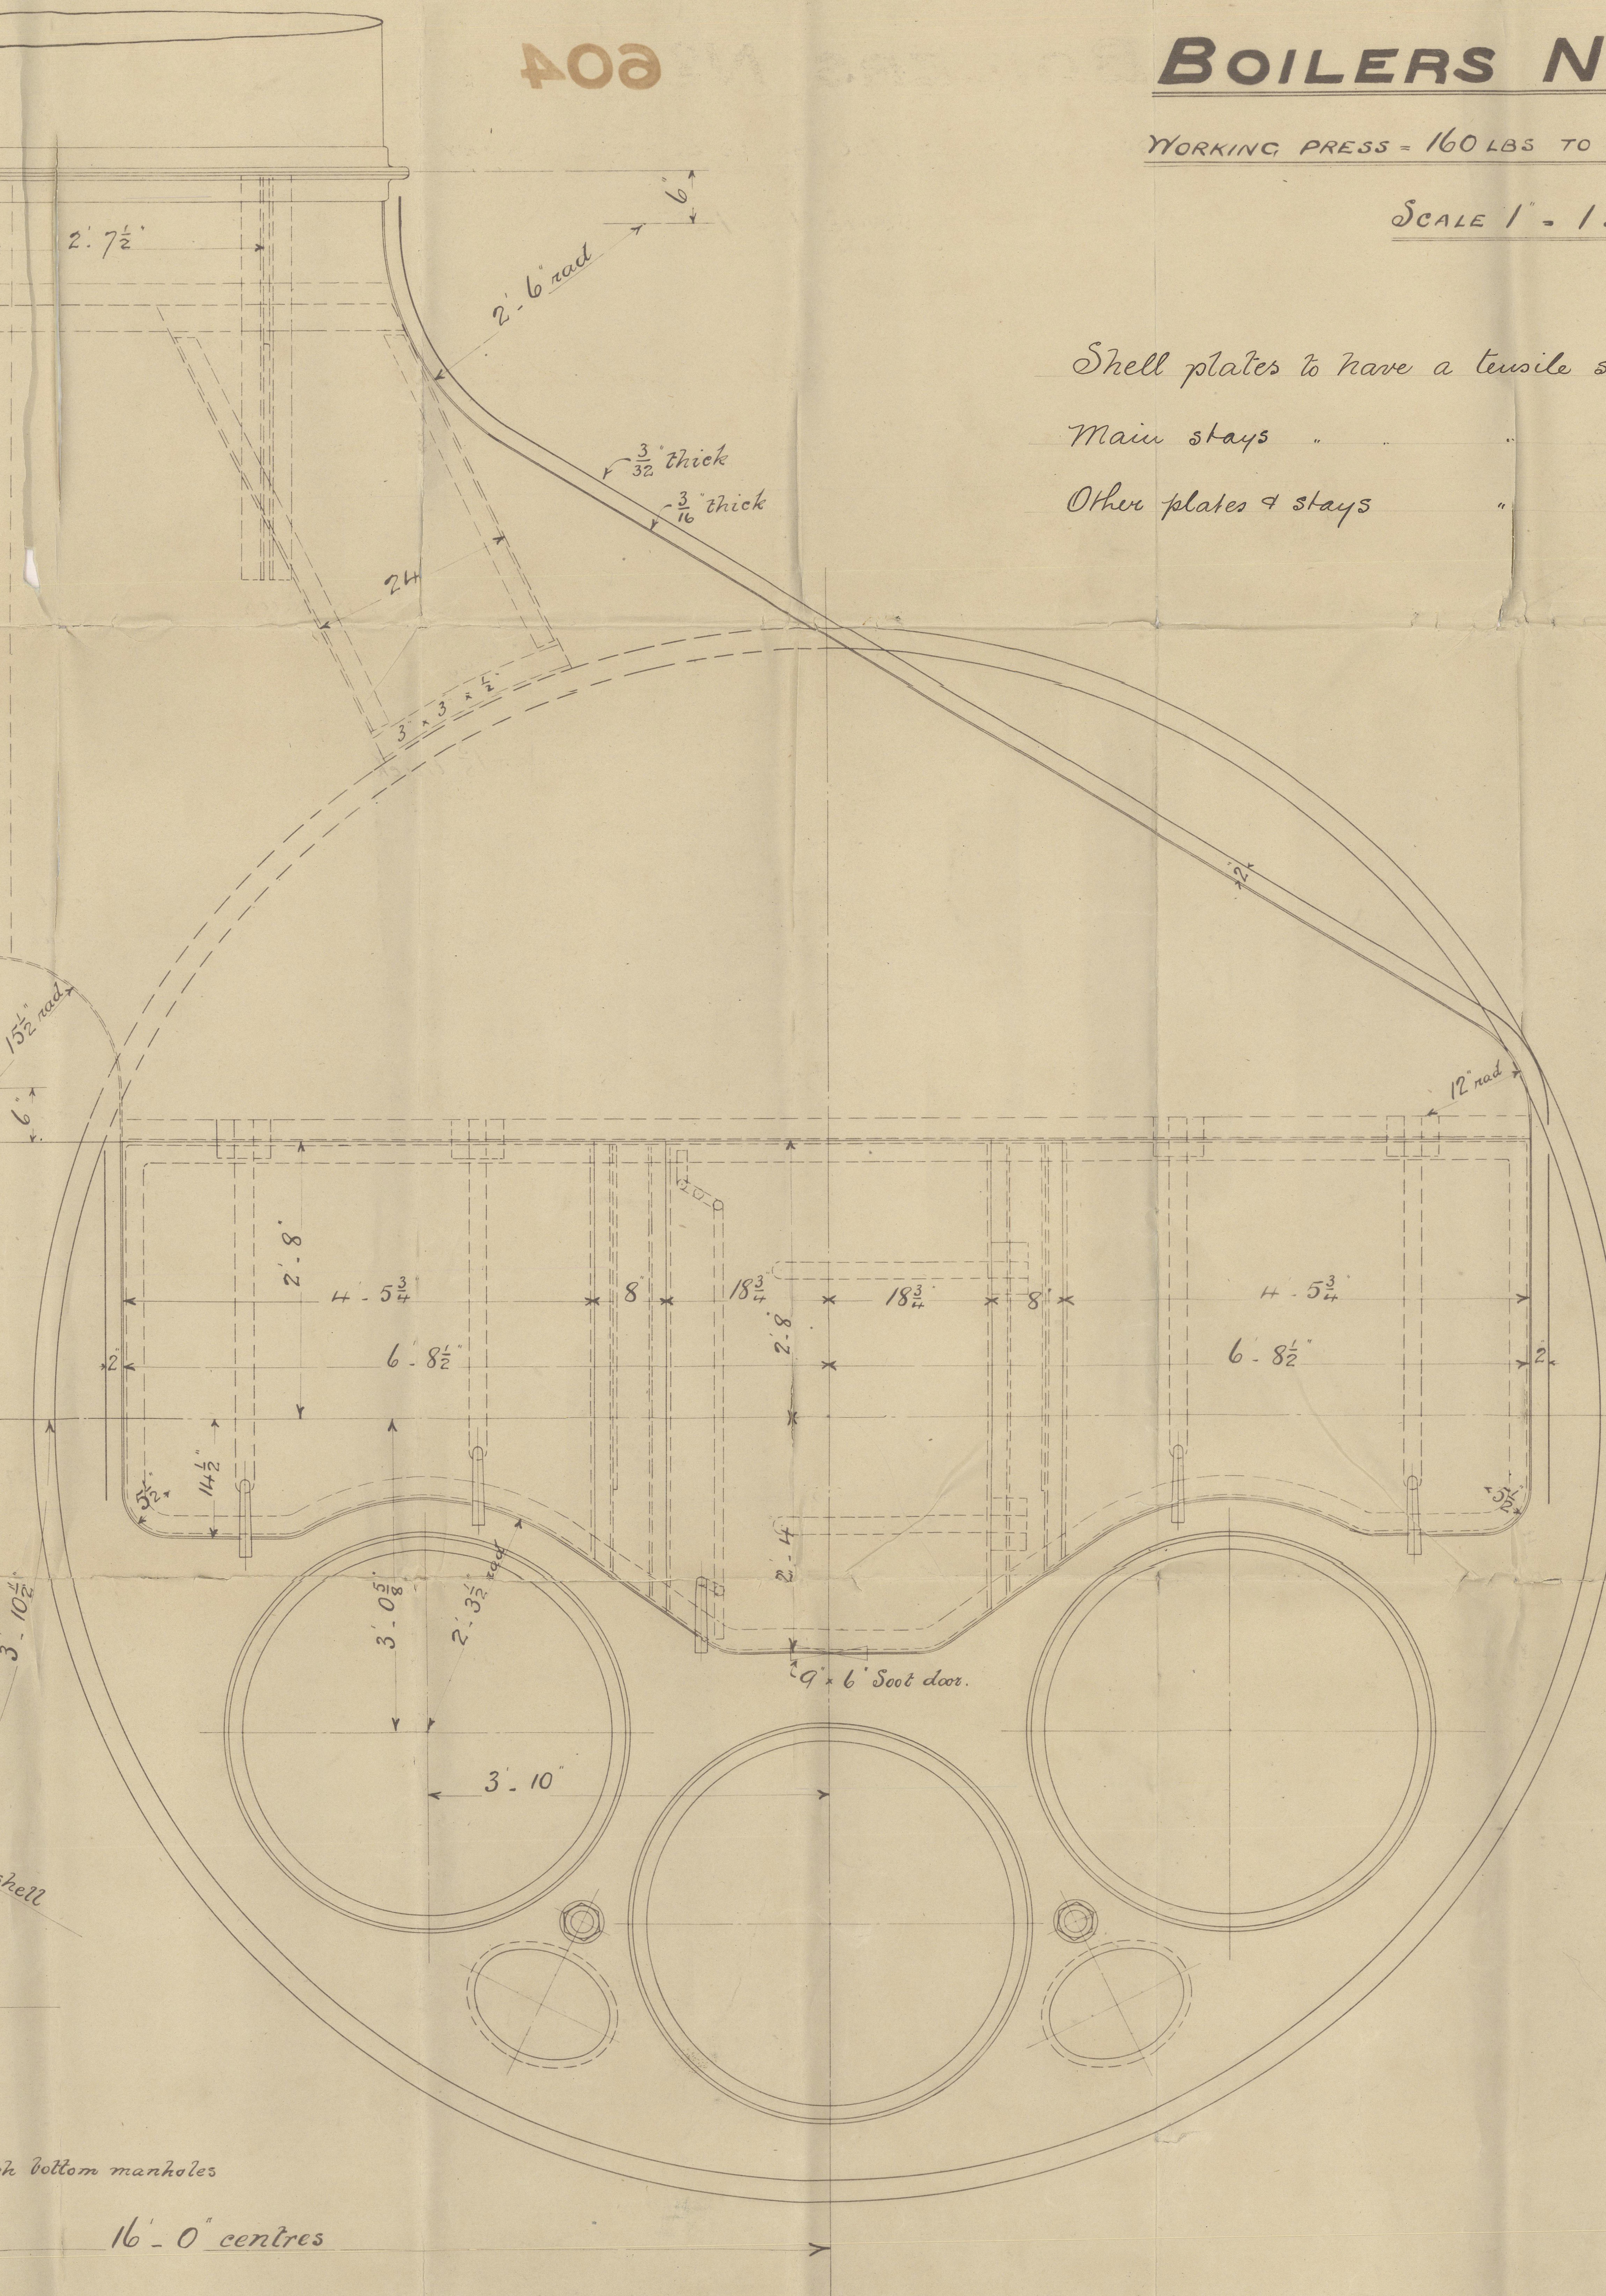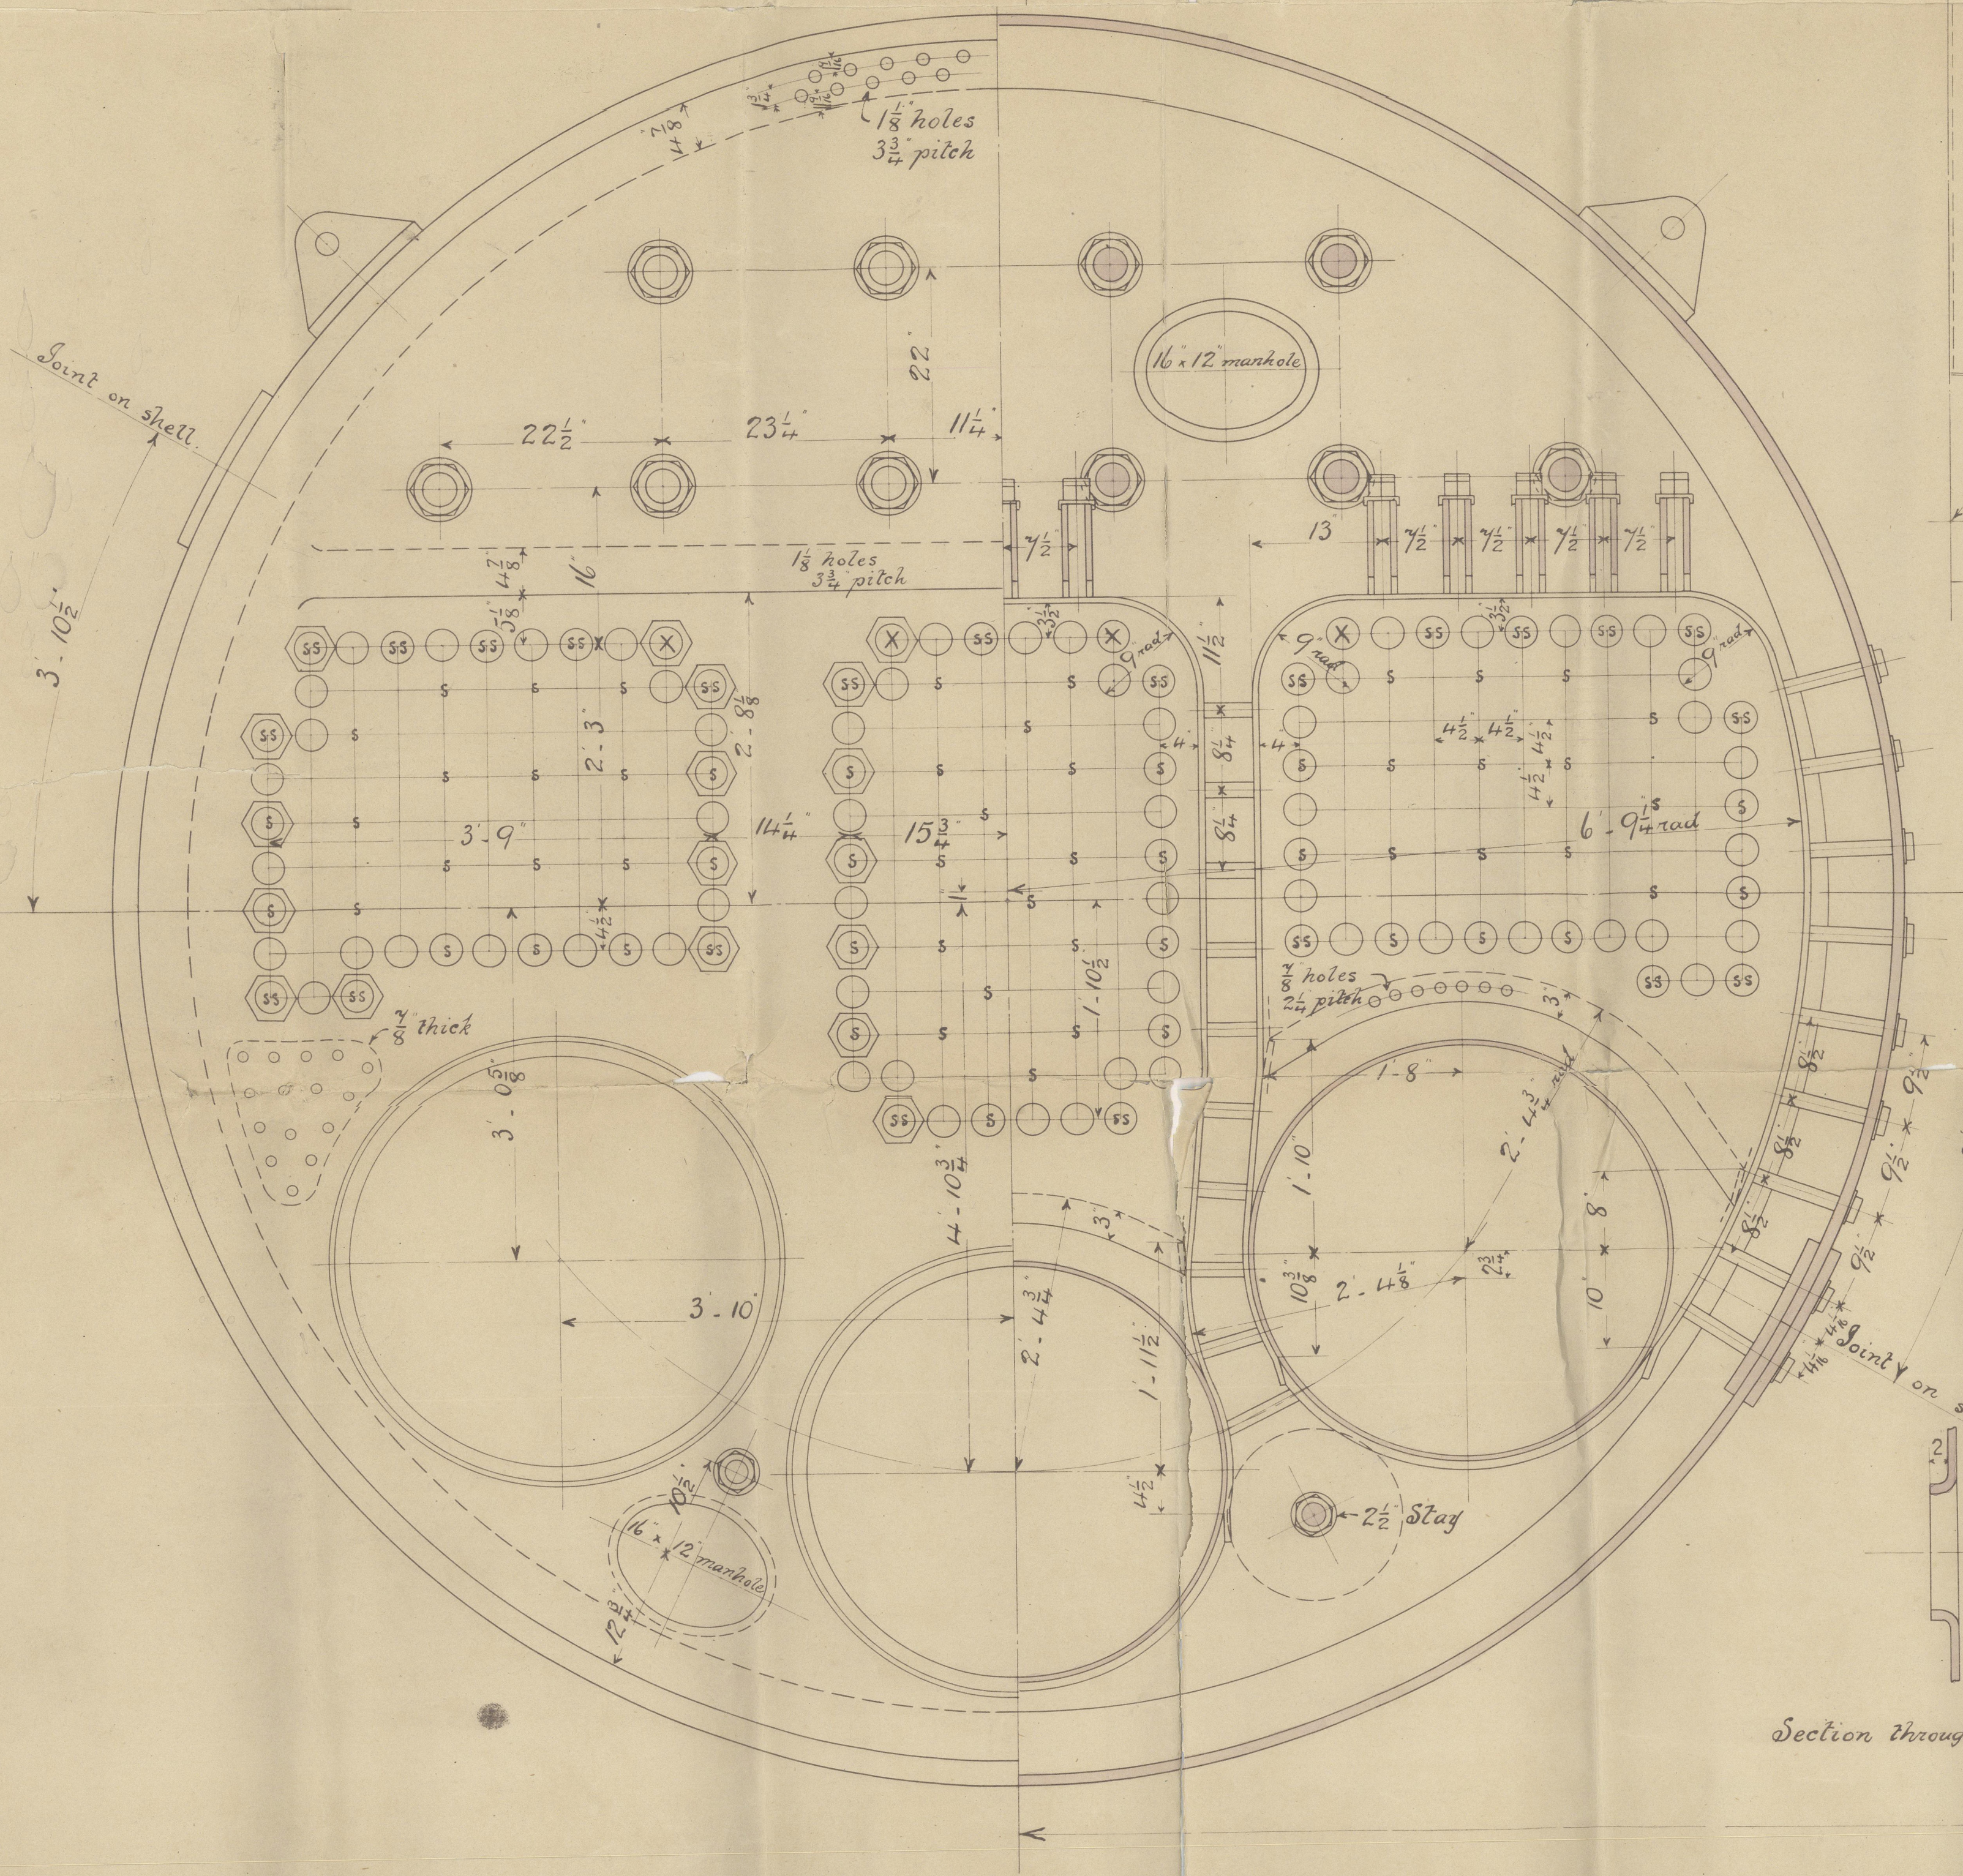

No 604.



B. Gray 803
112 604


2 272. 160 lb
" Shirley
Hpl Report No. 11115

2729
Lloyd's list
320 lb

Pls
17. 1-00



HPL 388-0055

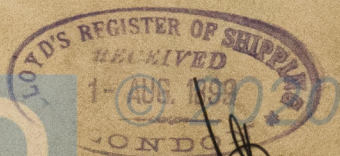

Lloyd's Register
Foundation