





RUDDER

SCALE $\frac{1}{8}'' = 1 \text{ FOOT}$

CAST STEEL



Handwritten notes:
 1. 2. 99

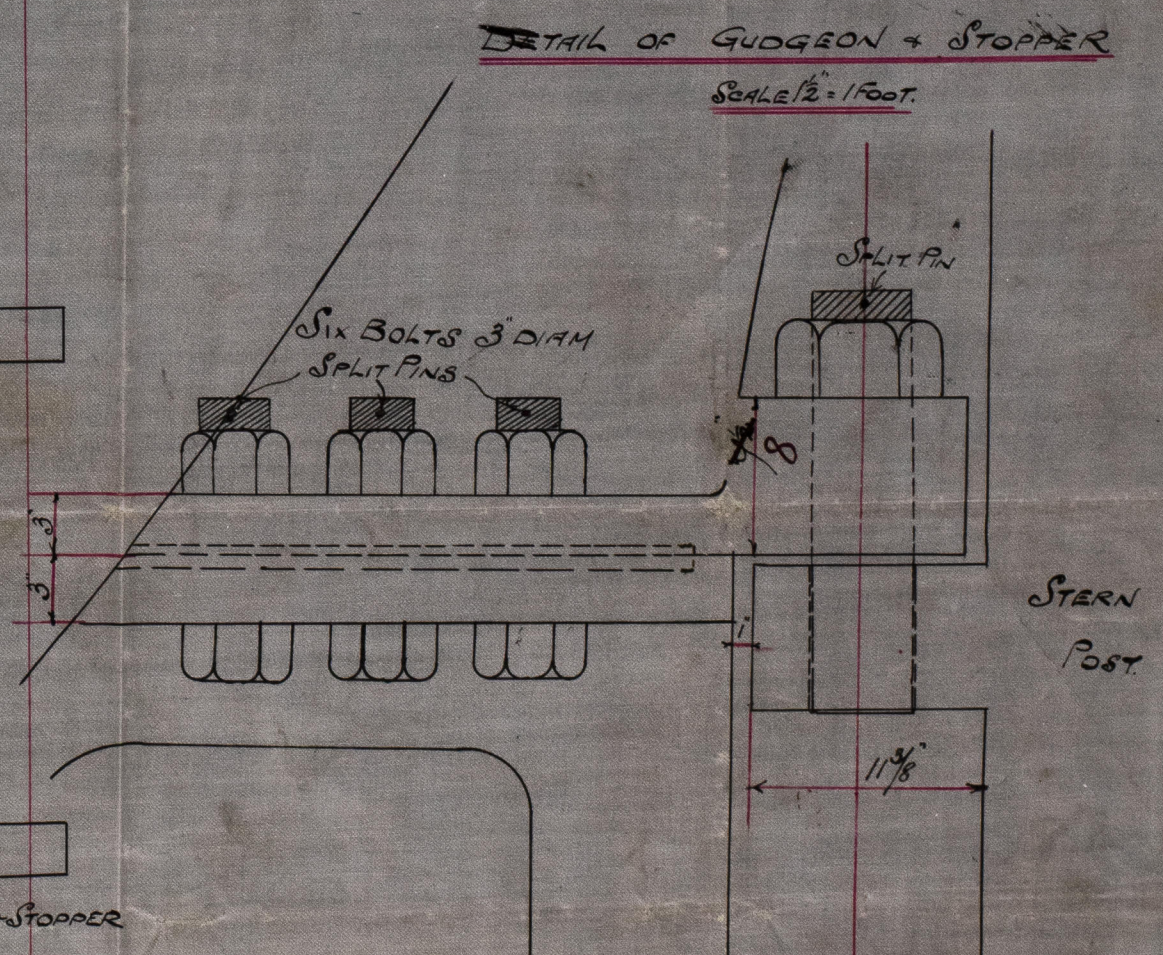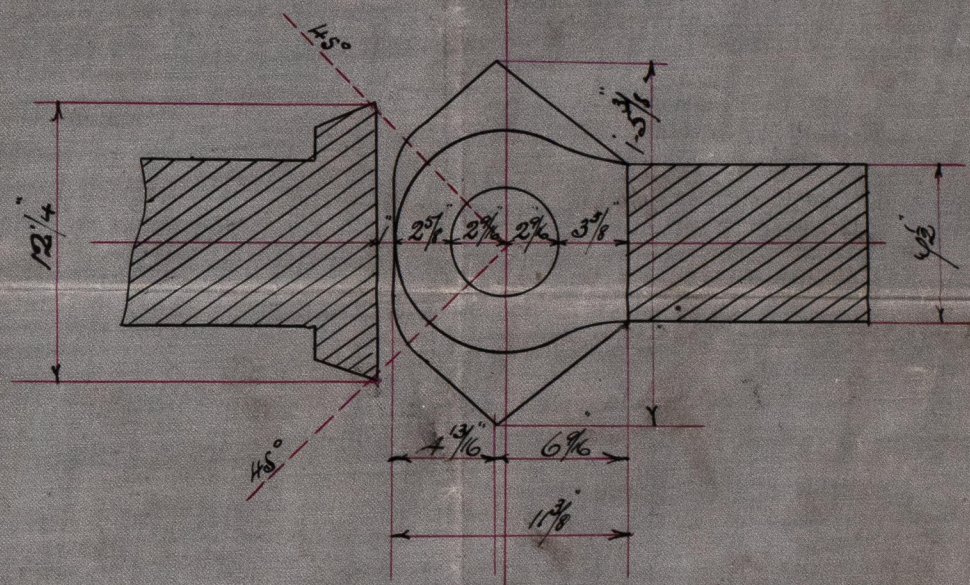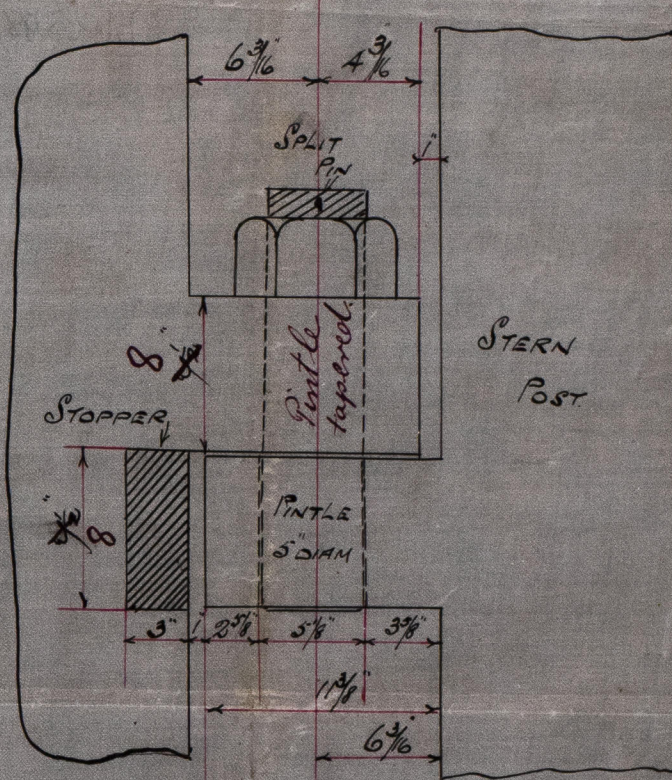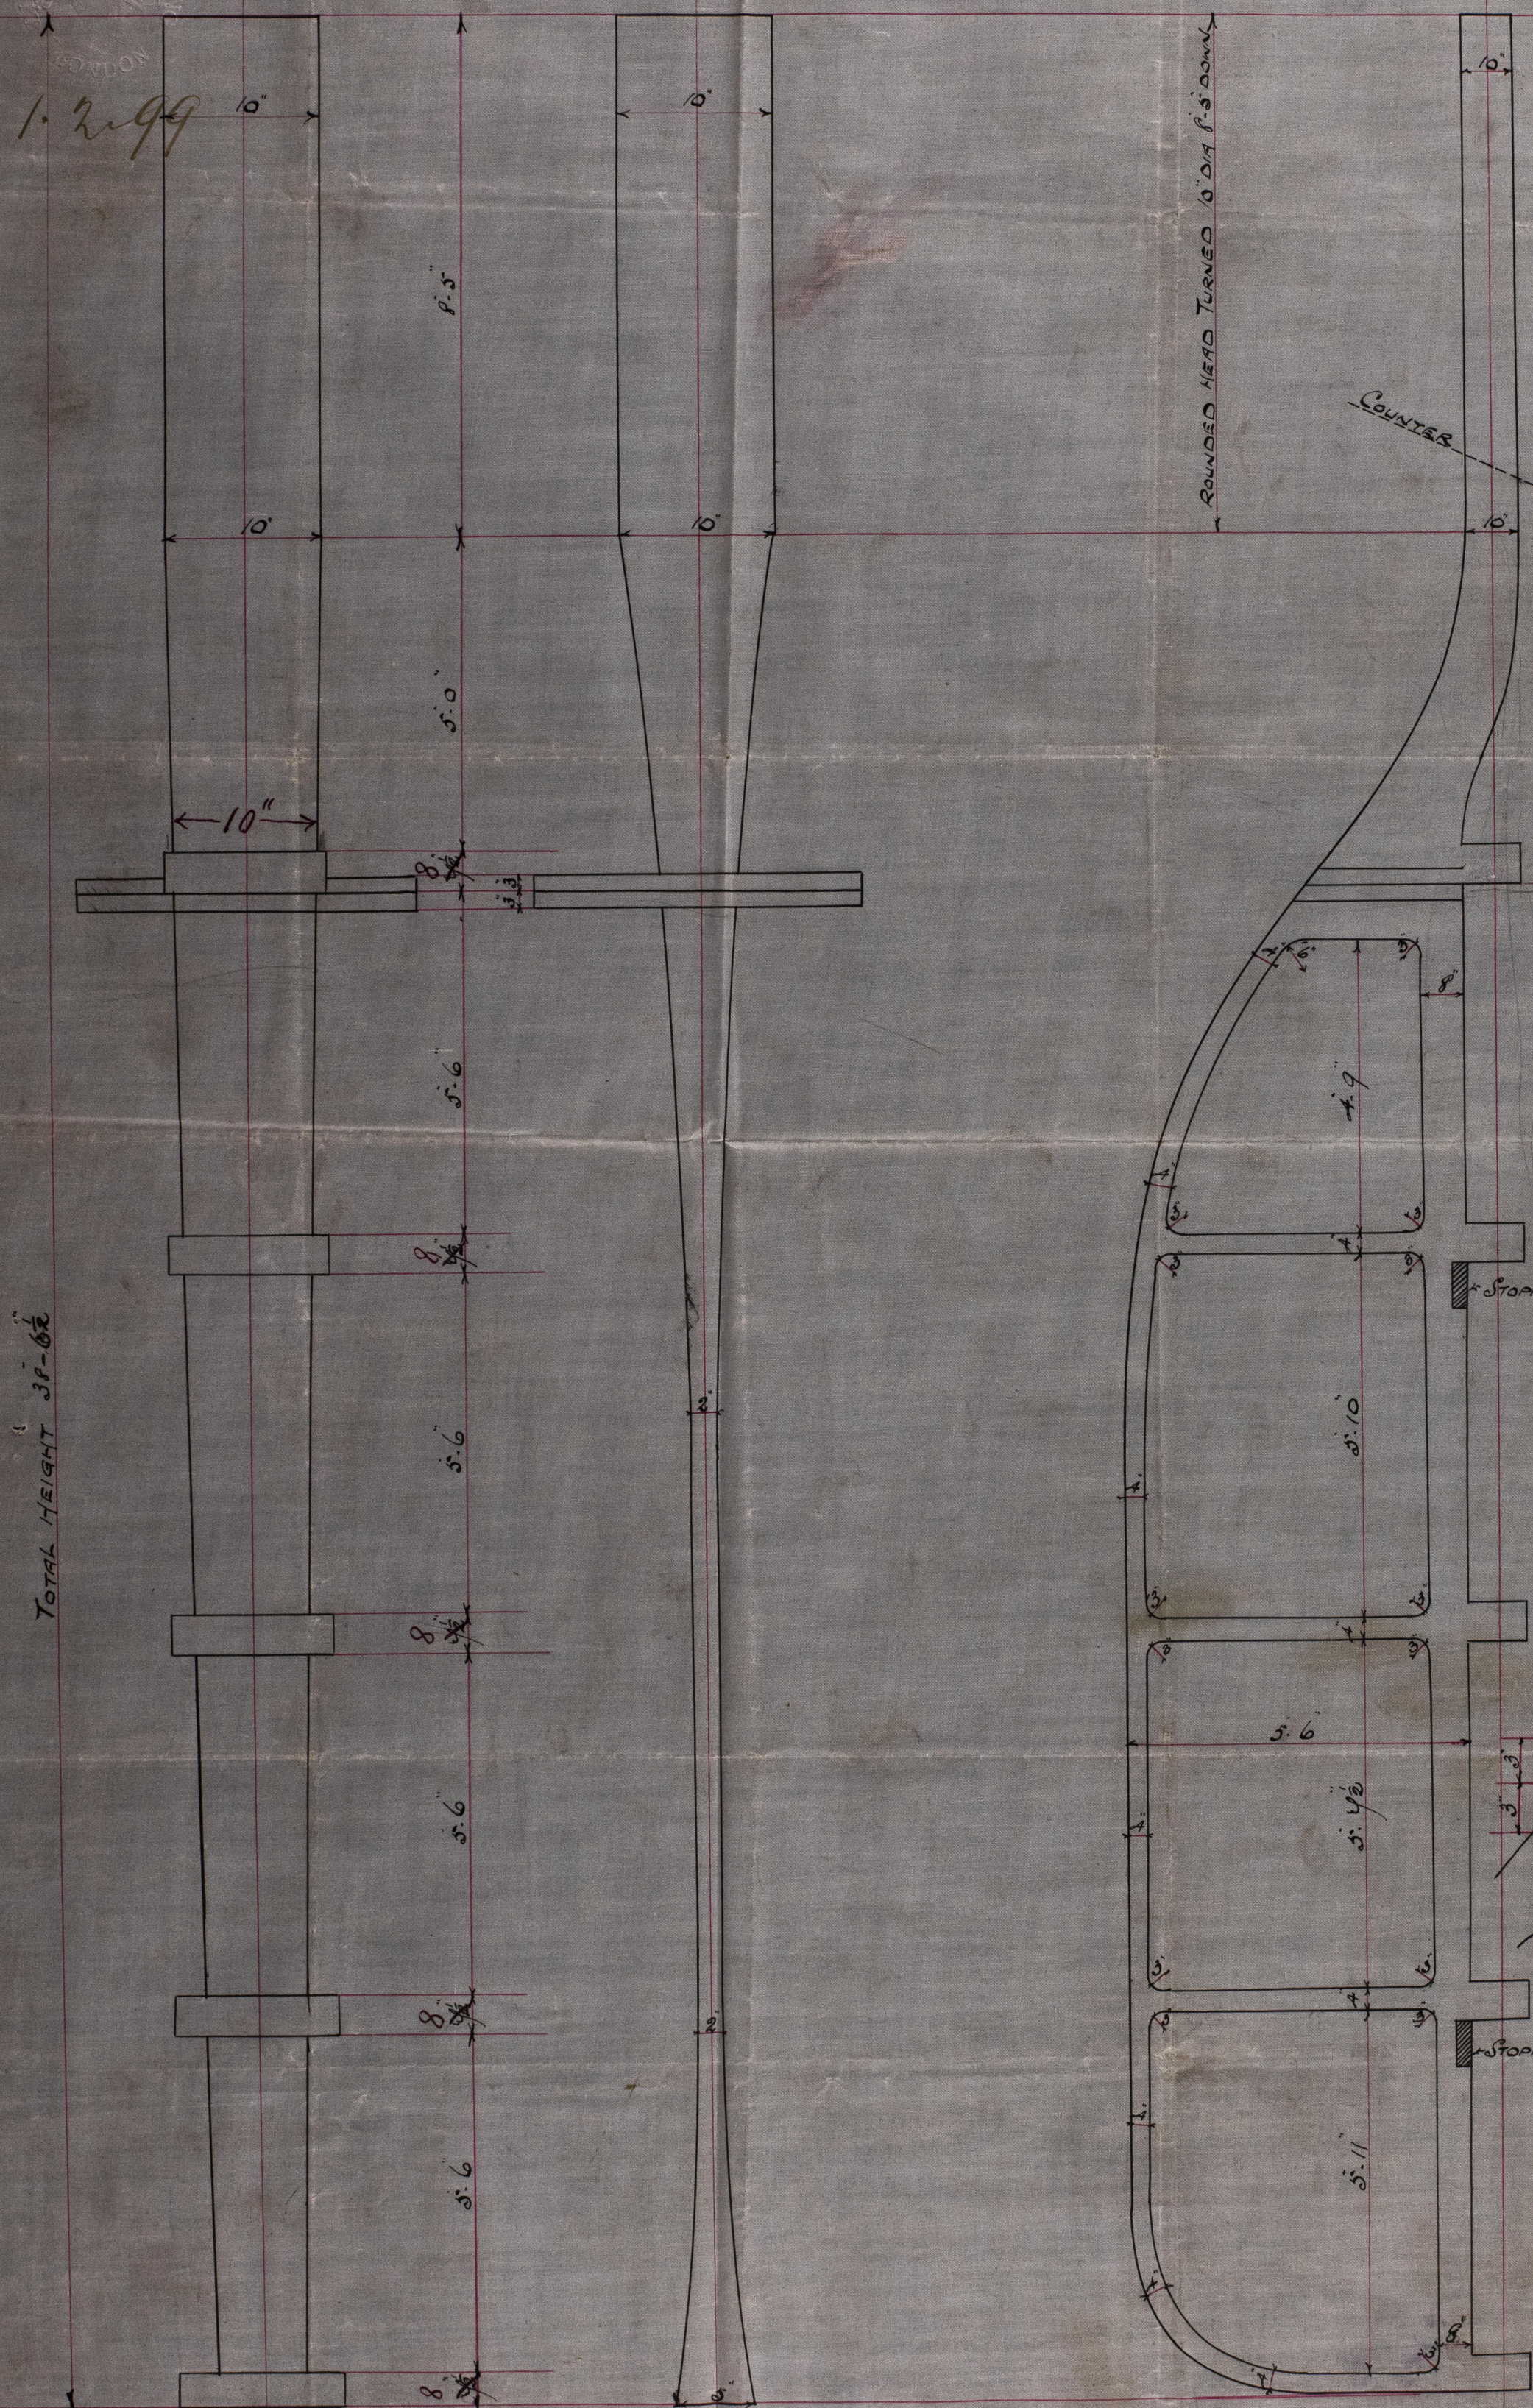

SKETCH OF COUPLING
 SCALE $\frac{1}{2}'' = 1 \text{ FOOT}$

FURNESS, WITBY & CO., LIMITED,
 SHIPBUILDERS & REPAIRERS
 WEST HARTLEPOOL

Jan 27th 1999



Lloyd's Register
 Foundation

No 246

HPL388-0145



CAST STEEL




CONFIDENTIAL

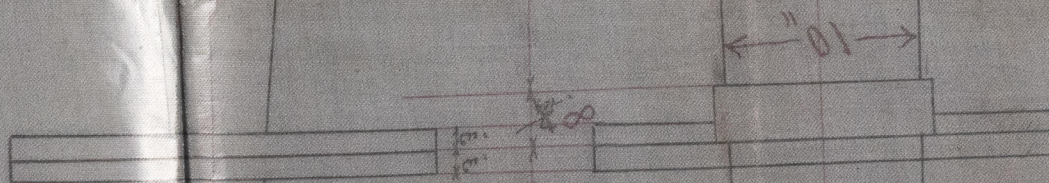

Lloyd's Register
Foundation

Furness Withy & Co
St. No 246

CS. Rudder frame


46 "Freiburg"

Hpl Report No. 11140

48 "Marburg"

Hpl Report No. 11185

HPL 388-0145

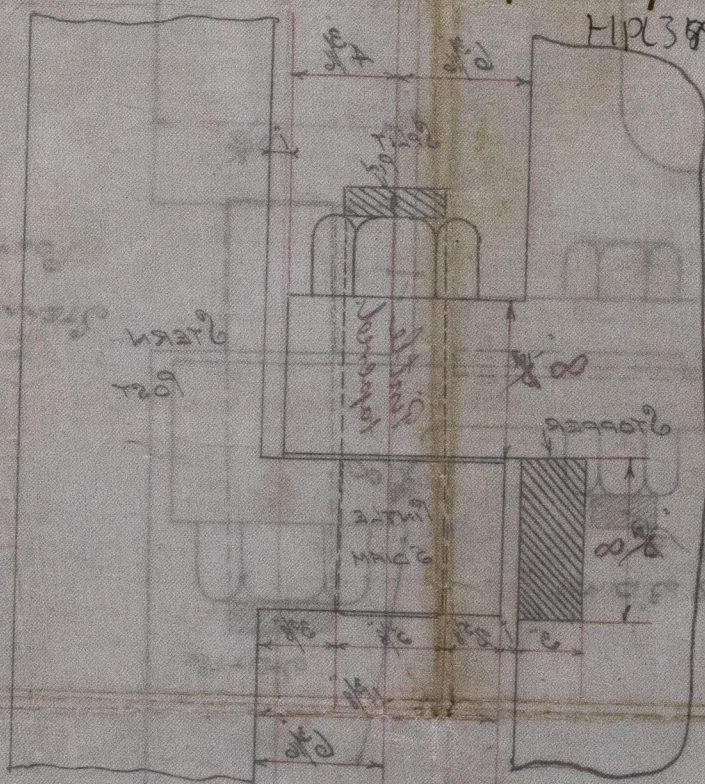

SCALE 1/2" = 1' 0"




© 2019

Lloyd's Register
Foundation