


SCALE $\frac{1}{8}'' = 1 \text{ FOOT}$.

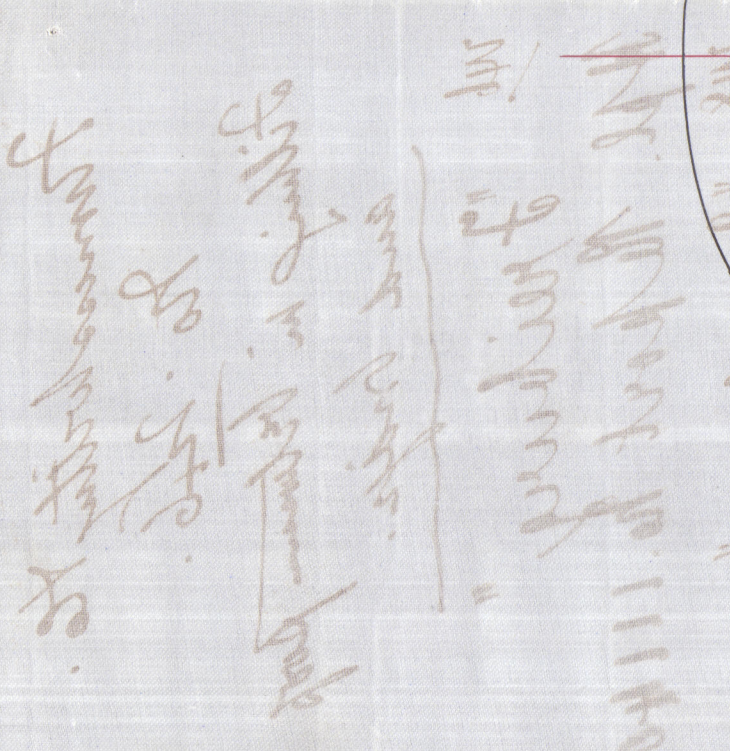

all frames to be bracketed

FURNESS, WITBY & CO. LIMITED
© 2020
REINFORCEMENT & REPAIRS
WEST WATTLEBOROUGH

Lloyd's Register

Foundation

4PL388-0146

J.V.L.
20/2/00

Furness withy Co.

No. 246.

Filling in between poop
and bridge.

246 "Freiburg"

Hpl. Report No. 11140

248 "Marburg"

Hpl. Report No. 11185

HIPL388-0146

No 246

No 246



© 2020

Lloyd's Register
Foundation