





Furness Witby & Co  
H. No 248

duplicate of No 246

Mid Section



No 246 "Freiburg"

Hpl. Report No. 11140

No 248 "Marburg"

Hpl. Report No.

HR 388-014

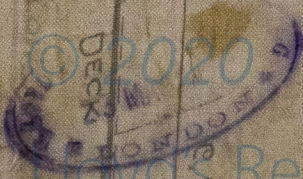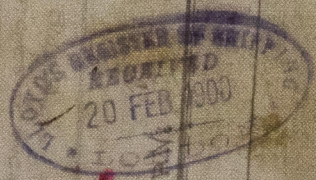

Lloyd's Register  
Foundation

QUADRUPLE OVERHEADS  
DOUBLED AT END OF 1800  
INCREASED 50 FOR 3/4 LENGTH

R 44 x 50  
12-11

DOUBLE

2 1/2

DOUBLE

1/2 RAILS

5 1/2 TIMES DEPTH OF BEAM

WHEELS 13-11

INSERT AT ENDS

WHEELS FOR 1/2 LENGTH  
OVERHEAD BUILT QUADRUPLE

UPPER DECK

2. DIT  
FOR 3/4 LENGTH  
QUADRUPLE BUILT

C 2 1/2 x 50  
12-11

1/2 RAILS  
5 1/2 TIMES DEPTH OF BEAM  
WHEELS 13-11

FOR 3/4 LENGTH  
QUADRUPLE BUILT