


7.6.99
21.6.99
20.2.00

See amended plan
with alteration in size
of hatchways

PROFILE

SCALE $\frac{1}{8}$ INCH = 1 FOOT

DIMENSIONS 400-0 x 52-0 x 32-1 $\frac{1}{2}$ DM.

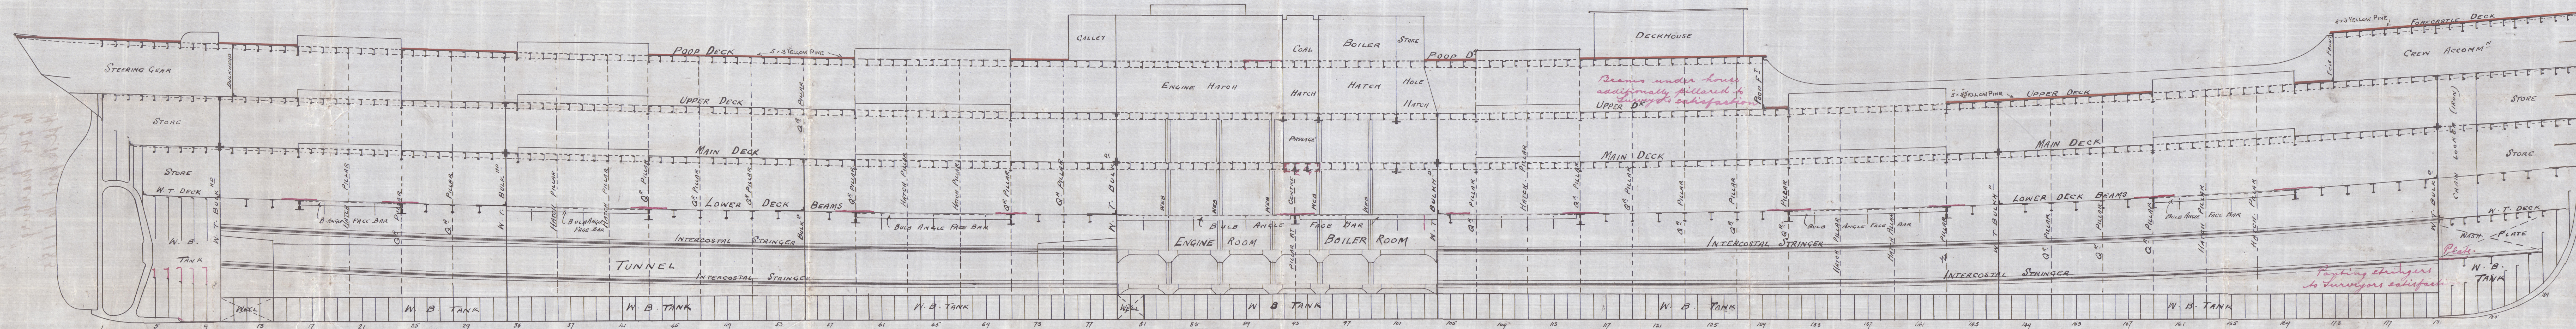

N^o 248 — & 246.

C.B.
7.6.99

FURNESS, WITTH & CO. LIMITED
SHIPBUILDERS & REPAIRERS
WEST HARTLEPOOL
June 27/99
Lloyd's Register
Foundation

Furness Withy & Co

No 246.

" No 248.

Amended profile

No. 246 "Freiburg"

Hpl Report No. 11140

No. 248 "Marburg"

Hpl Report No. 11185

HPL 388-0150



— No 248 — 2540.



© 2020

Lloyd's Register
Foundation