

Furness Mitty & Co.
At no 247


Chem frame.

"Poliviana"

Hpl. Report

No. 11227

HPL889-0101

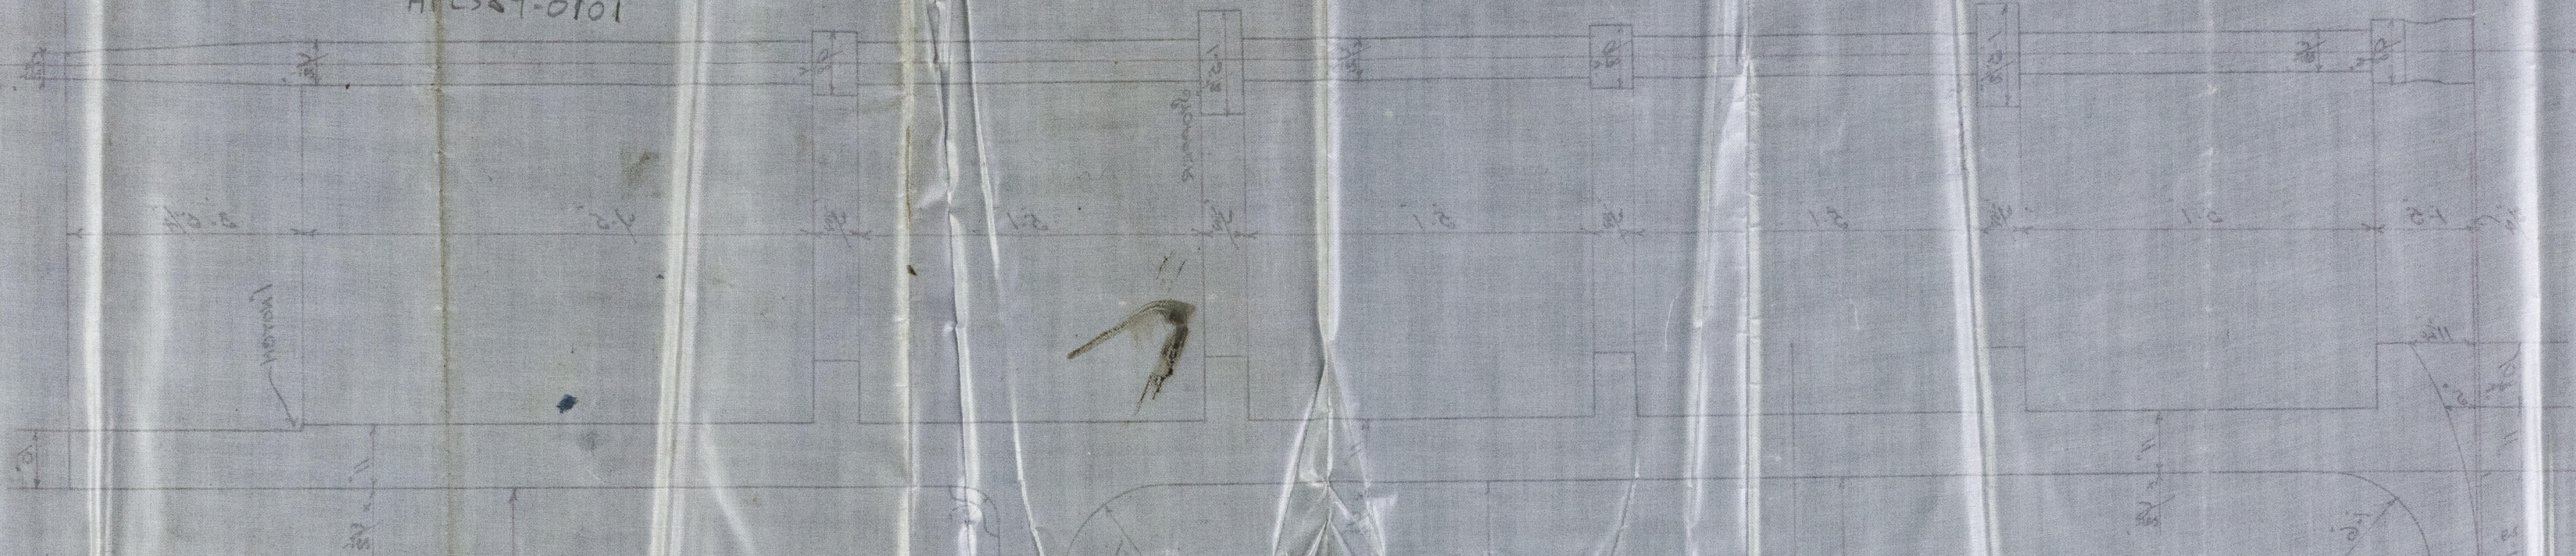

No. 547





20.11.2019




© 2019

Lloyd's Register
Foundation

2. 2. 99

SCALE $\frac{1}{2}$ " = 1 FOOT.

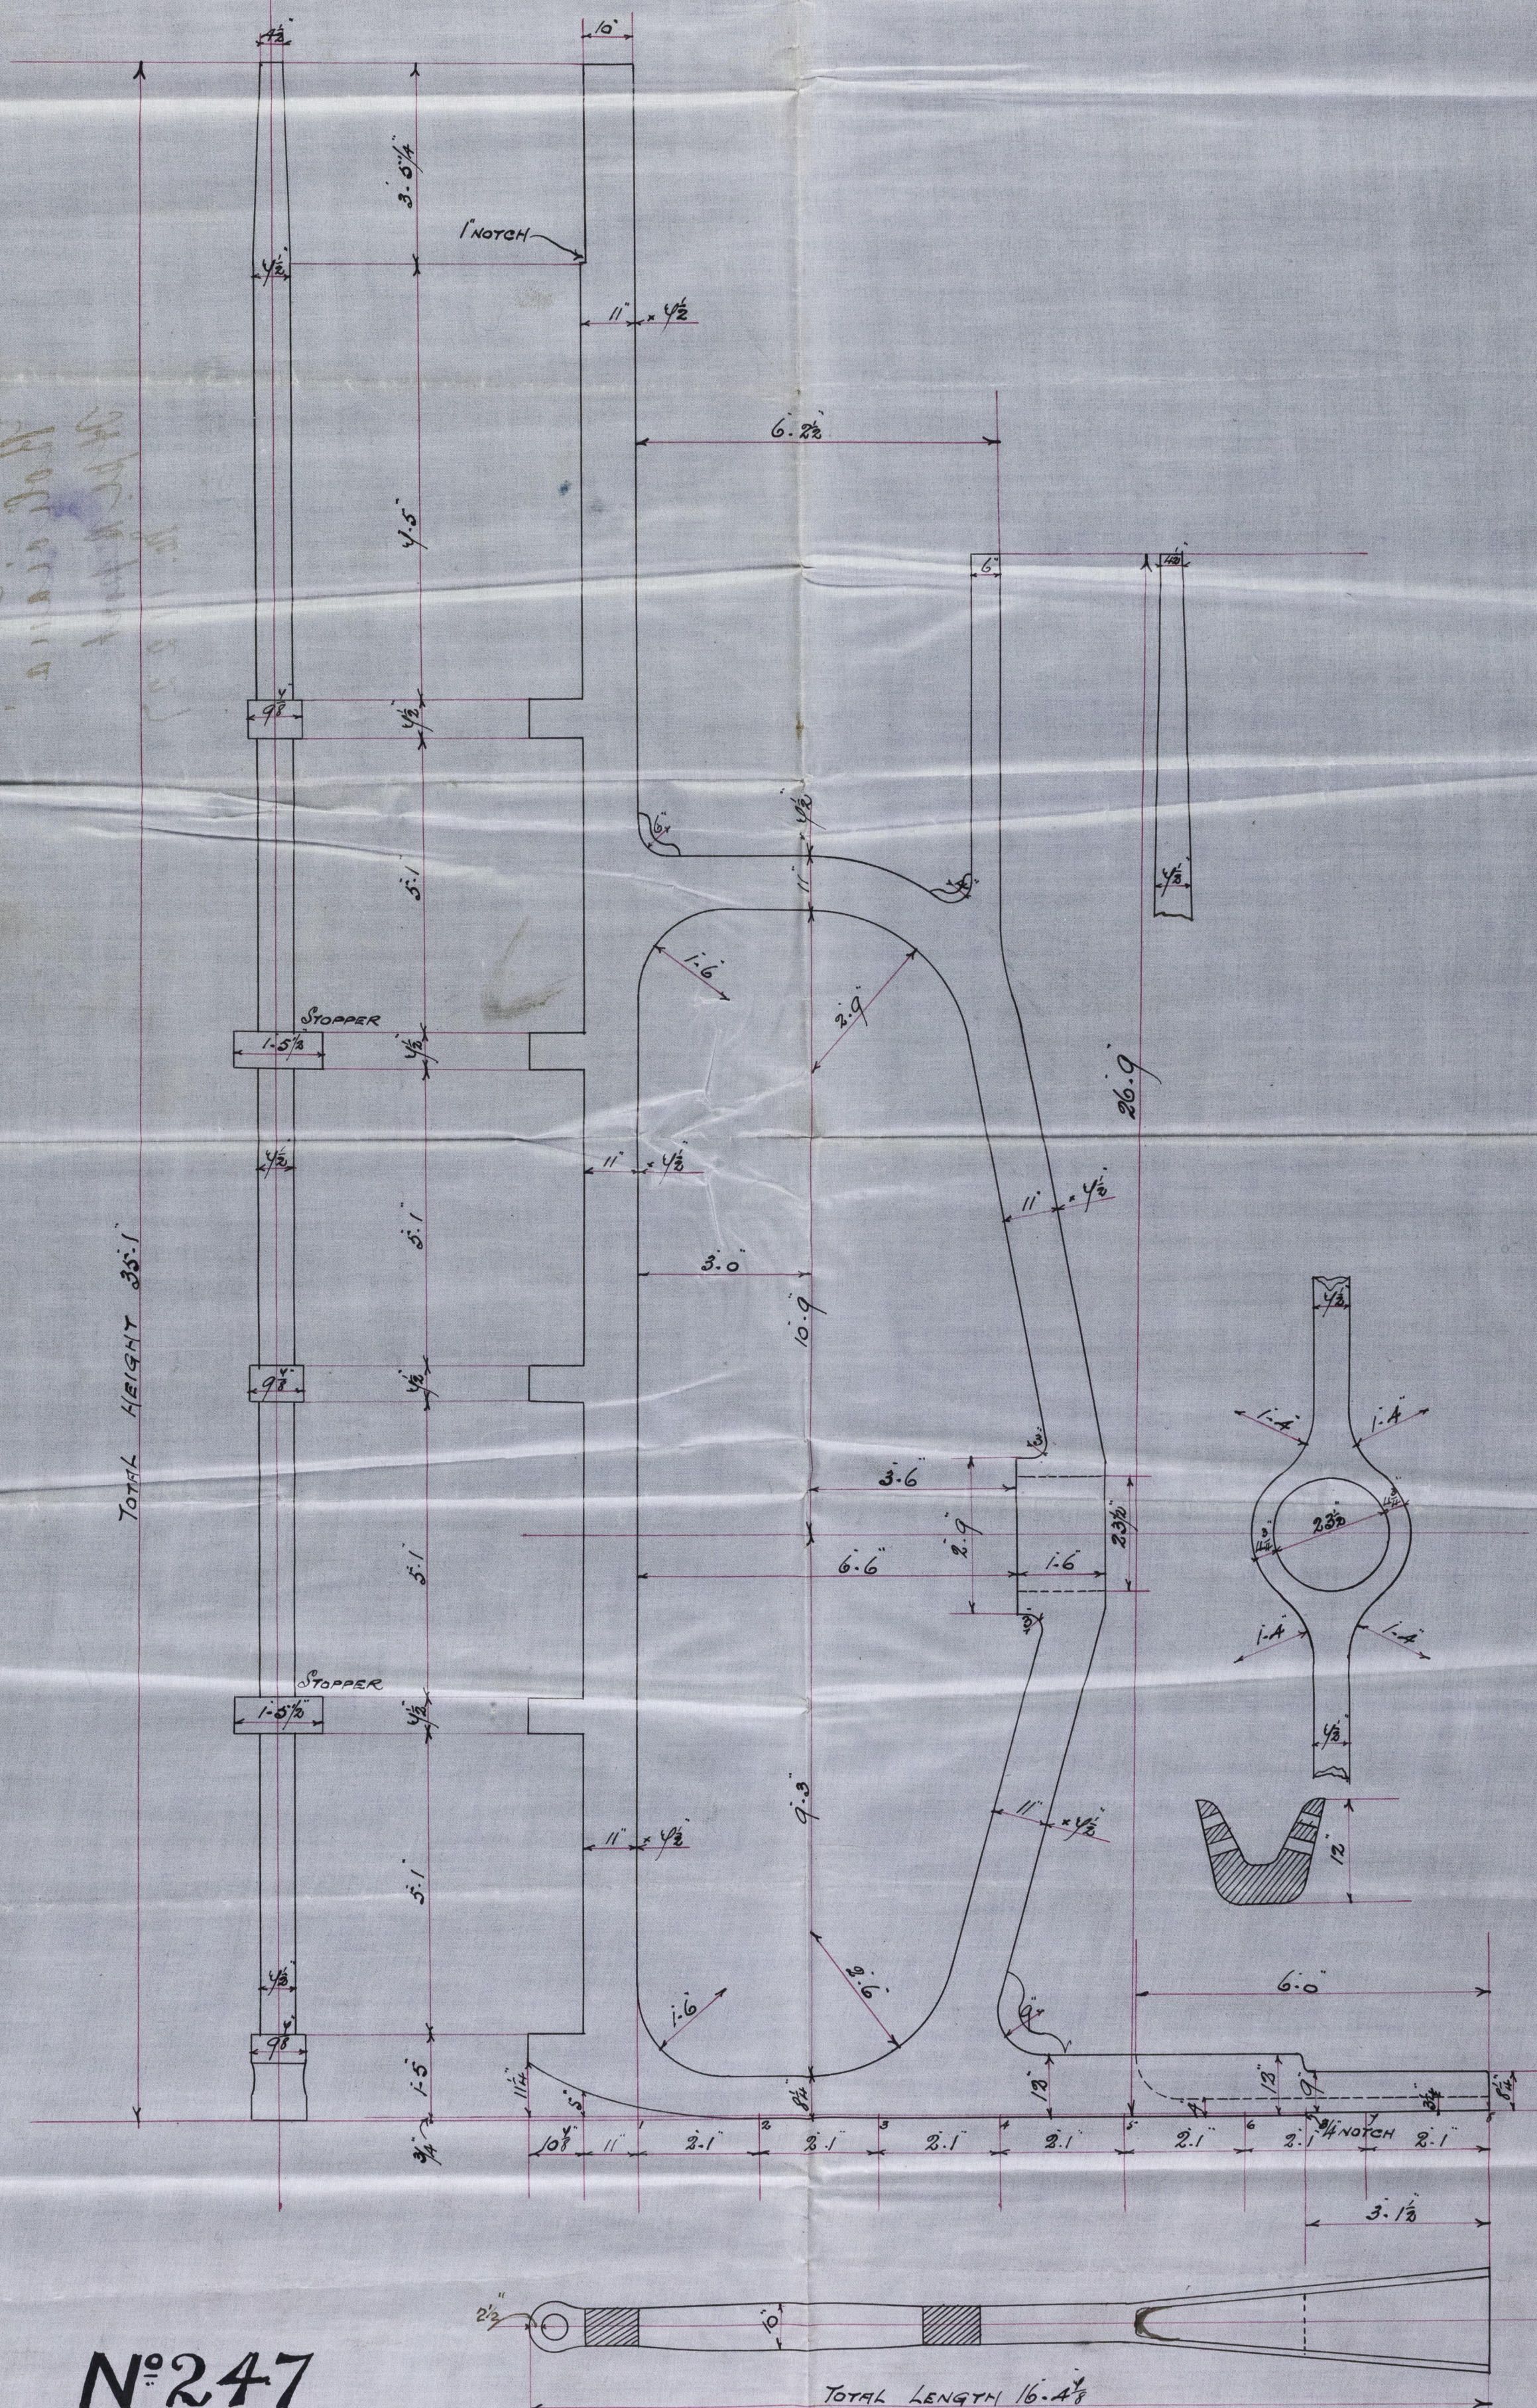

Nº 247

TOTAL LENGTH $16.4\frac{1}{8}$

FURNESS, WITBY & CO. LIMITED

SHIPBUILDERS & REPAIRERS

WEST HARTLEPOOL

Jan 24th/99 V.J.

LLOYD'S REGISTER OF
West Harlepool
0913
SHIPPING

30.1.99

HP 6389-0101