


HPL389-0106

NOV 9 1960
TALL TOWER
NOV 9 1960
TALL TOWER

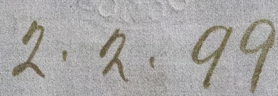


SCALE $\frac{1}{2}$ " = ONE FOOT

RIVET HOLES TO BE DRILLED BY MAKERS

" " WILL BE MARKED BY SHIPBUILDERS

LOWER PART CAST STEEL
UPPER PART WROUGHT IRON

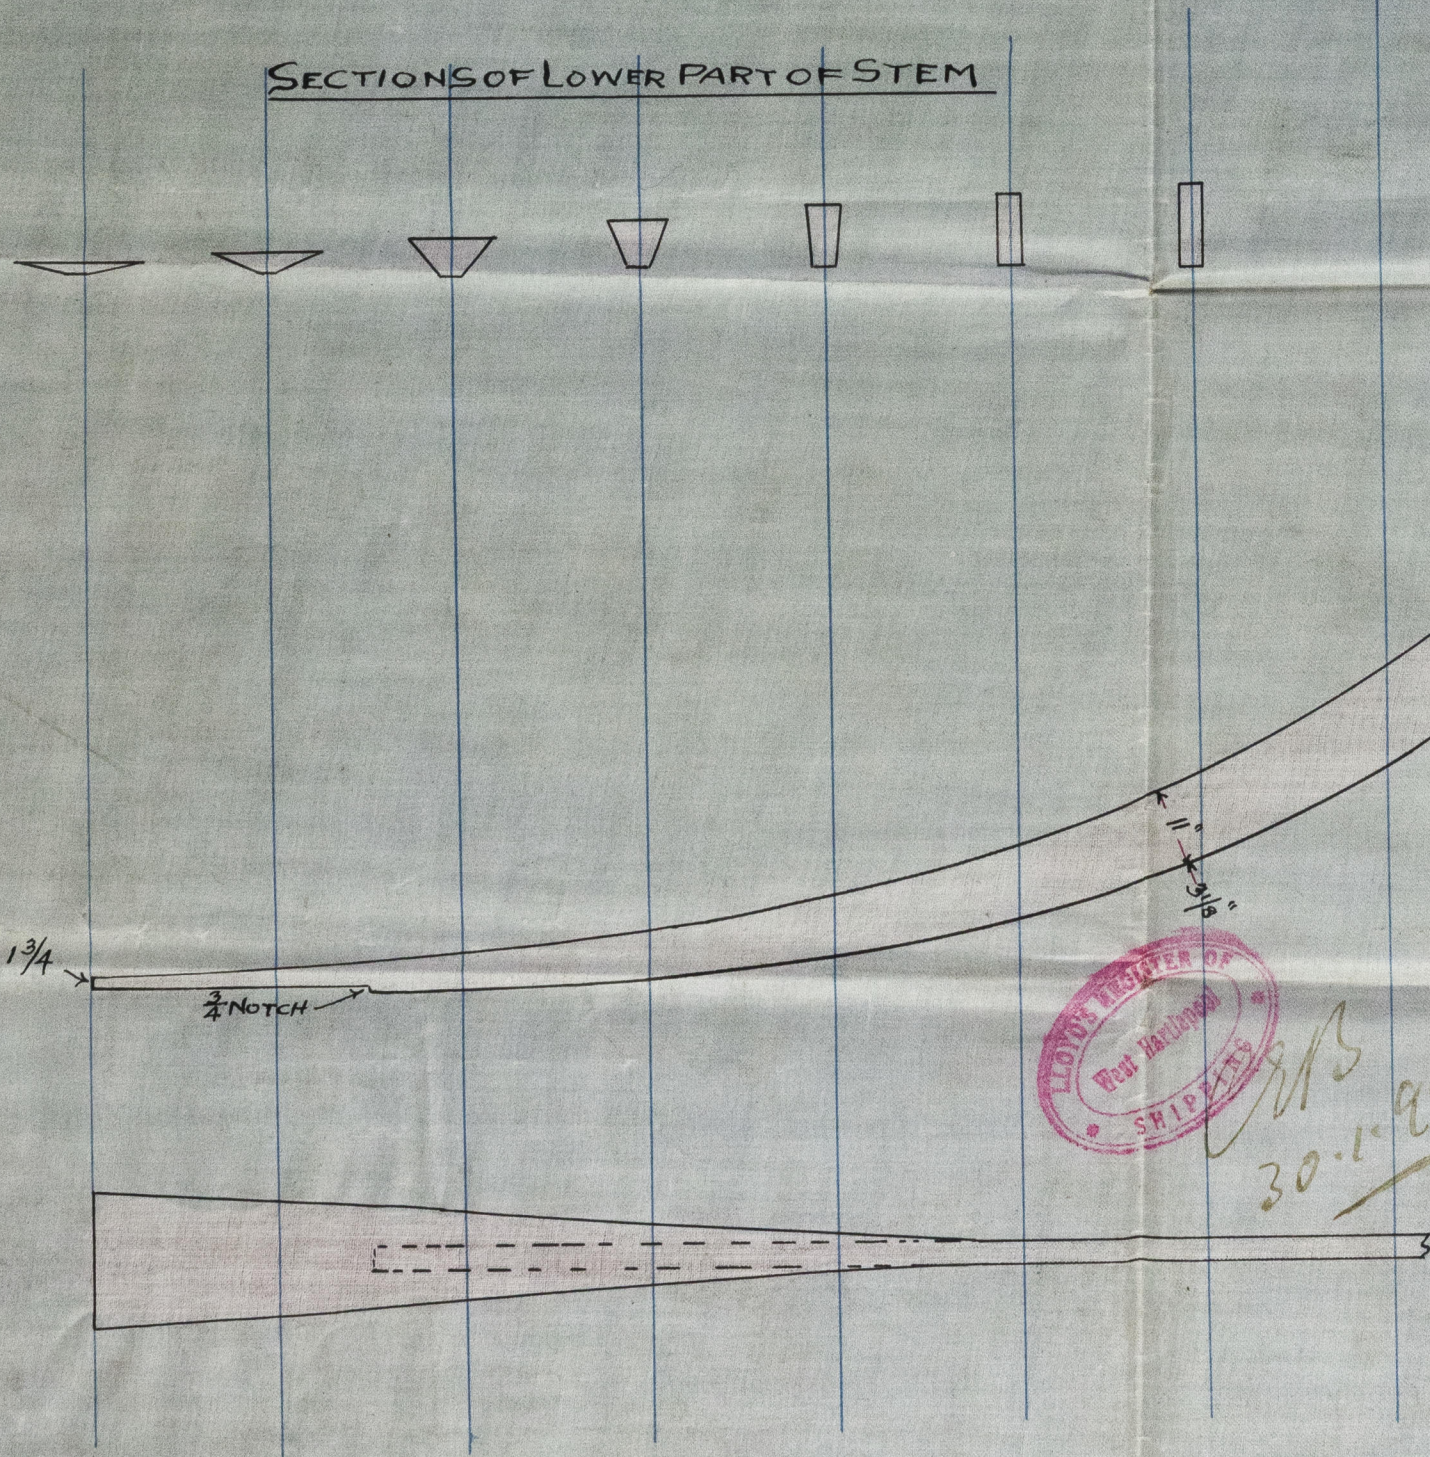

FURNESS, WITHEY & CO., LIMITED
SHIPBUILDERS & REPAIRERS
WEST HARTLEPOOL

WEST HARTLEPOOL.

Jan 27th /99 J. J.

© 2019

Lloyd's Register
Foundation

HPL 389-0106