


25.1.99  
2.2.99

# PROFILE

SCALE  $\frac{1}{8}$ " = 1 FOOT

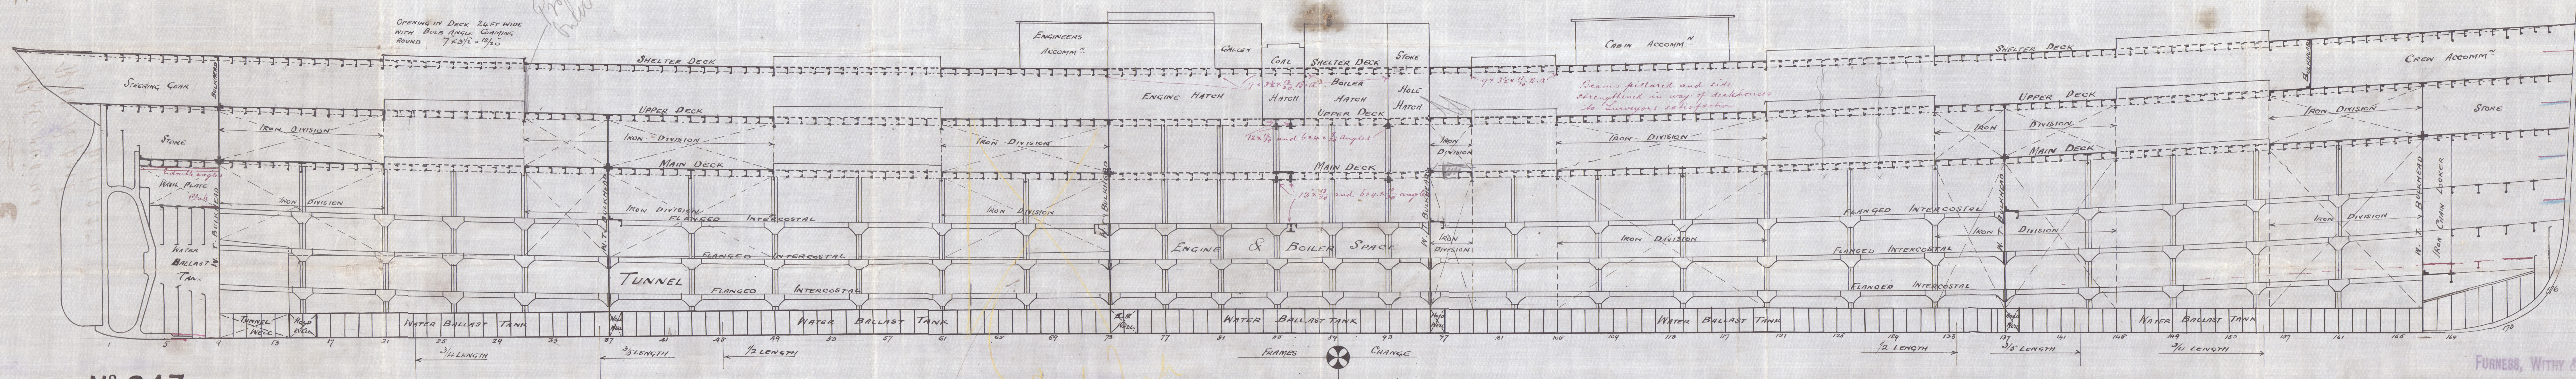

Nº 247

Deep Tank fitted  
10.12.20

J.H.  
25/1/99

FURNESS, WITBY & CO. LIMITED

SHIPBUILDERS & REPAIRERS

WEST HARTLEPOOL

Jan 18<sup>th</sup> 1999

Lloyd's Register Foundation

HPL 389-0108



Furness, Witley & Co  
Linn

P.S. No 247  
Profile

Boliviana

Hpl Report  
No. 11227

HPL 389-0108

No 547



© 2020  
Lloyd's Register  
Foundation