

For the information of Surveyors and the Committee only.

Received at **WEST HARTLEPOOL** Office.

9. 2. 1900

Lloyd's Register of British and Foreign Shipping.

(Report on Vessel No. 11242 Port WEST HARTLEPOOL.)

No Pool

No. 4120a

SHIP FORGINGS OR CASTINGS.

Woodbridge

I have to report that the undermentioned Iron or Steel Forgings or Castings,

manufactured by W. Thos May

of Pallion

for the Vessel No. 113, being built

by The Iron Works

of West Hartlepool

have been inspected by me as set forth below, and found to be, so far as can be seen,

sound

Mark on Forgings.

Lloyd's

No. 4120a


No. to

Wm Cameron


Sunderland
8/2/00

	STERN FRAME.	RUDDER FRAME.	STEM.
Material*	<u>Scrap</u>		
How made	<u>Forged</u>		
Dimensions	<u>11 x 6 3/4</u>		
Progress on Inspection	<u>Forged & milled</u>		<u>Not seen</u>
Date when Inspected	<u>Sept 2nd to Nov 14/99</u>		

SKETCHES OF FRAMES SHOWING POSITION AND DESCRIPTION OF WELDS OF FORGINGS, OR PARTICULARS OF TESTS APPLIED TO CASTINGS.

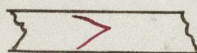

Welds

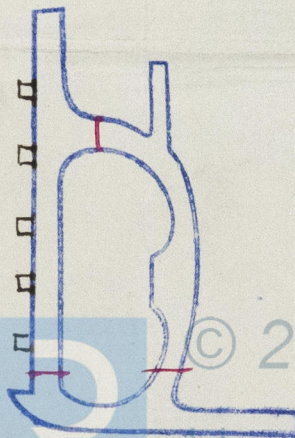

Fee (if any chargeable) £

To be paid at